


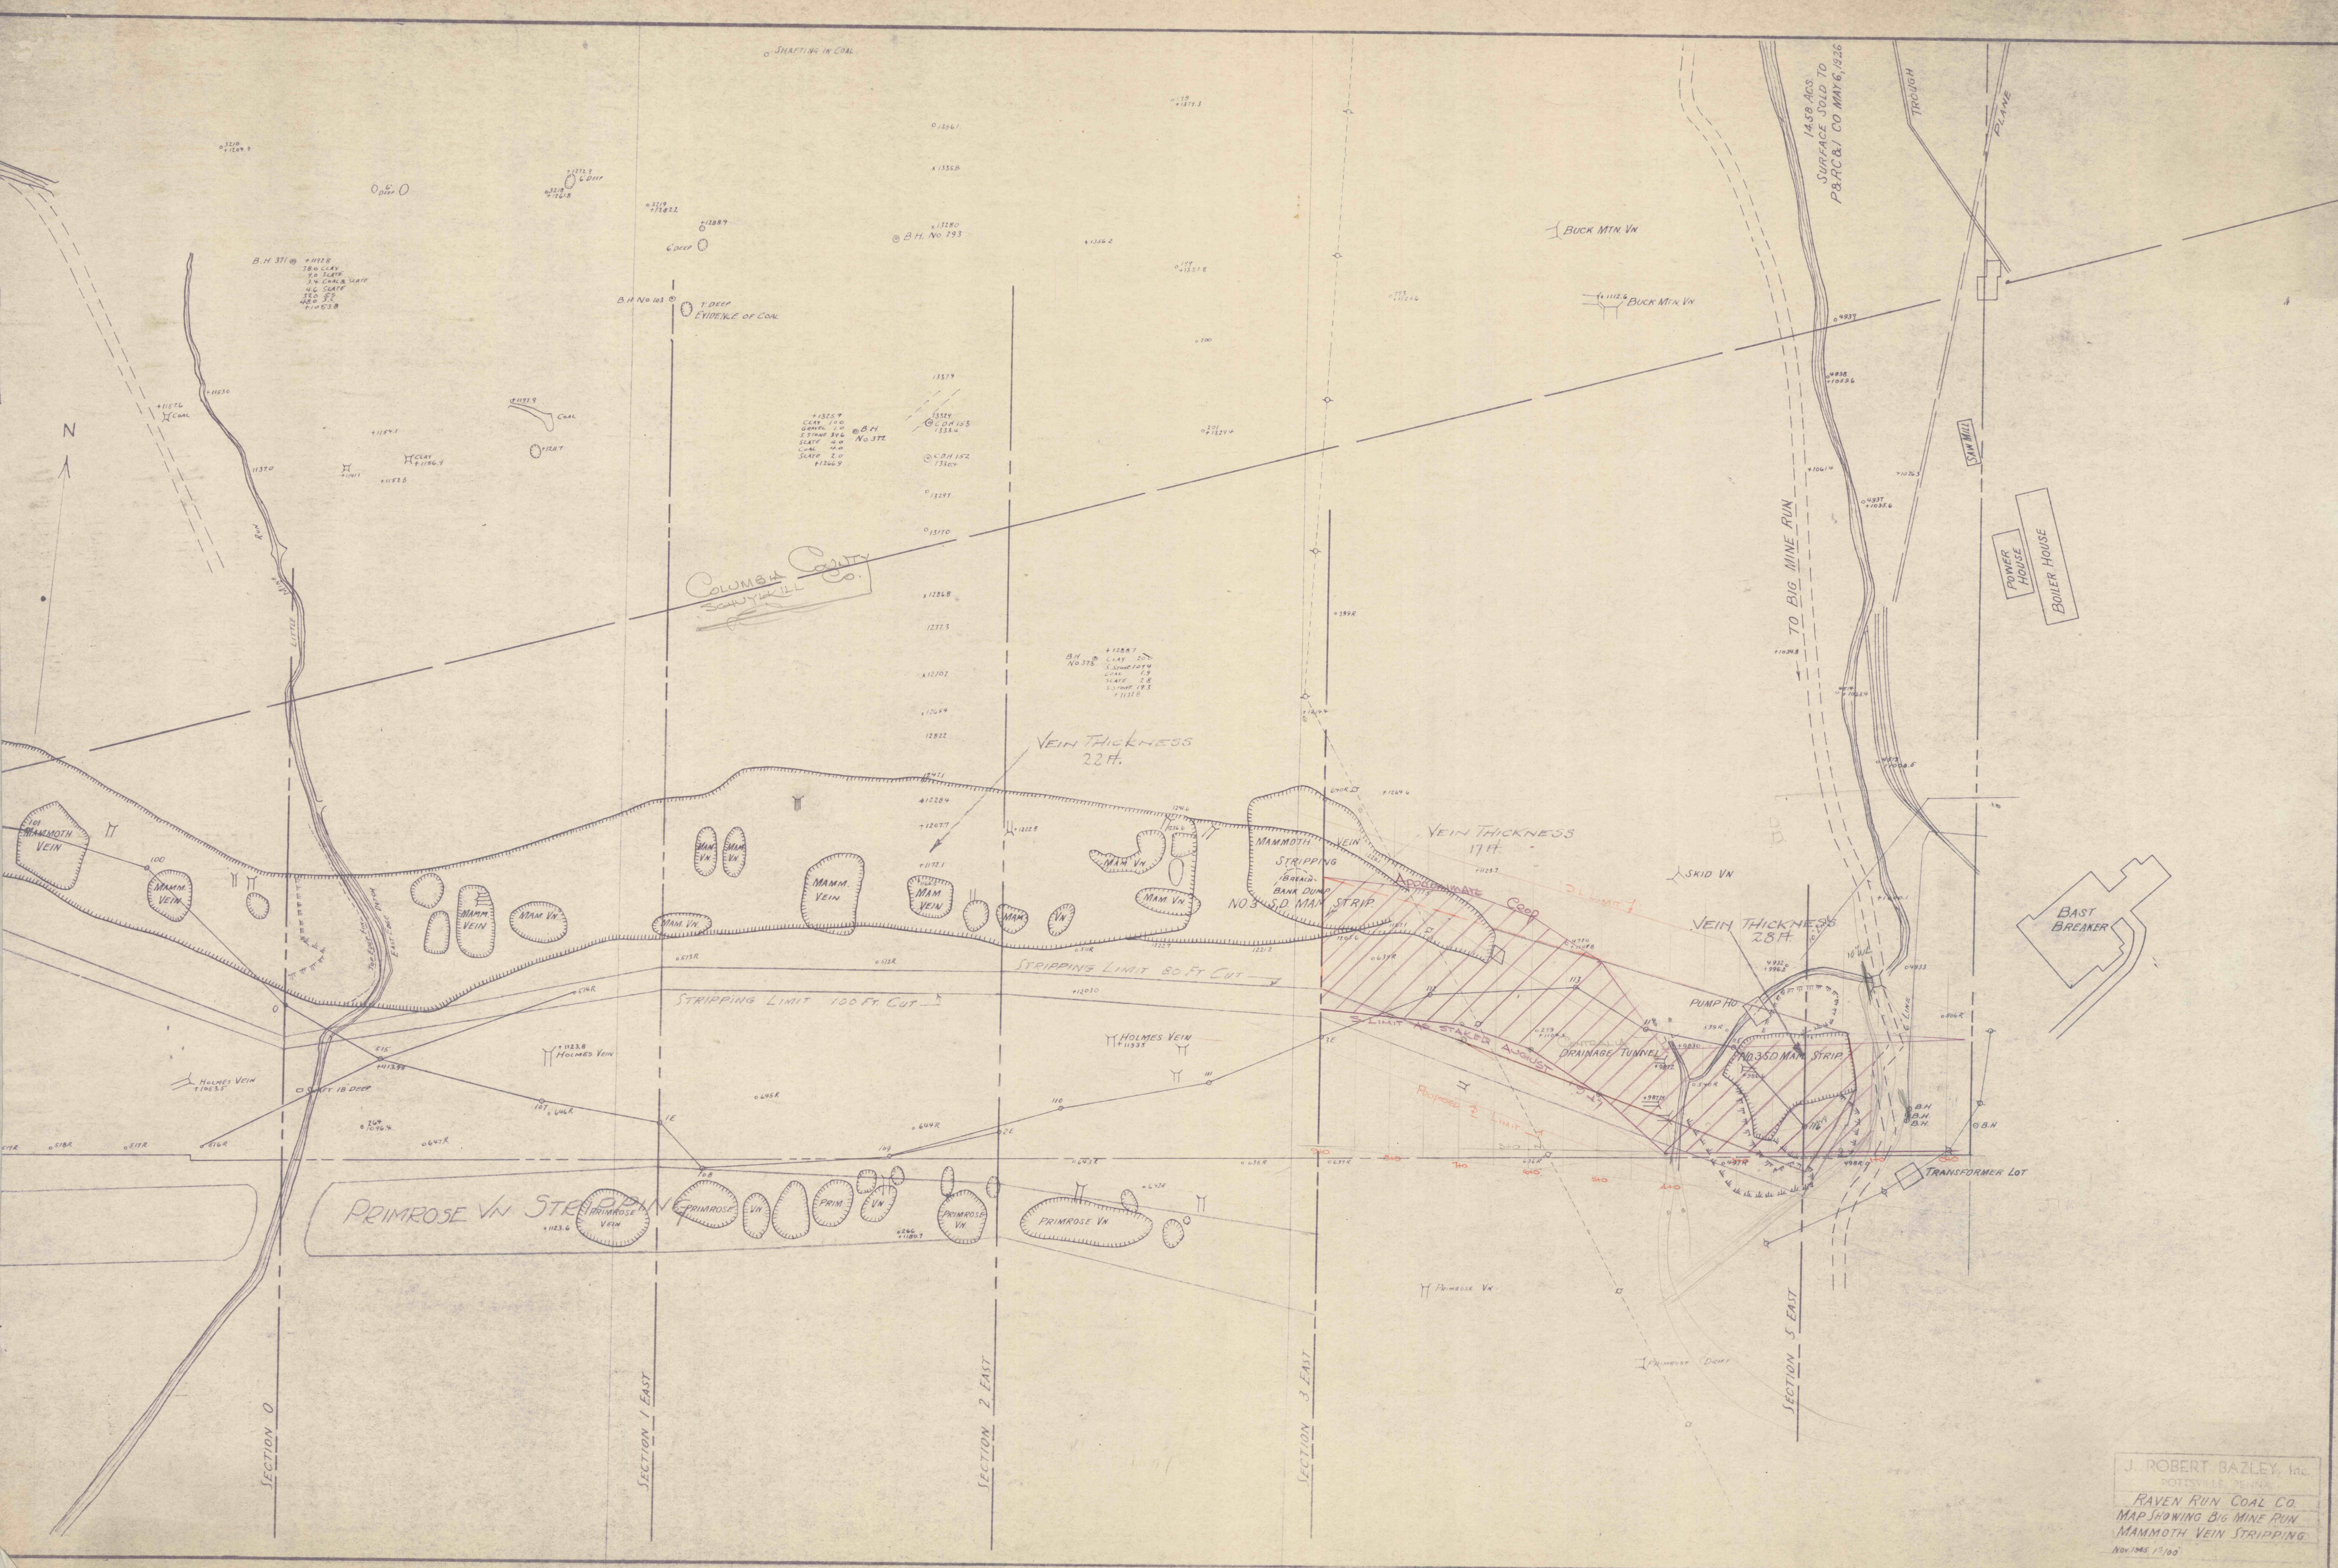

J. ROBERT BAZLEY, Inc.
POTTSVILLE, PENNA.
RAVEN RUN COAL CO.
MAP SHOWING BIG MINE RUN
MAMMOTH VEIN STRIPPING
NOV. 1945 17/100