


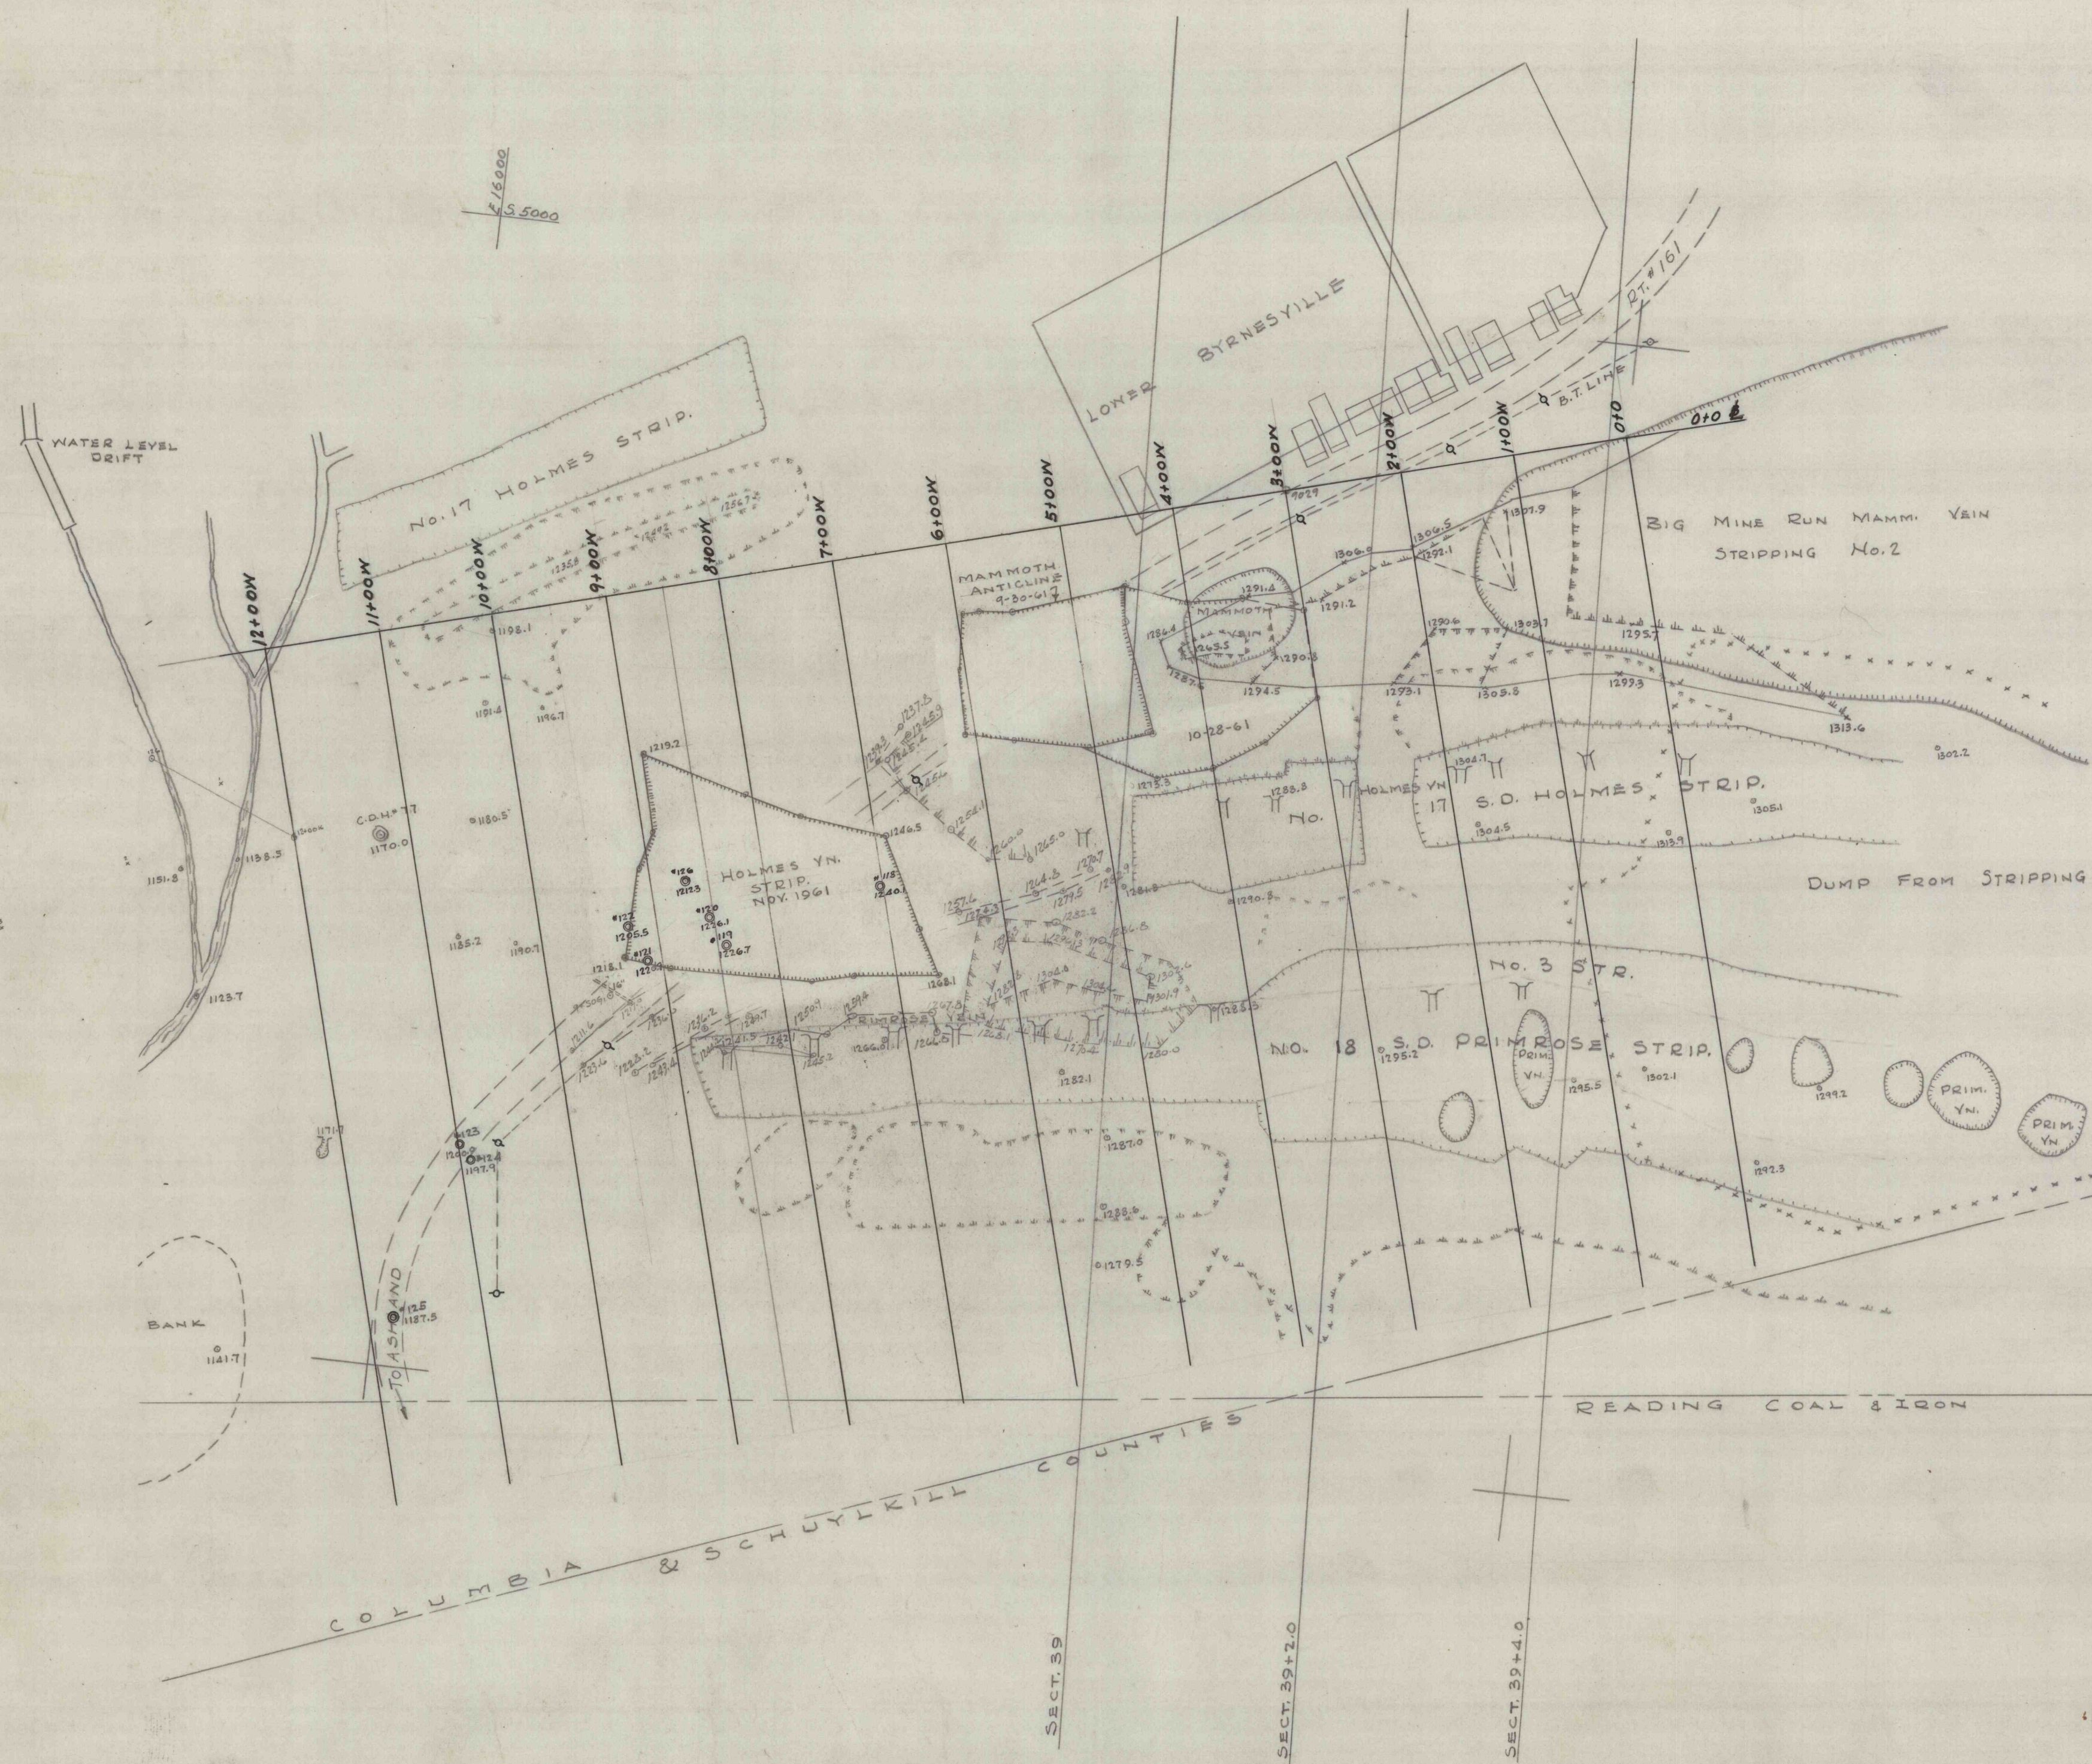

RAYEN RUN COAL CO.
GERMANTOWN SURFACE MAP
SCALE 1"=100'
9-29-61

5001-ME-JAI