


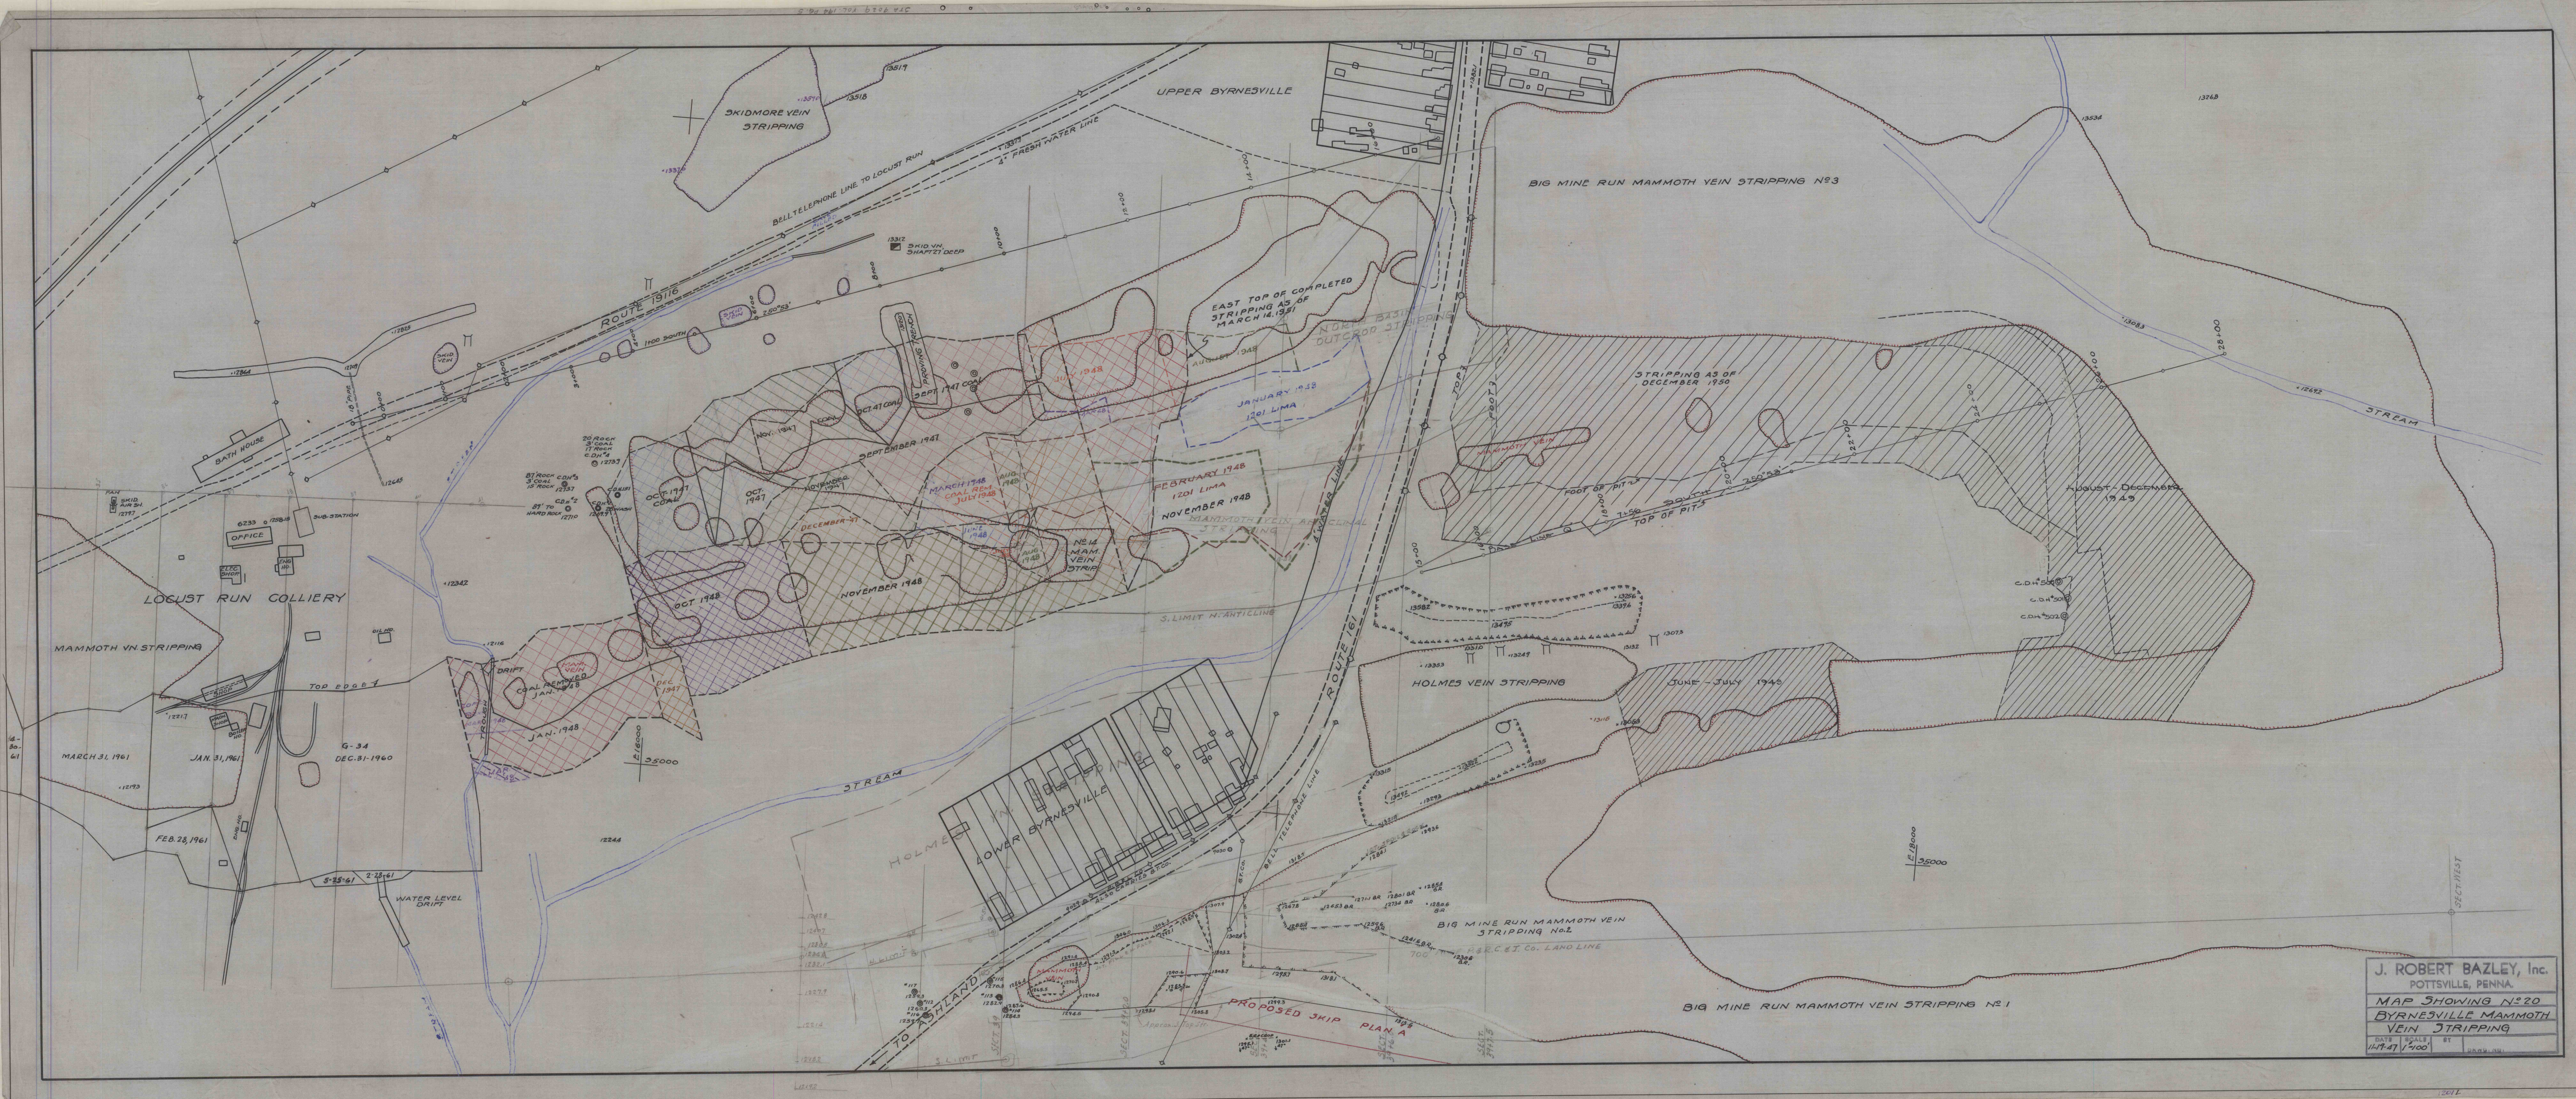

J. ROBERT BAZLEY, Inc.
POTTSVILLE, PENNA.
MAP SHOWING NO. 20
BYRNESVILLE MAMMOTH
VEIN STRIPPING
DATE 1/17/47 SCALE 1"=100'