


SOUTH BASIN-265' EAST OF "J"

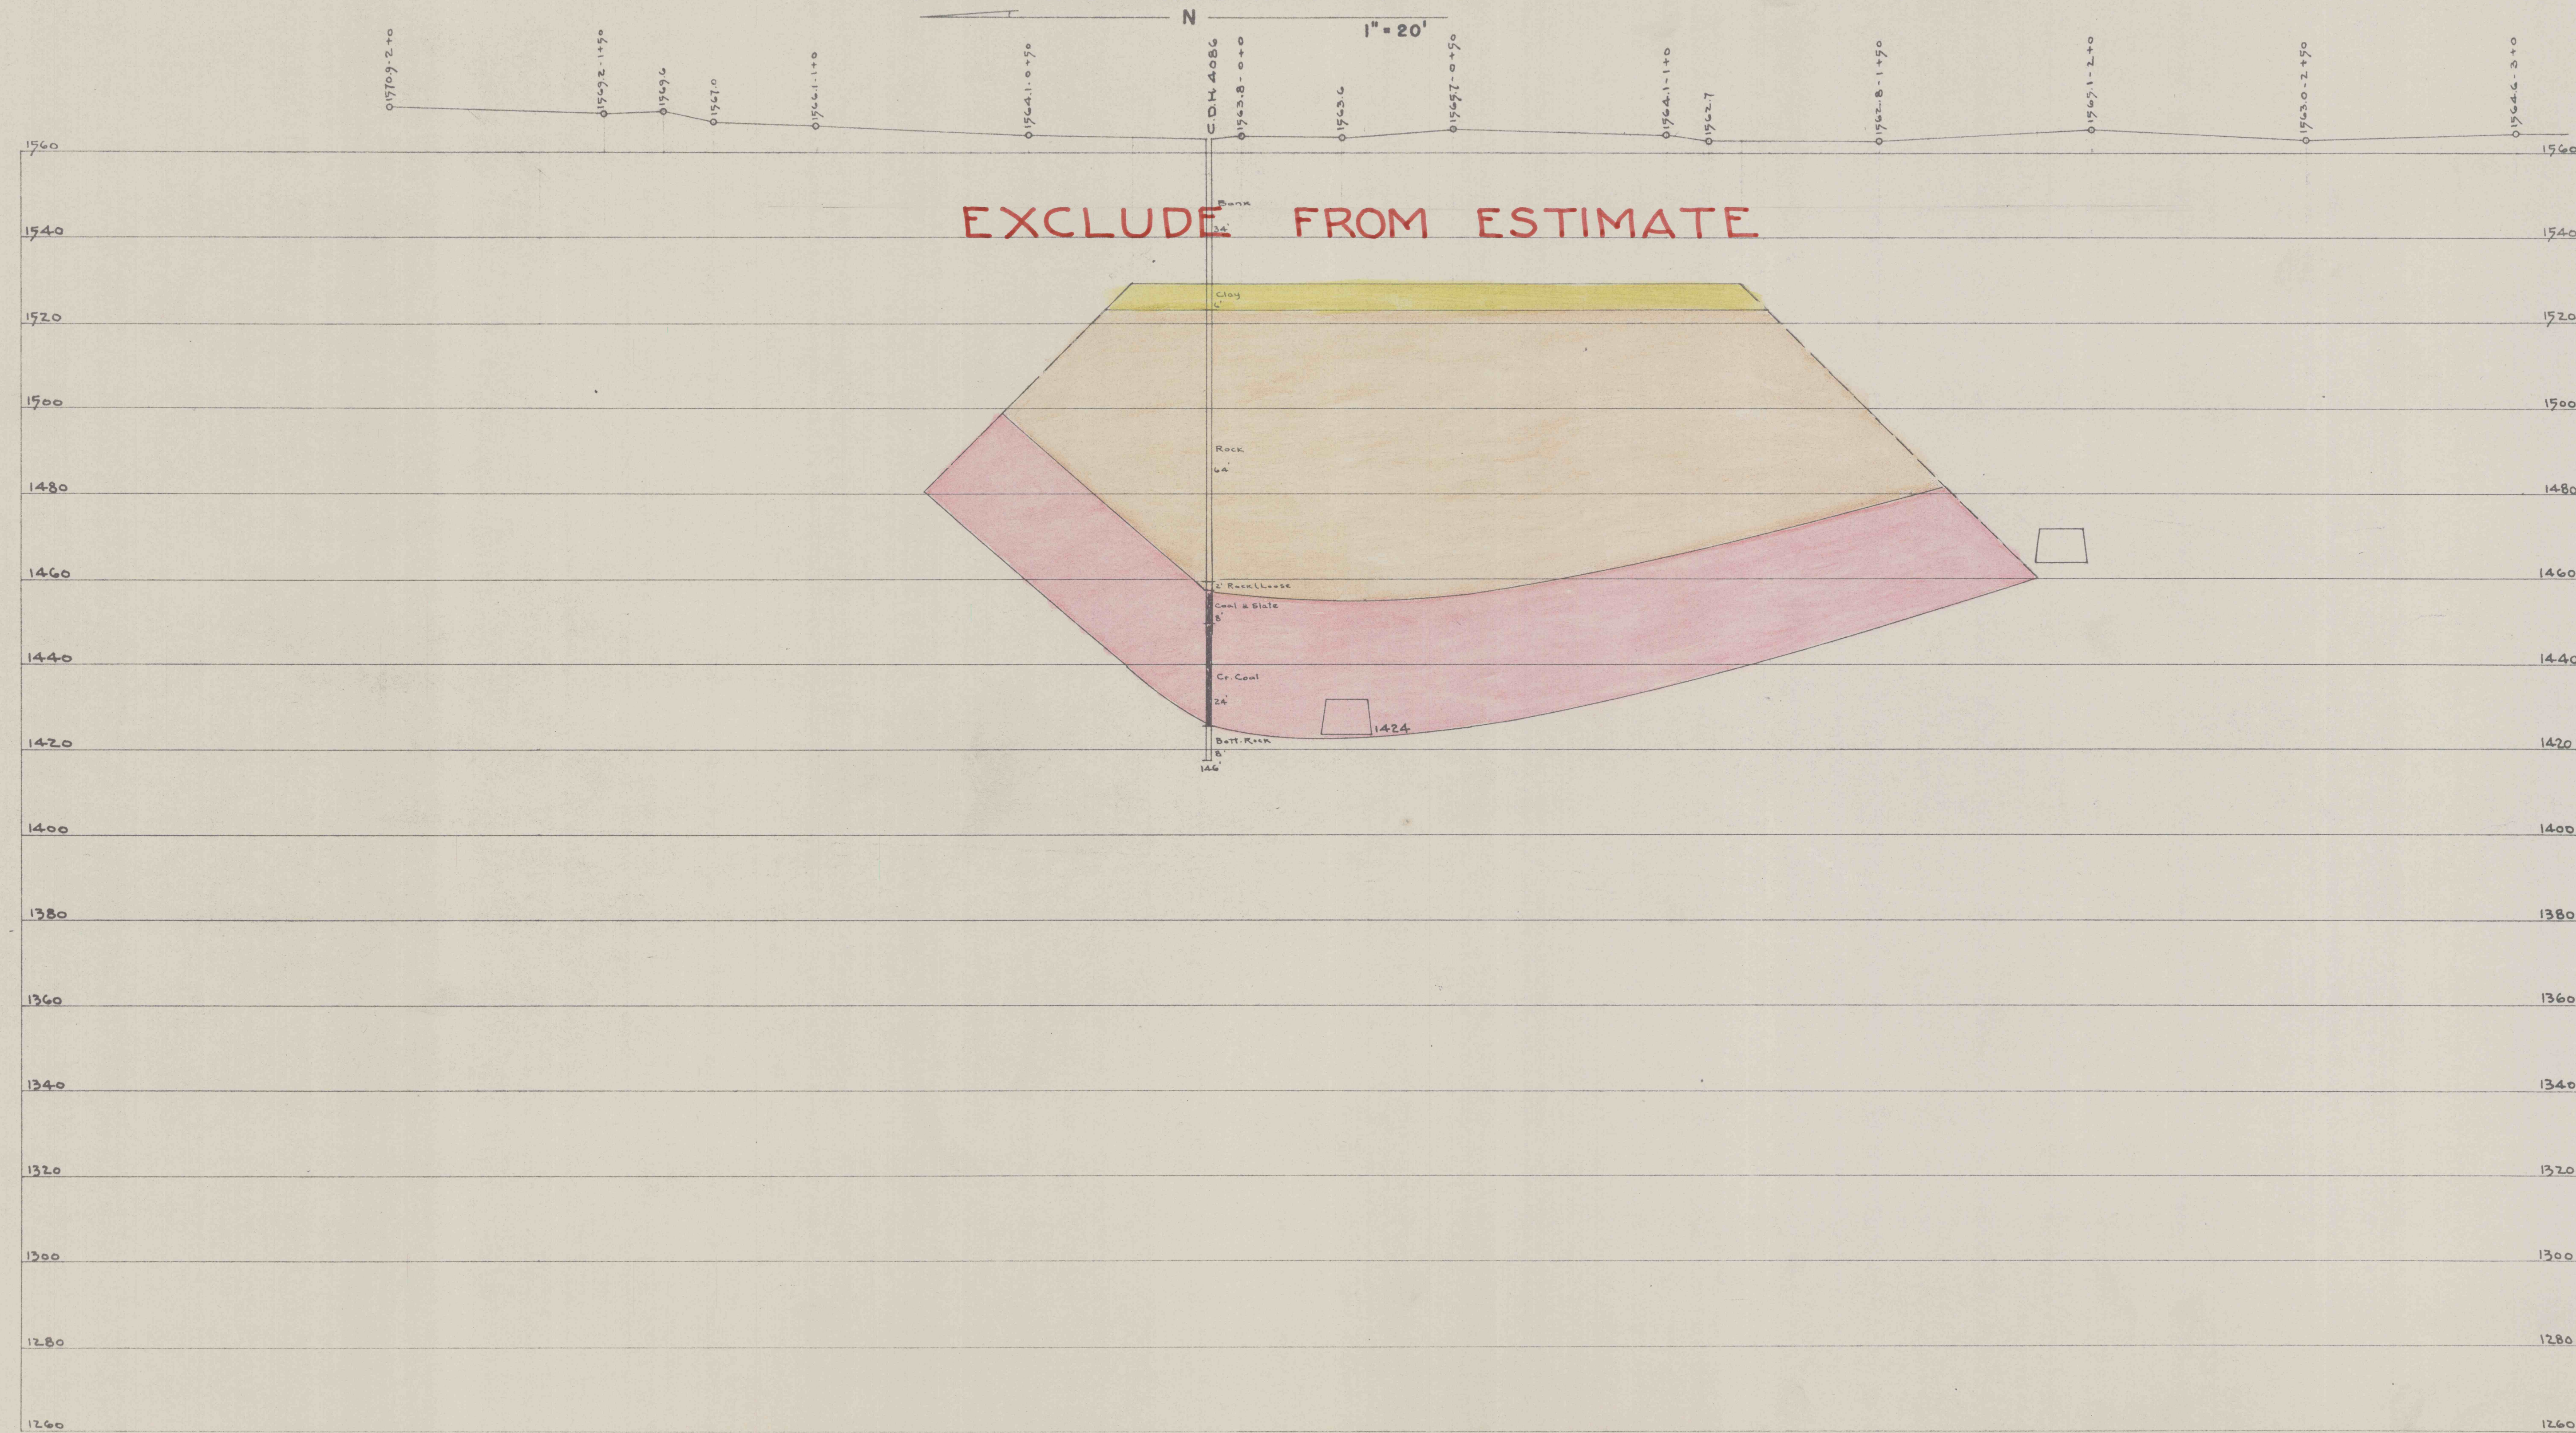

265'
East of
J