


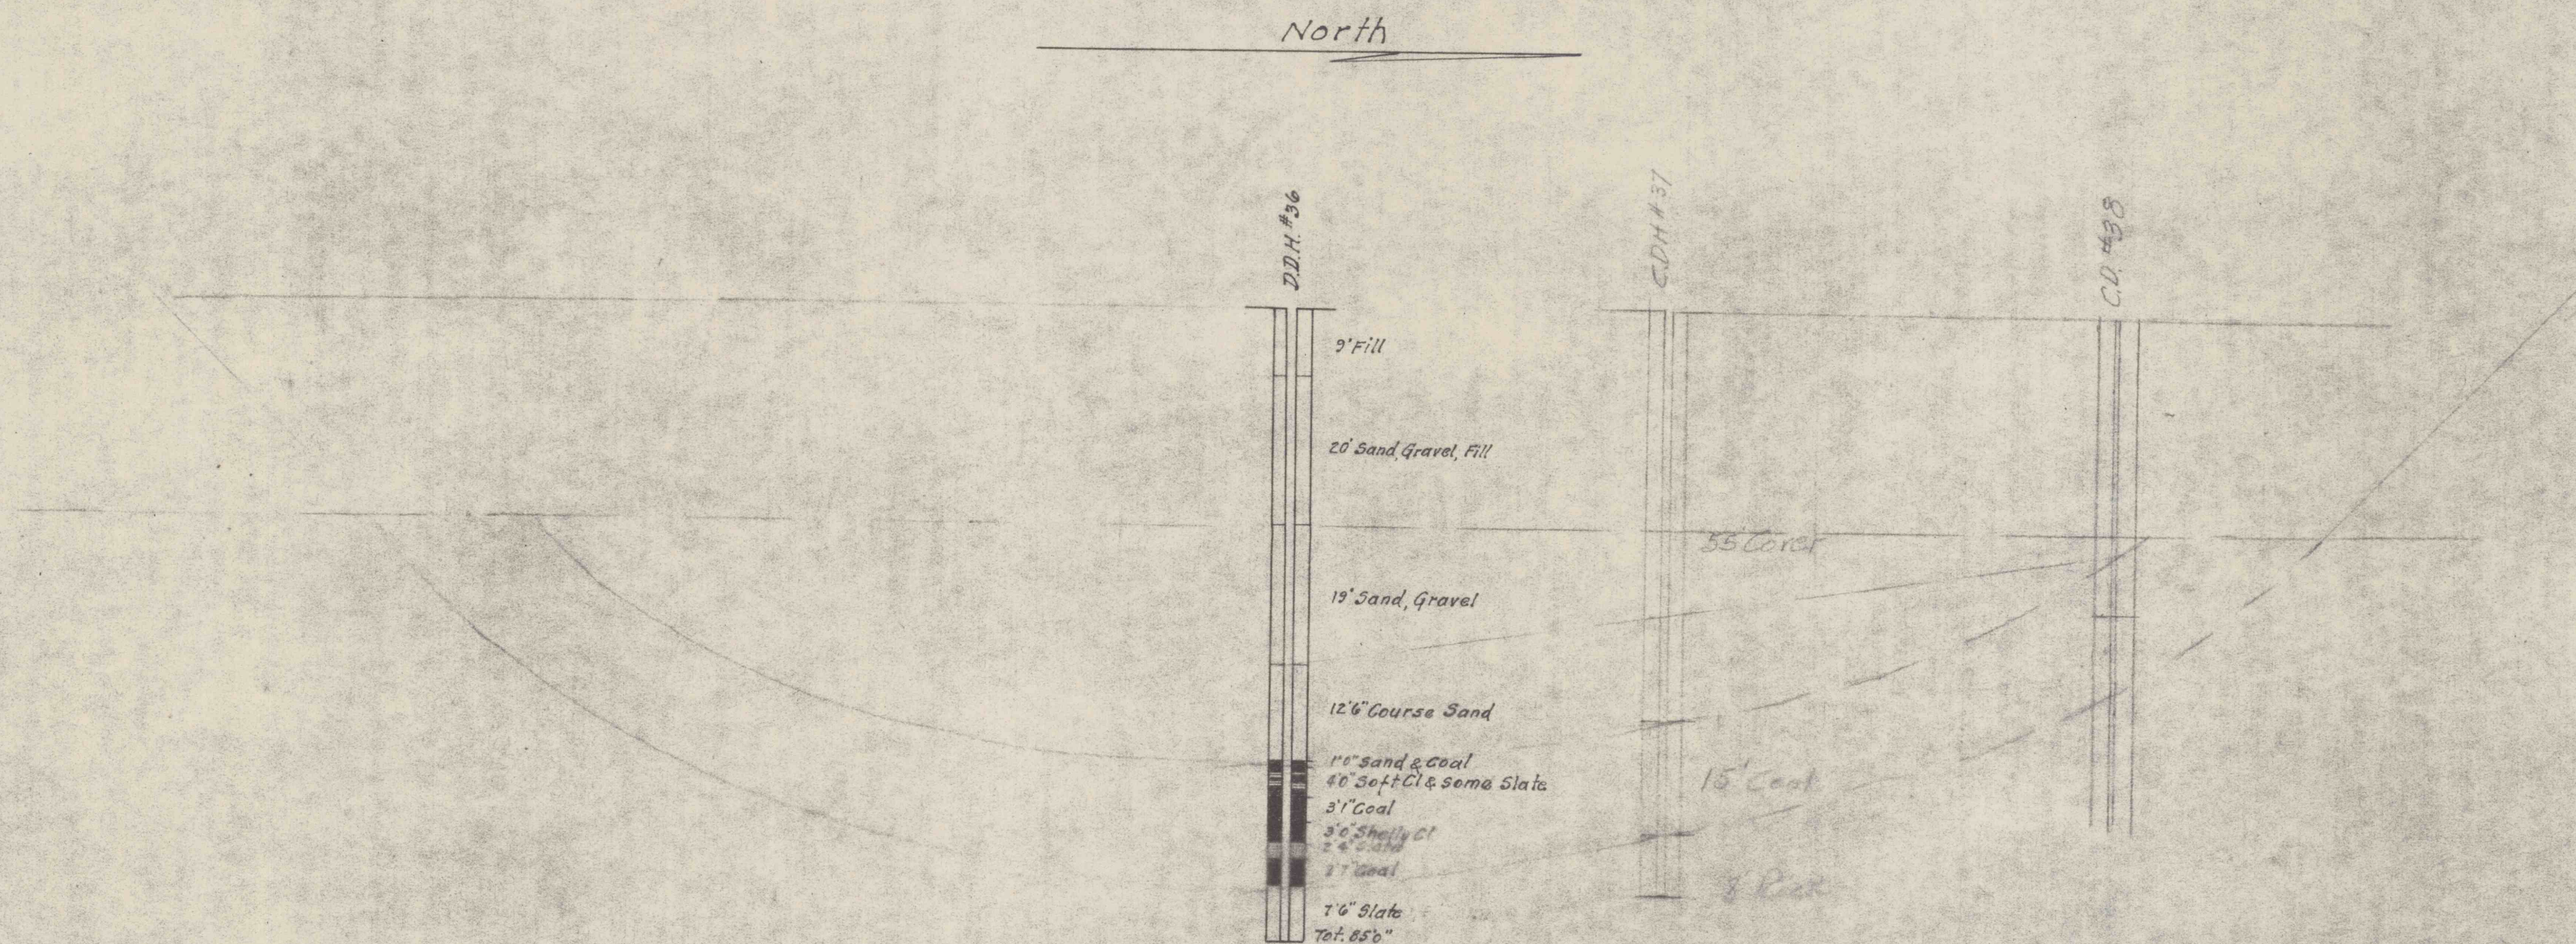

Dat. 1256'

CONTINENTAL SECTION OF RAVEN RUN COLLY.
 Plan & Sections of Primrose Provings
 Scale 1"=20' Jeddo, Pa. Oct. 13, 1941