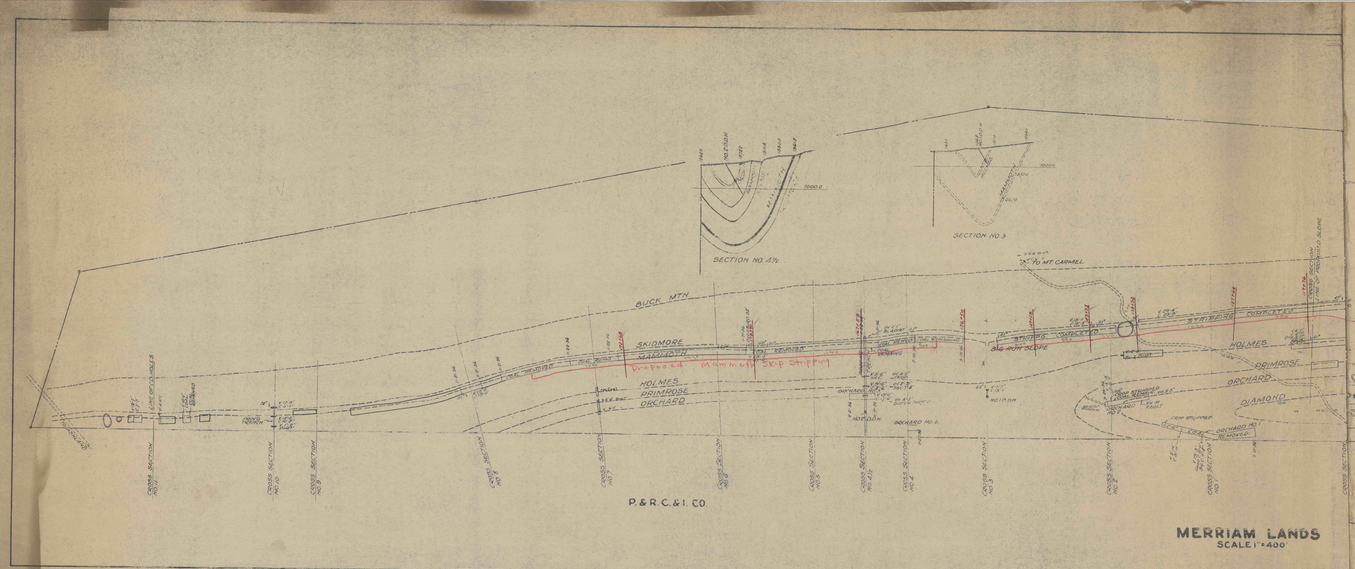

MERRIAM LANDS
SCALE 1" = 400'

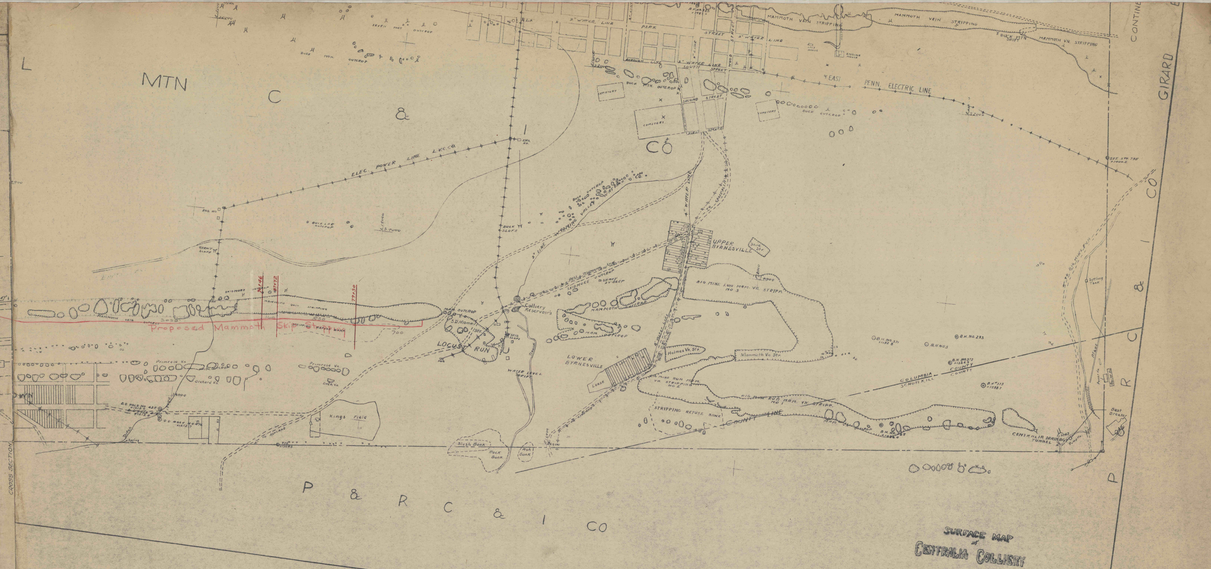

SURFACE MAP
OF
CENTRALIA COLLIERY