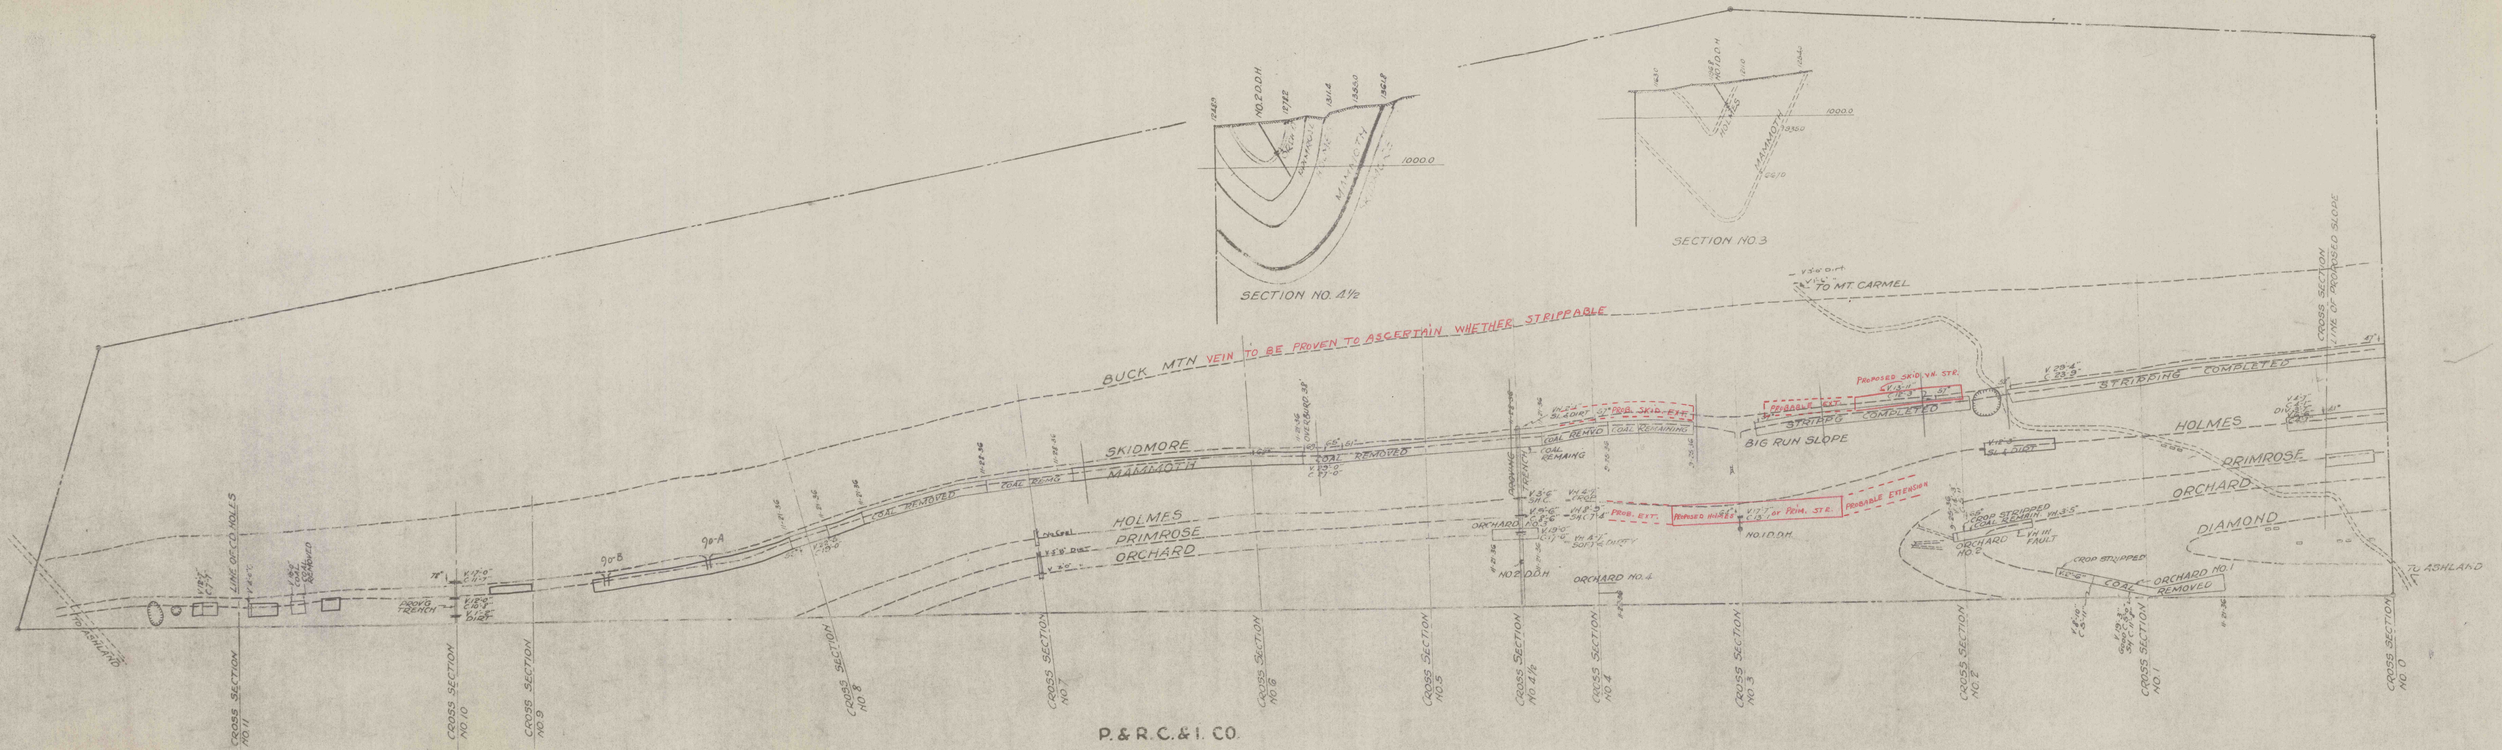
SECTION NO. 4½
SECTION NO. 3
BUCK MTN VEIN TO BE PROVEN TO ASCERTAIN WHETHER STRIPPABLE
TO MT CARMEL
TO ASHLAND
CROSS SECTION LINE OF PROPOSED SLOPE
STRIPPING COMPLETED
BIG RUN SLOPE
SKIDMORE
MAMMOTH
HOLMES
PRIMROSE
ORCHARD
DIAMOND
COAL REMOVED
COAL REMAINING
PROBABLE EXTENSION
PROPOSED SKID. VN. STR.
PROPOSED HOISE
CROP STRIPPED
ORCHARD NO. 1
ORCHARD NO. 4
ORCHARD VN. IN FAULT
CROSS SECTION NO. 11
CROSS SECTION NO. 10
CROSS SECTION NO. 9
CROSS SECTION NO. 8
CROSS SECTION NO. 7
CROSS SECTION NO. 6
CROSS SECTION NO. 5
CROSS SECTION NO. 4½
CROSS SECTION NO. 4
CROSS SECTION NO. 3
CROSS SECTION NO. 2
CROSS SECTION NO. 1
CROSS SECTION NO. 0
P. & R. C. & I. CO.
MERRIAM LANDS
SCALE 1" = 400'