


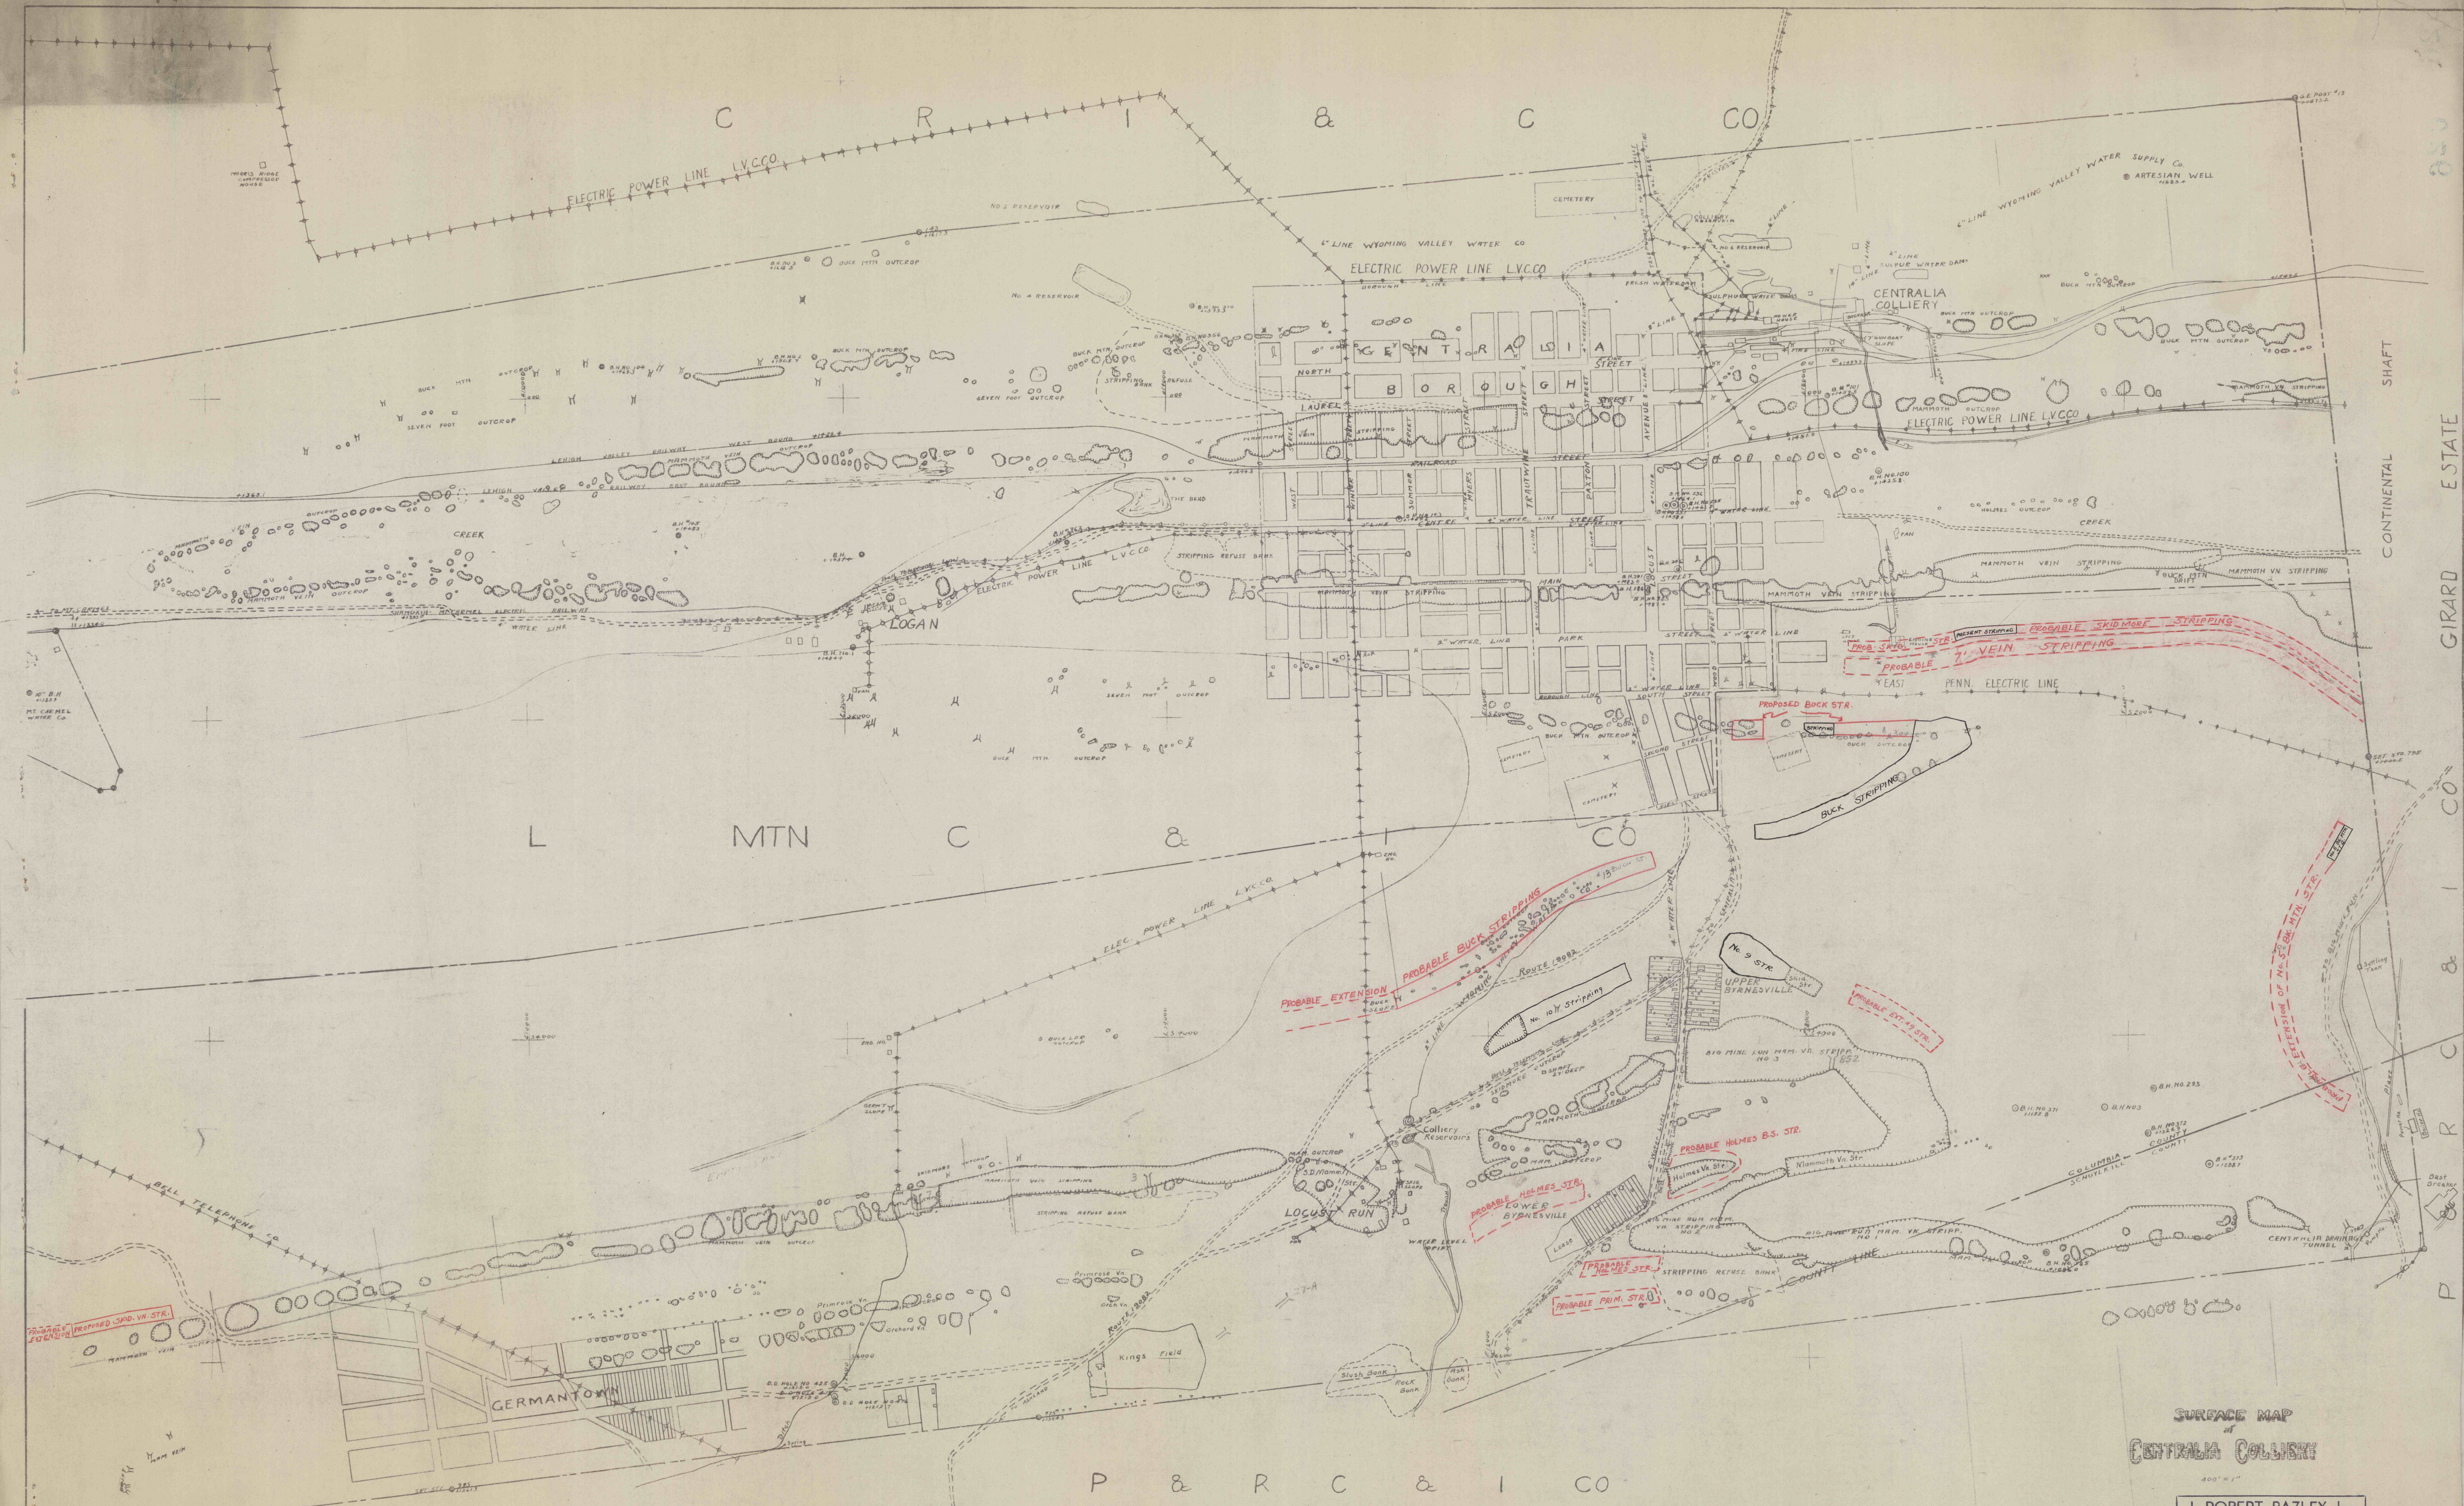

SURFACE MAP
of
CENTRALIA COLLIERY

400' = 1"
J. ROBERT BAZLEY, Inc.
POTTSVILLE, PENNA.
PROPOSED STRIPPING
RAVEN RUN COAL CO.
DATE SCALE BY