


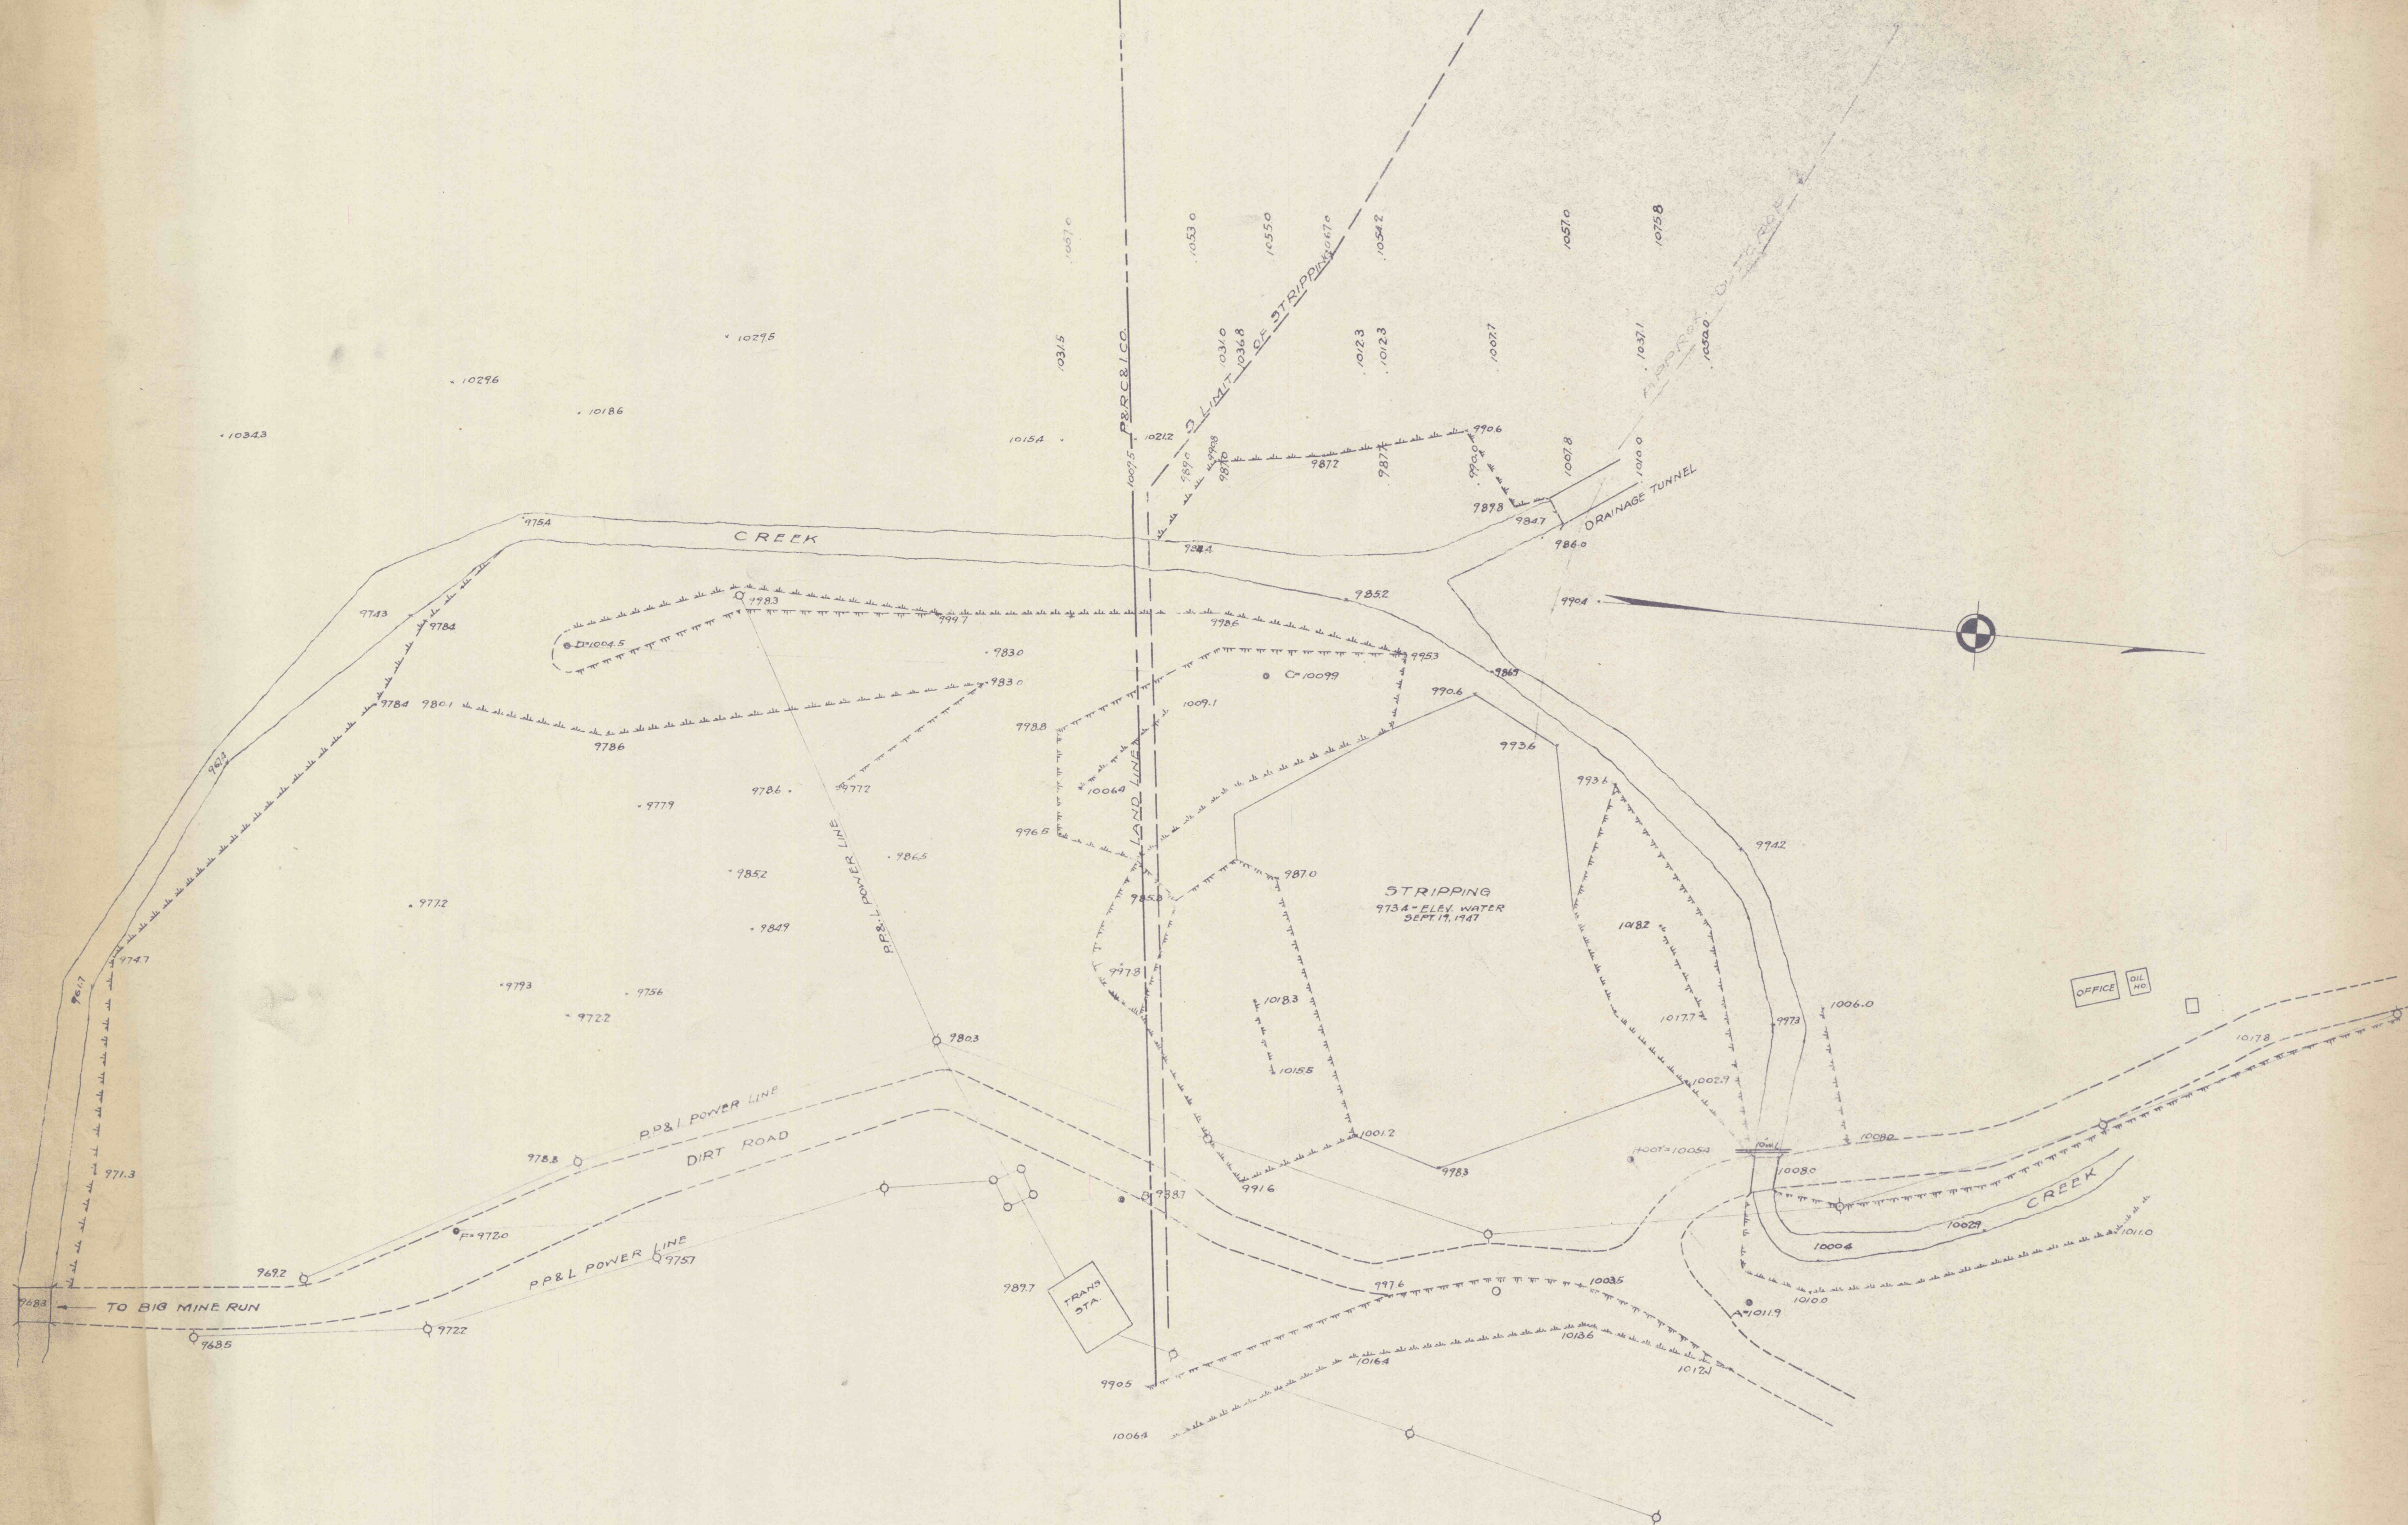

J. ROBERT BAZLEY, Inc.
FOTTSVILLE PENNA.
MAP SHOWING PROPOSED
CHANGE IN CREEK AT BIG
MINE RUN MAM. VN STRIP
DATE 10-47 1948