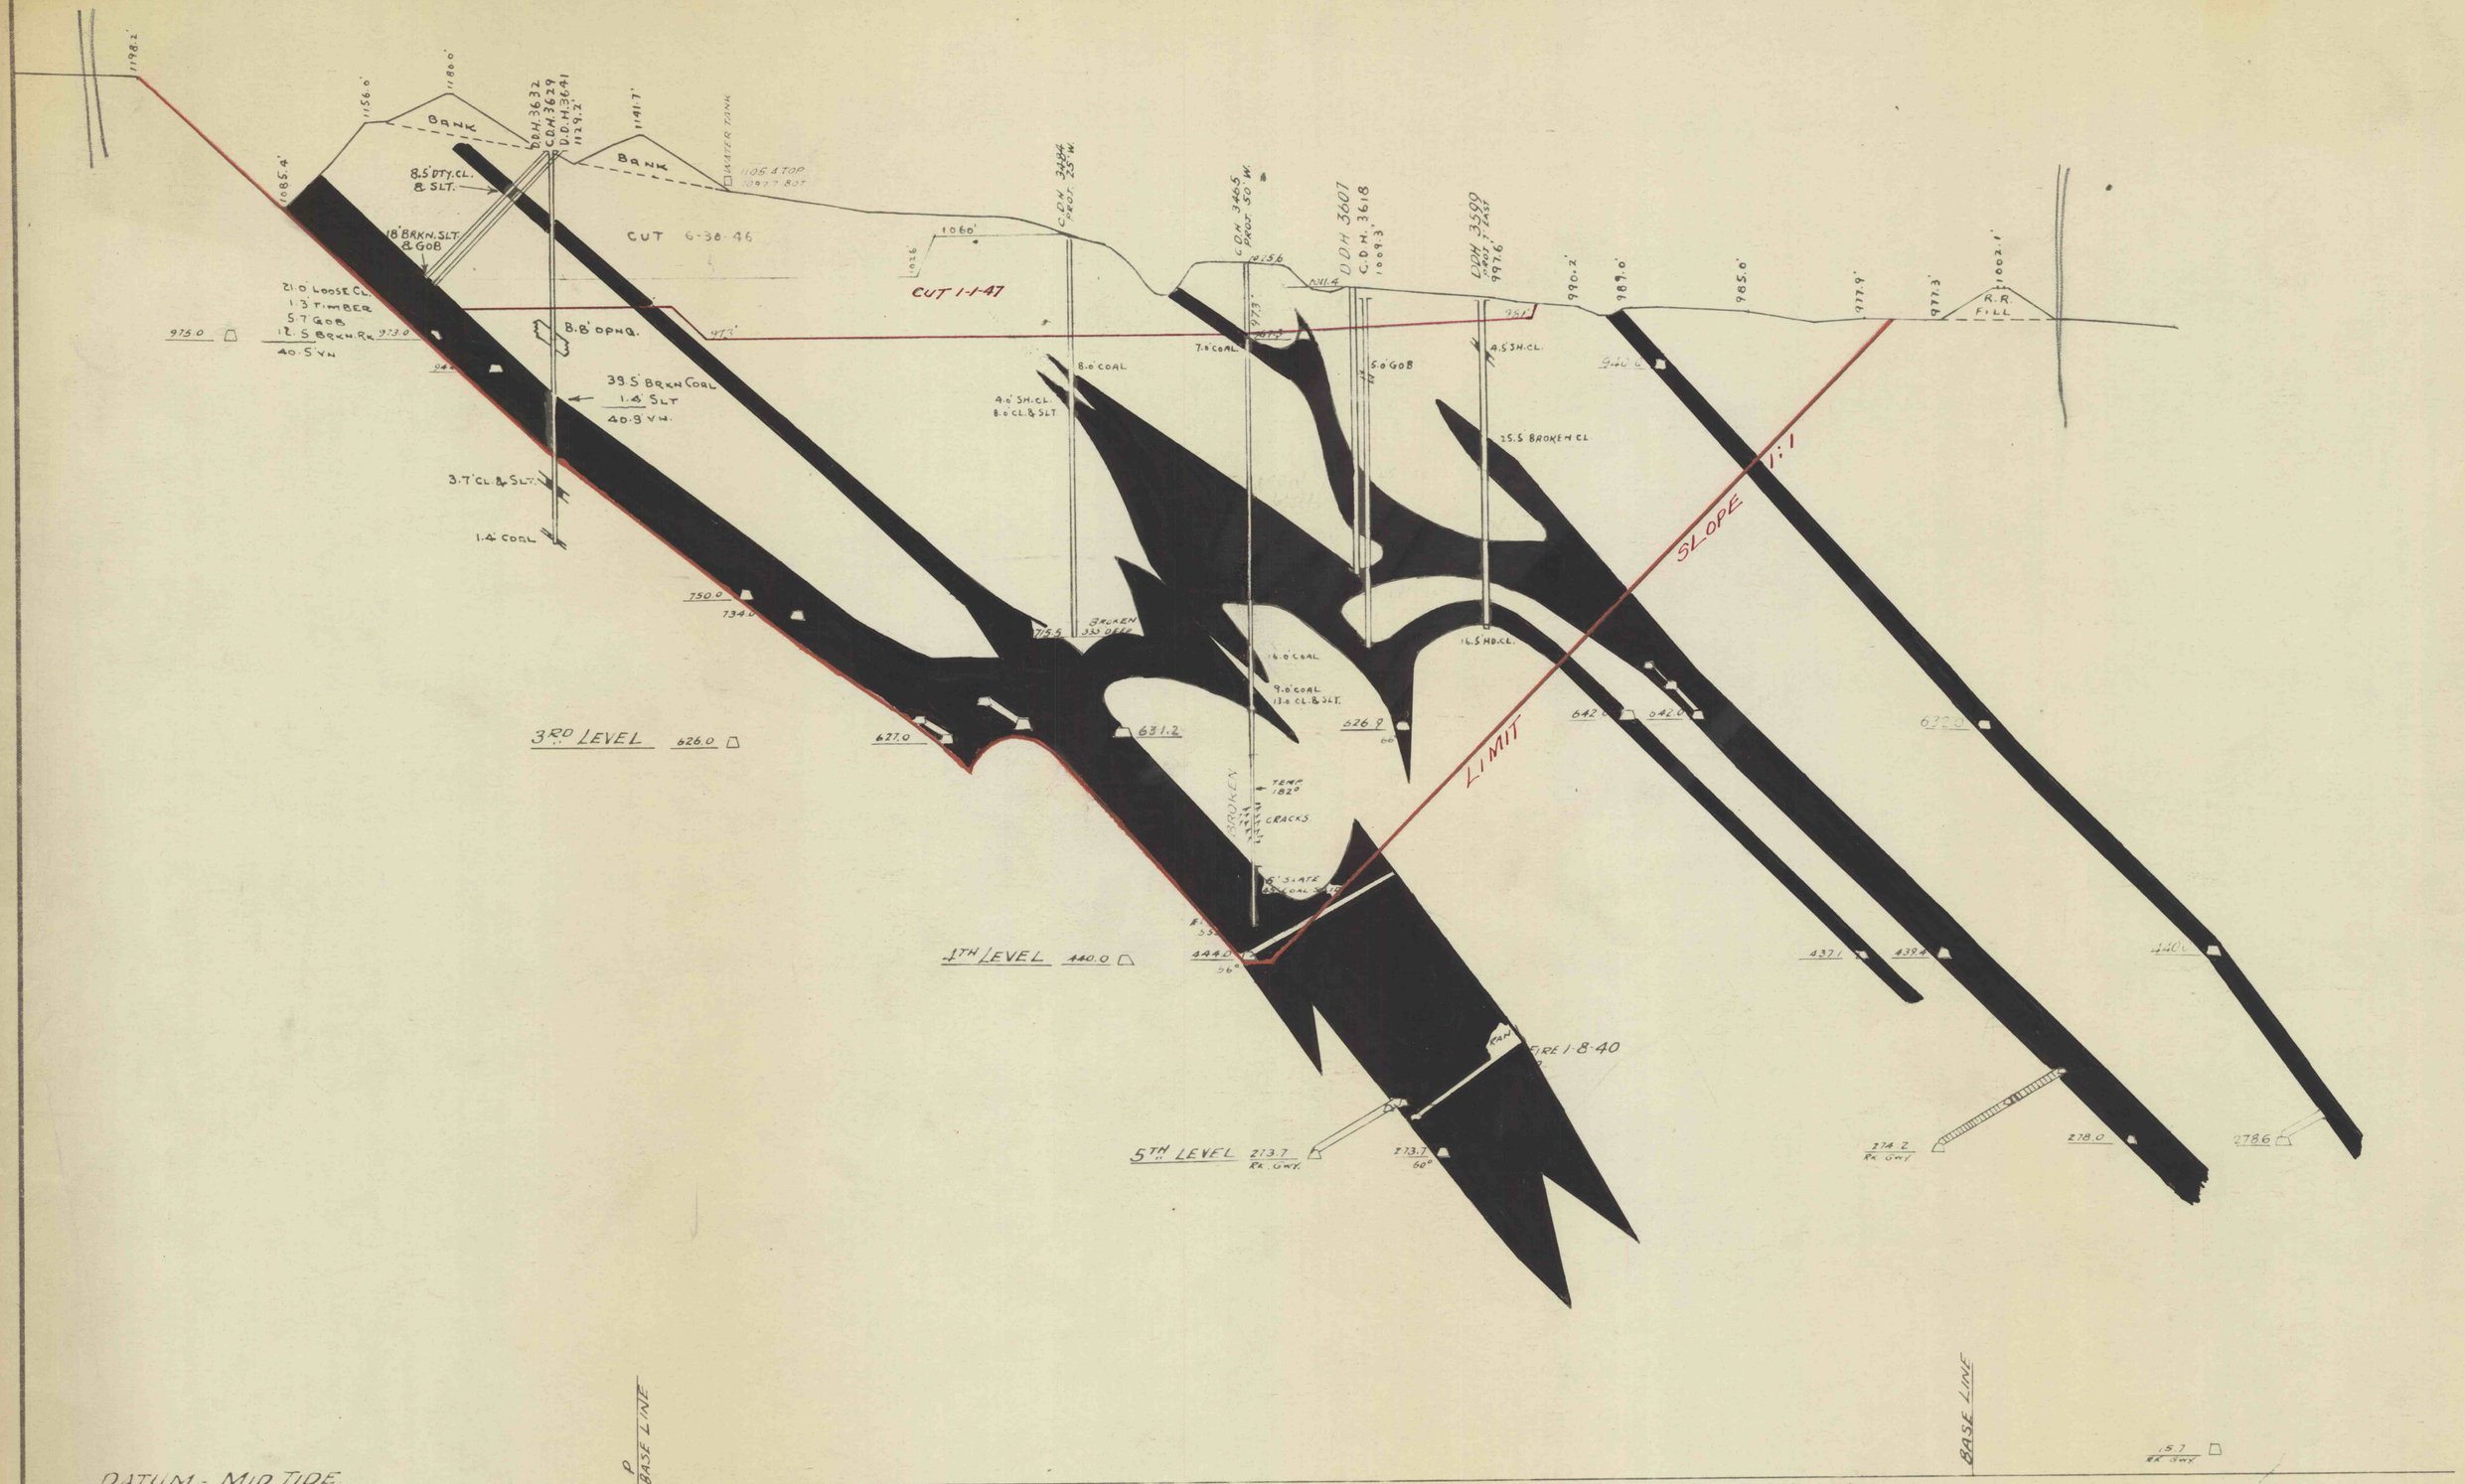

34

LEHIGH NAVIGATION COAL CO., INC.
LANSFORD, PENNA.
MINING ENGINEERING DEPT.

GREENWOOD COLLIERY

CROSS SECTION N° 2-W
THROUGH FIRE AREA
SEE DWG 10-272

SCALE 1" = 100' DATE

MADE BY ..... TRACED BY ..... CHECKED BY .....

REVISED .....

APPROVED:-
MIN. ENGR.
DIST. SUPT.
V. P. & GEN. M'G'R.

C1062