


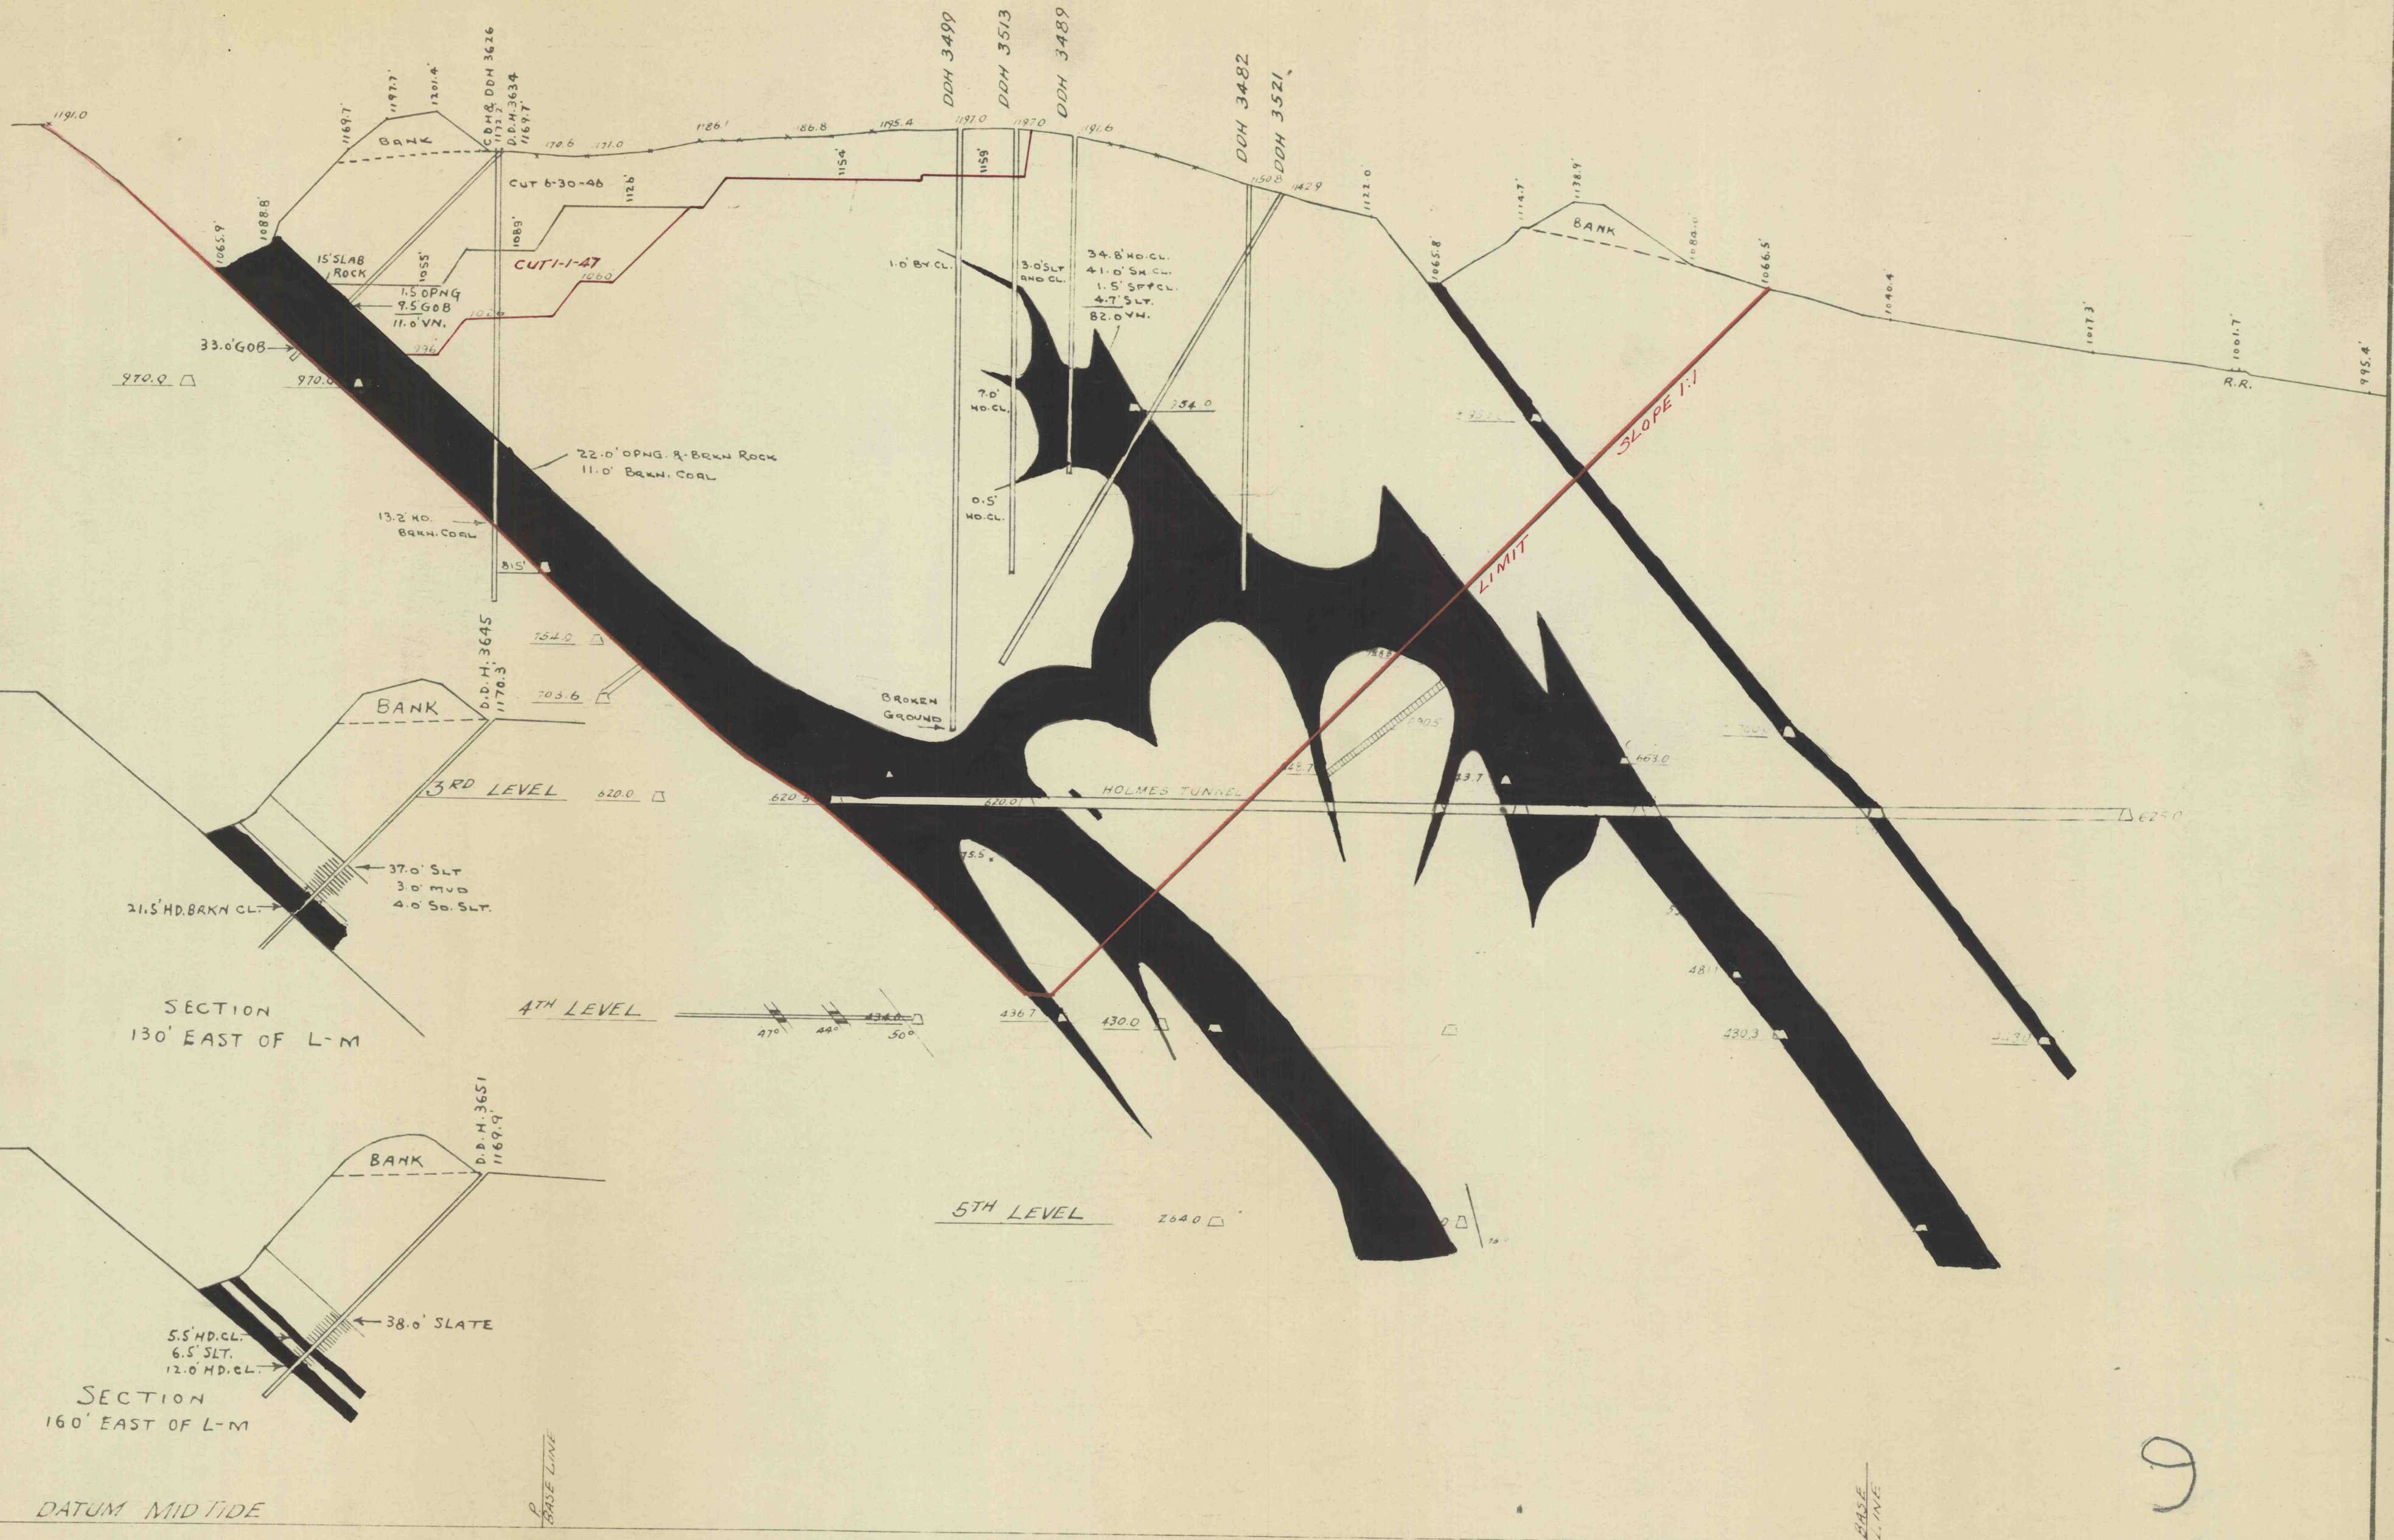

LEHIGH NAVIGATION COAL CO., INC.  
 LANSFORD, PENNA.  
 MINING ENGINEERING DEPT.

**GREENWOOD COLLIERY**

**CROSS SECTION L-M**  
 THROUGH FIRE AREA  
 SEE DWG. 10-272

SCALE 1" = 100' DATE \_\_\_\_\_

MADE BY \_\_\_\_\_ TRACED BY \_\_\_\_\_ CHECKED BY \_\_\_\_\_

REVISED \_\_\_\_\_

APPROVED: \_\_\_\_\_

MIN. ENGR.  
 DIST. SUPT.  
 V. P. & GEN. MGR.

**C1069**