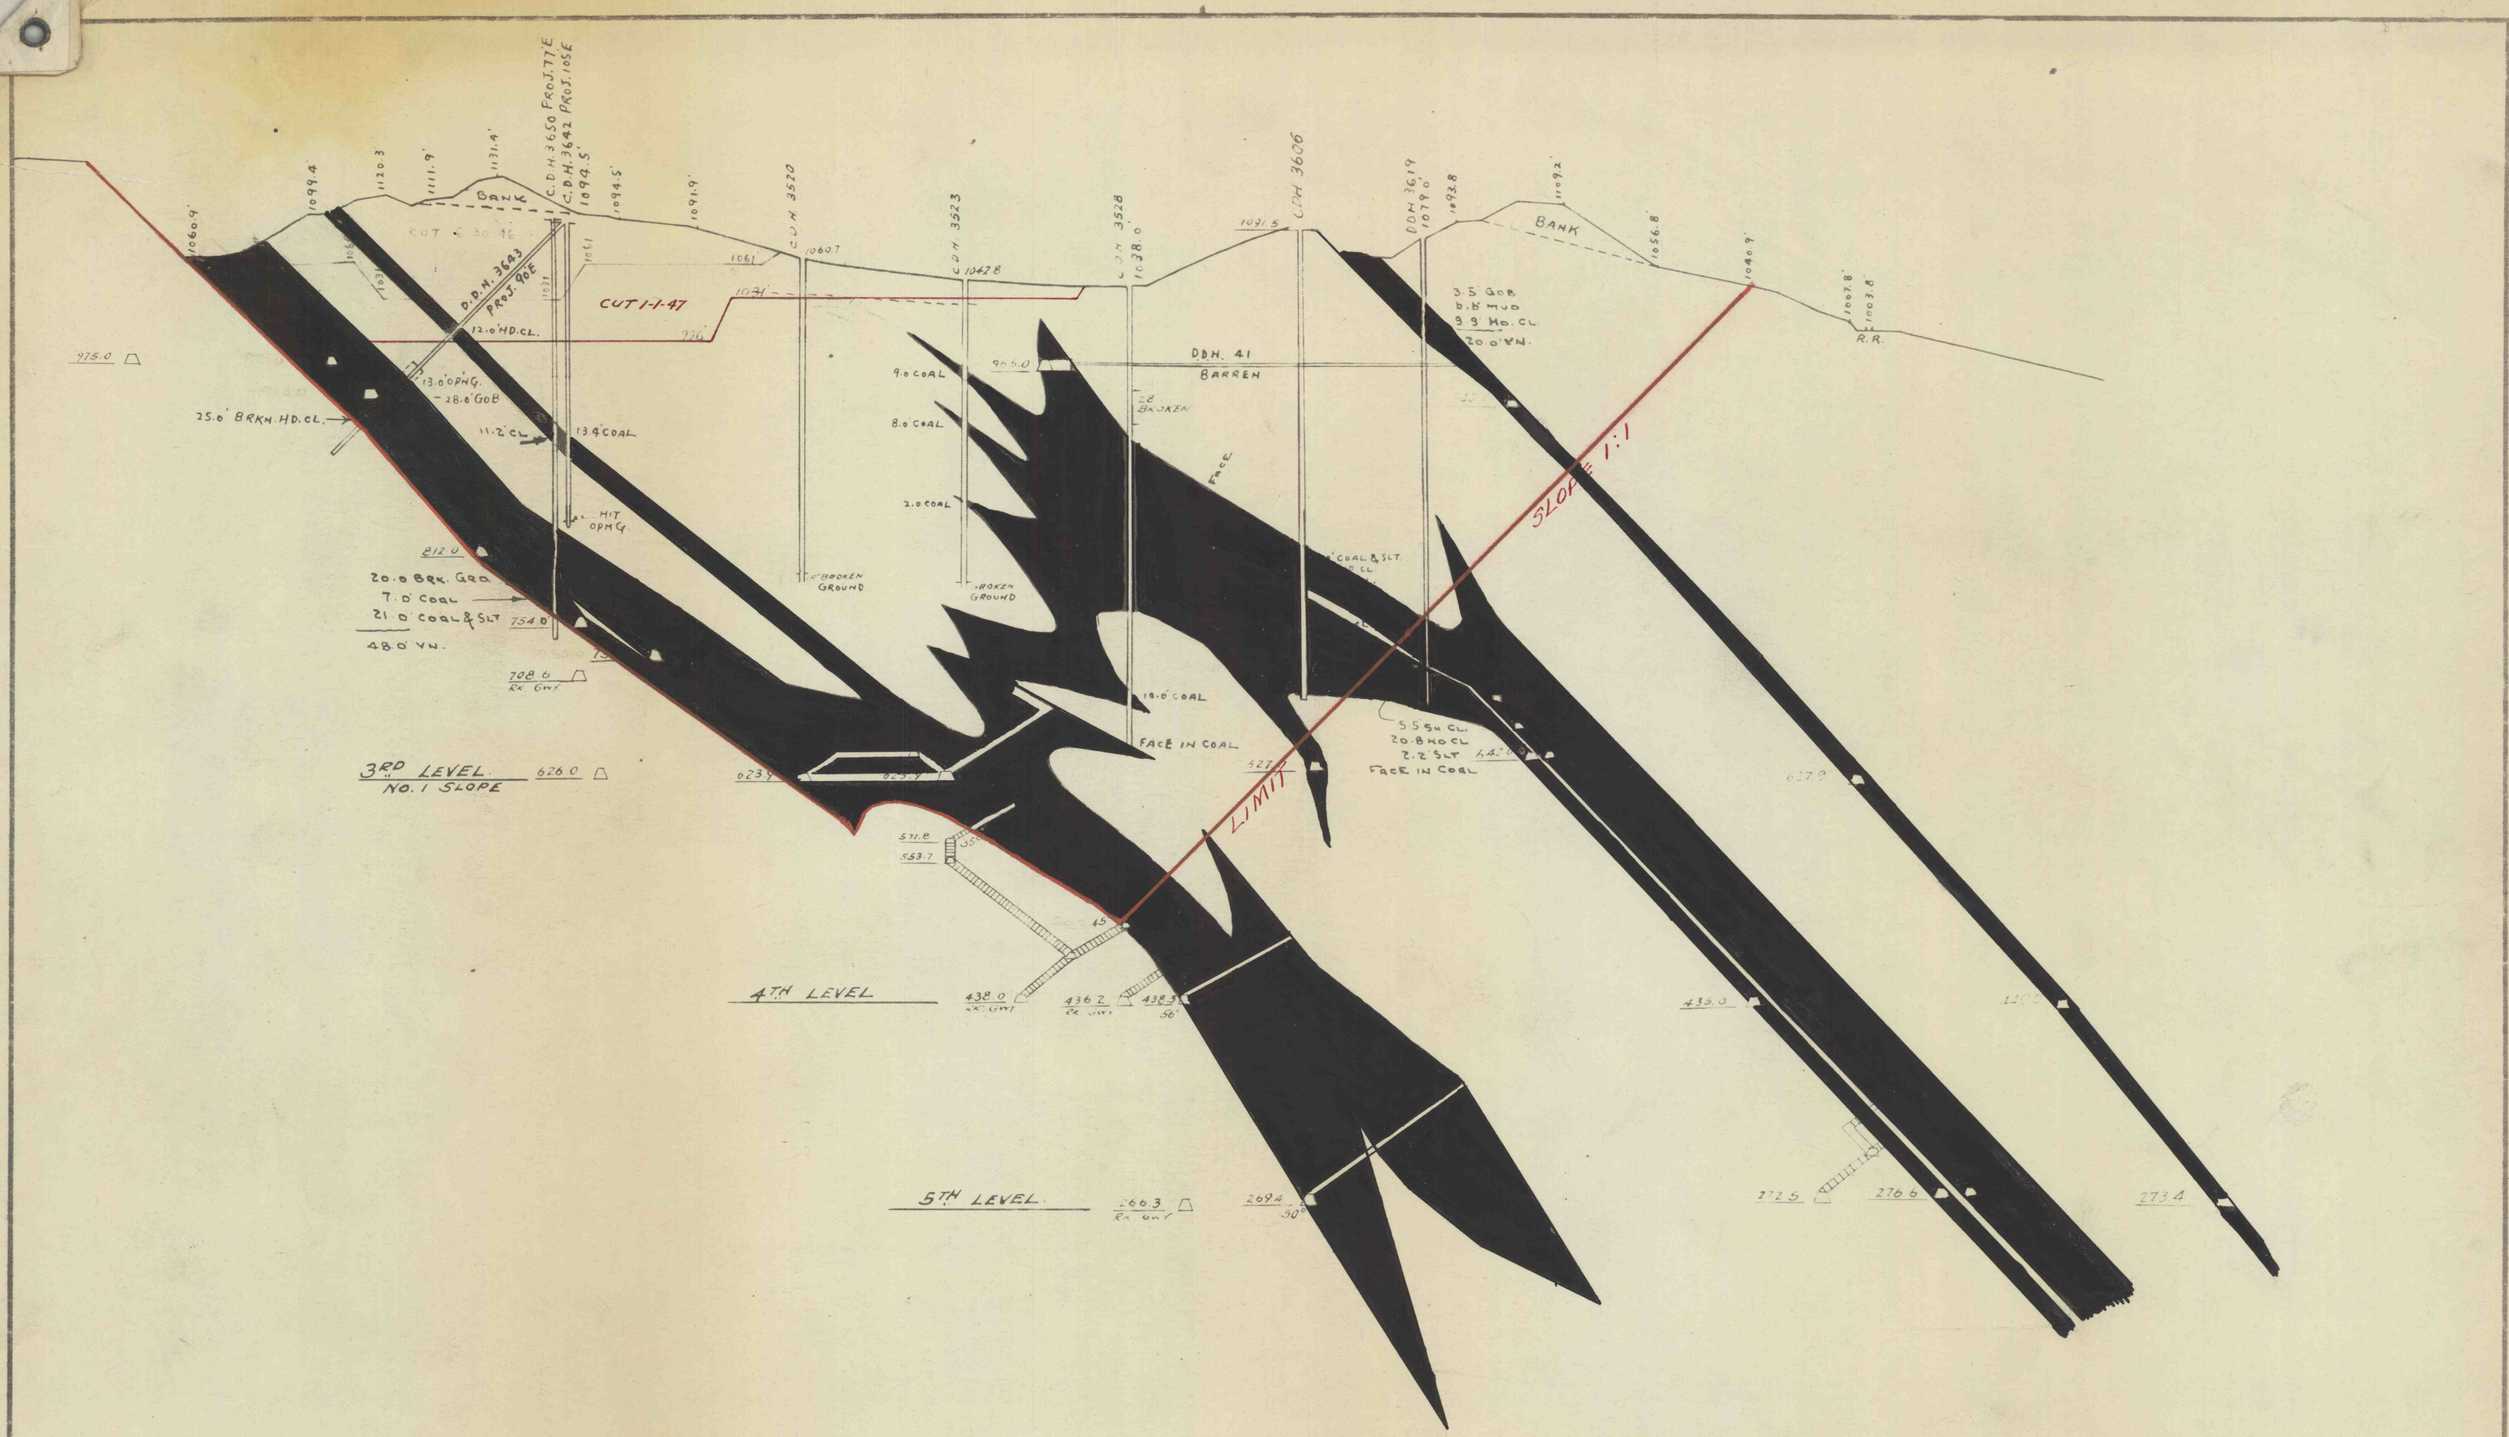

25

LEHIGH NAVIGATION COAL CO., INC.
LANSFORD, PENNA.
MINING ENGINEERING DEPT.

GREENWOOD COLLIERY

CROSS SECTION #1-E
THROUGH FIRE AREA
SEE DWG. 10-272

SCALE 1" = 100' DATE

MADE BY TRACED BY CHECKED BY

REVISED

APPROVED:-

MIN. ENGR.

DIST. SUPT.

V. P. & GEN. M'G'R.

C1065