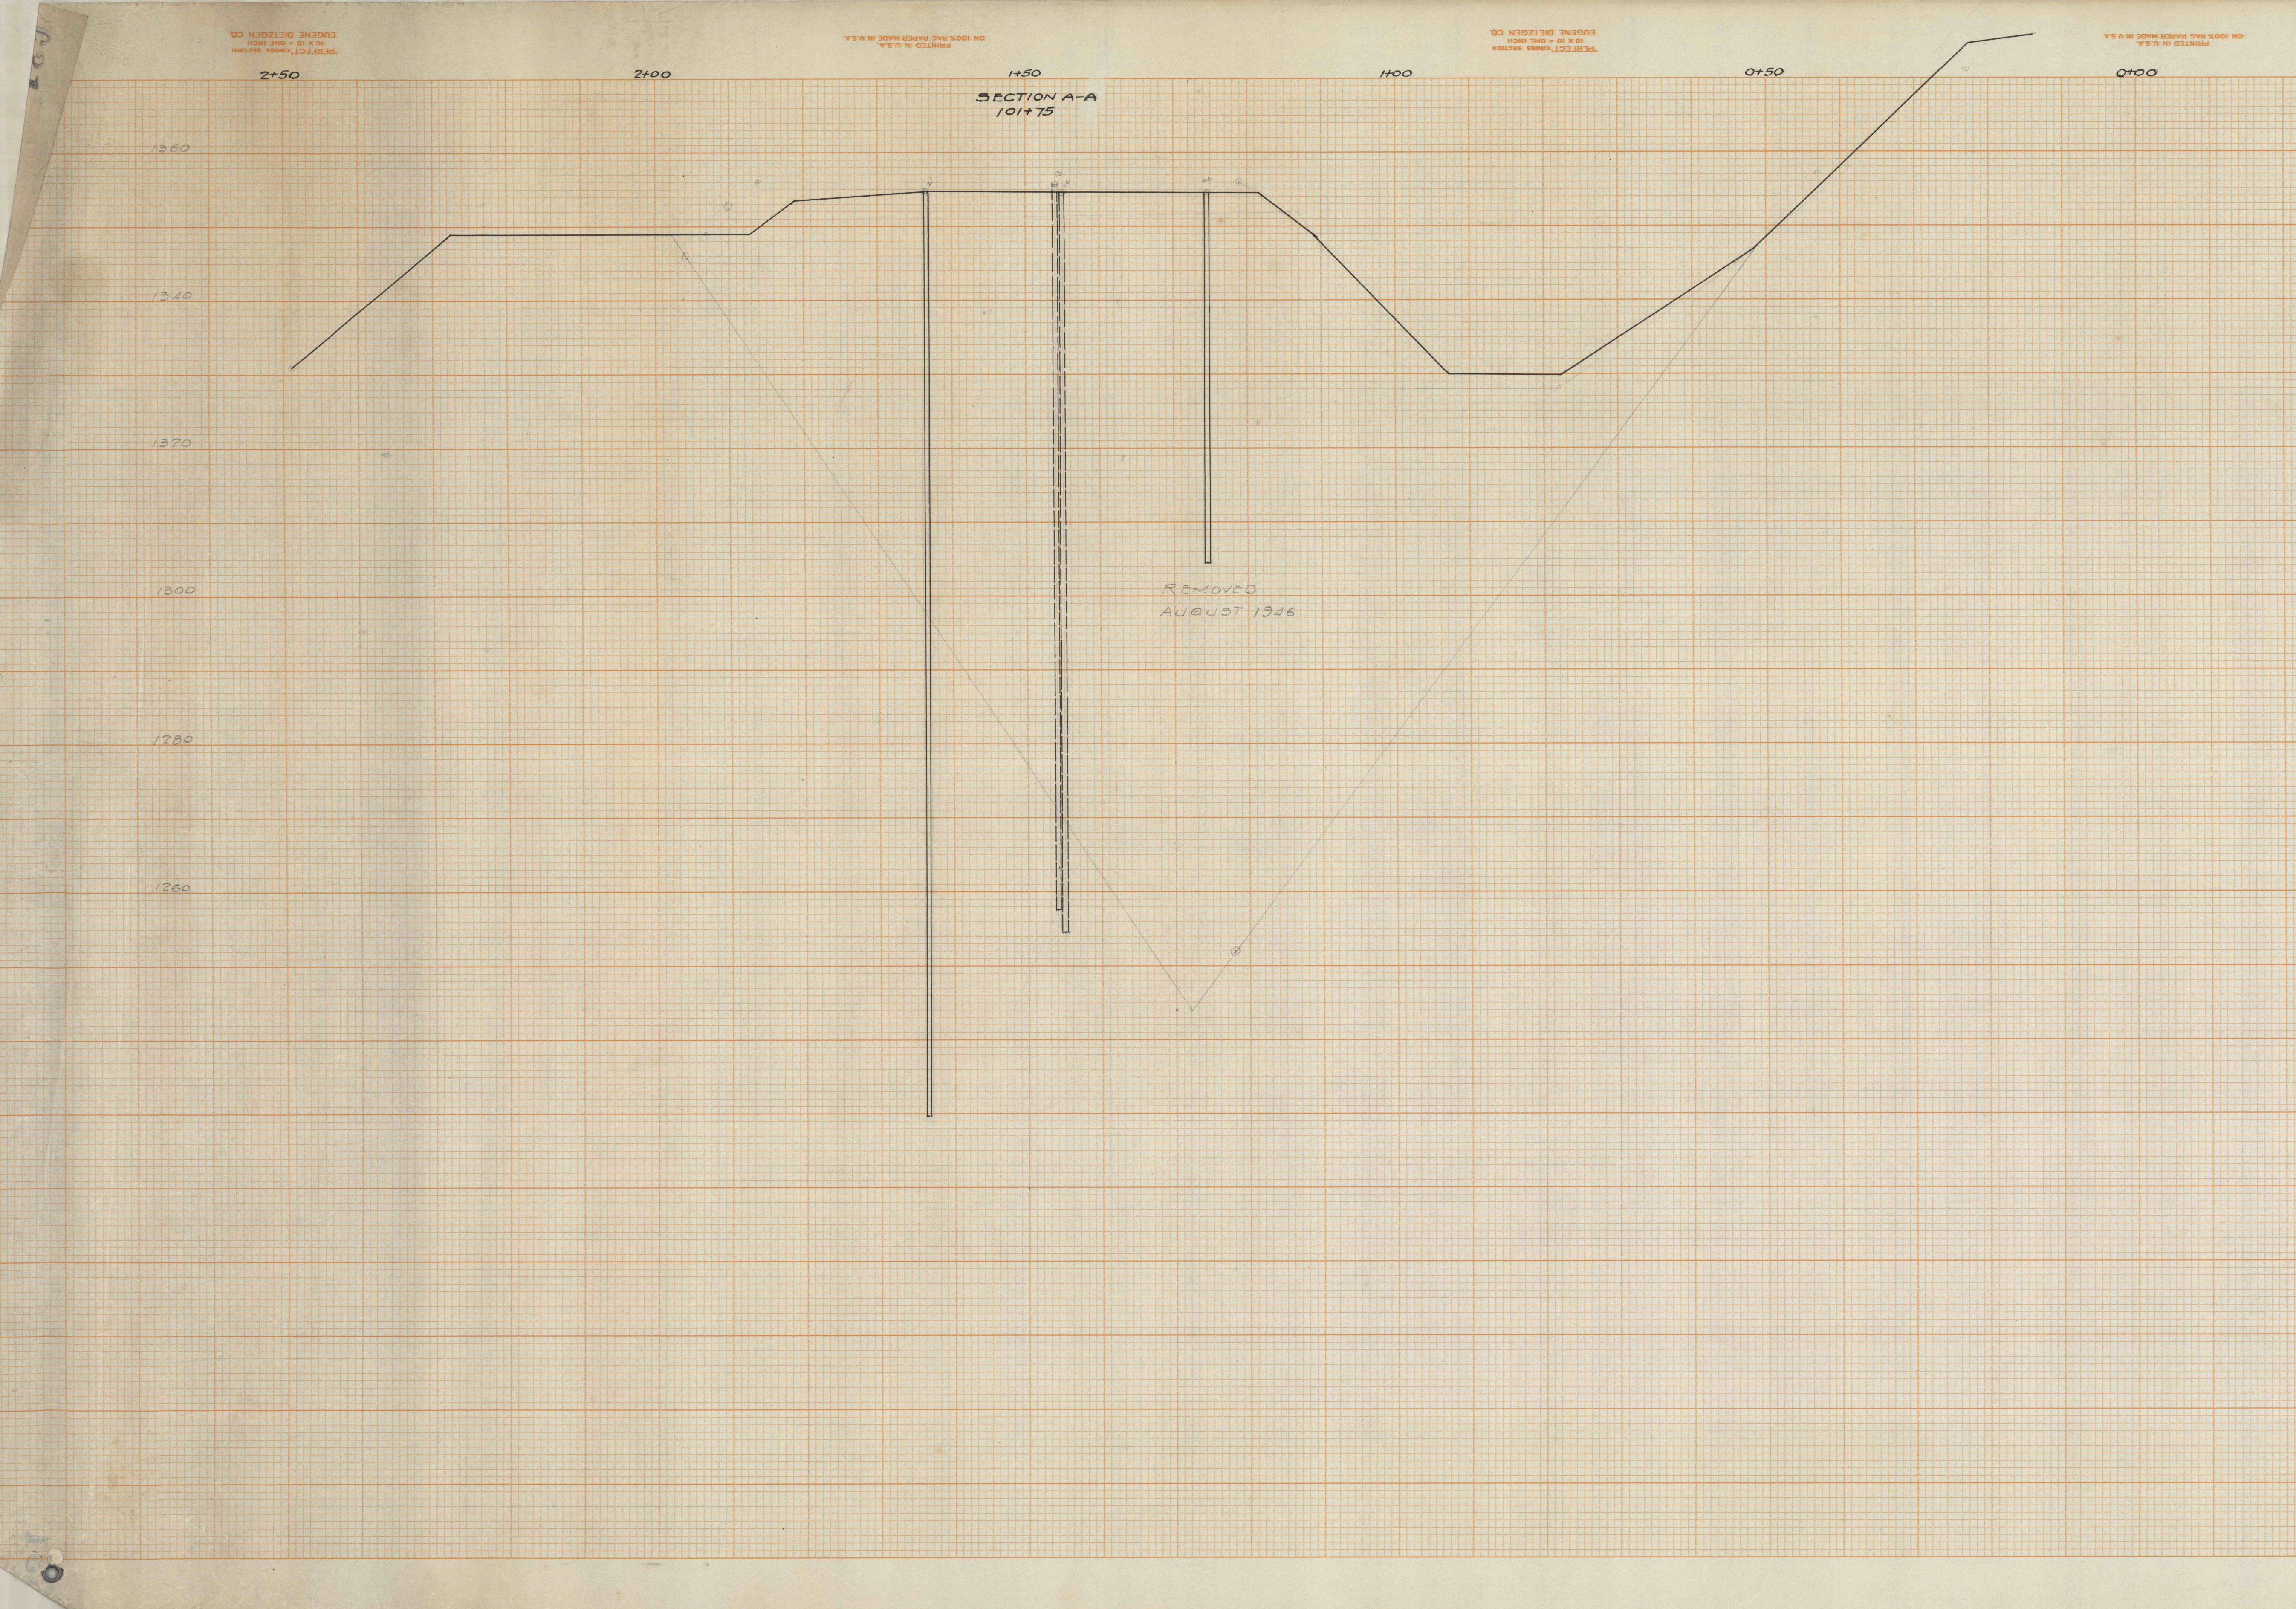
SECTION A-A
101+75
2+50
2+00
1+50
1+00
0+50
0+00
2+50
1360
1340
1320
1300
1280
1260
REMOVED
AUGUST 1946

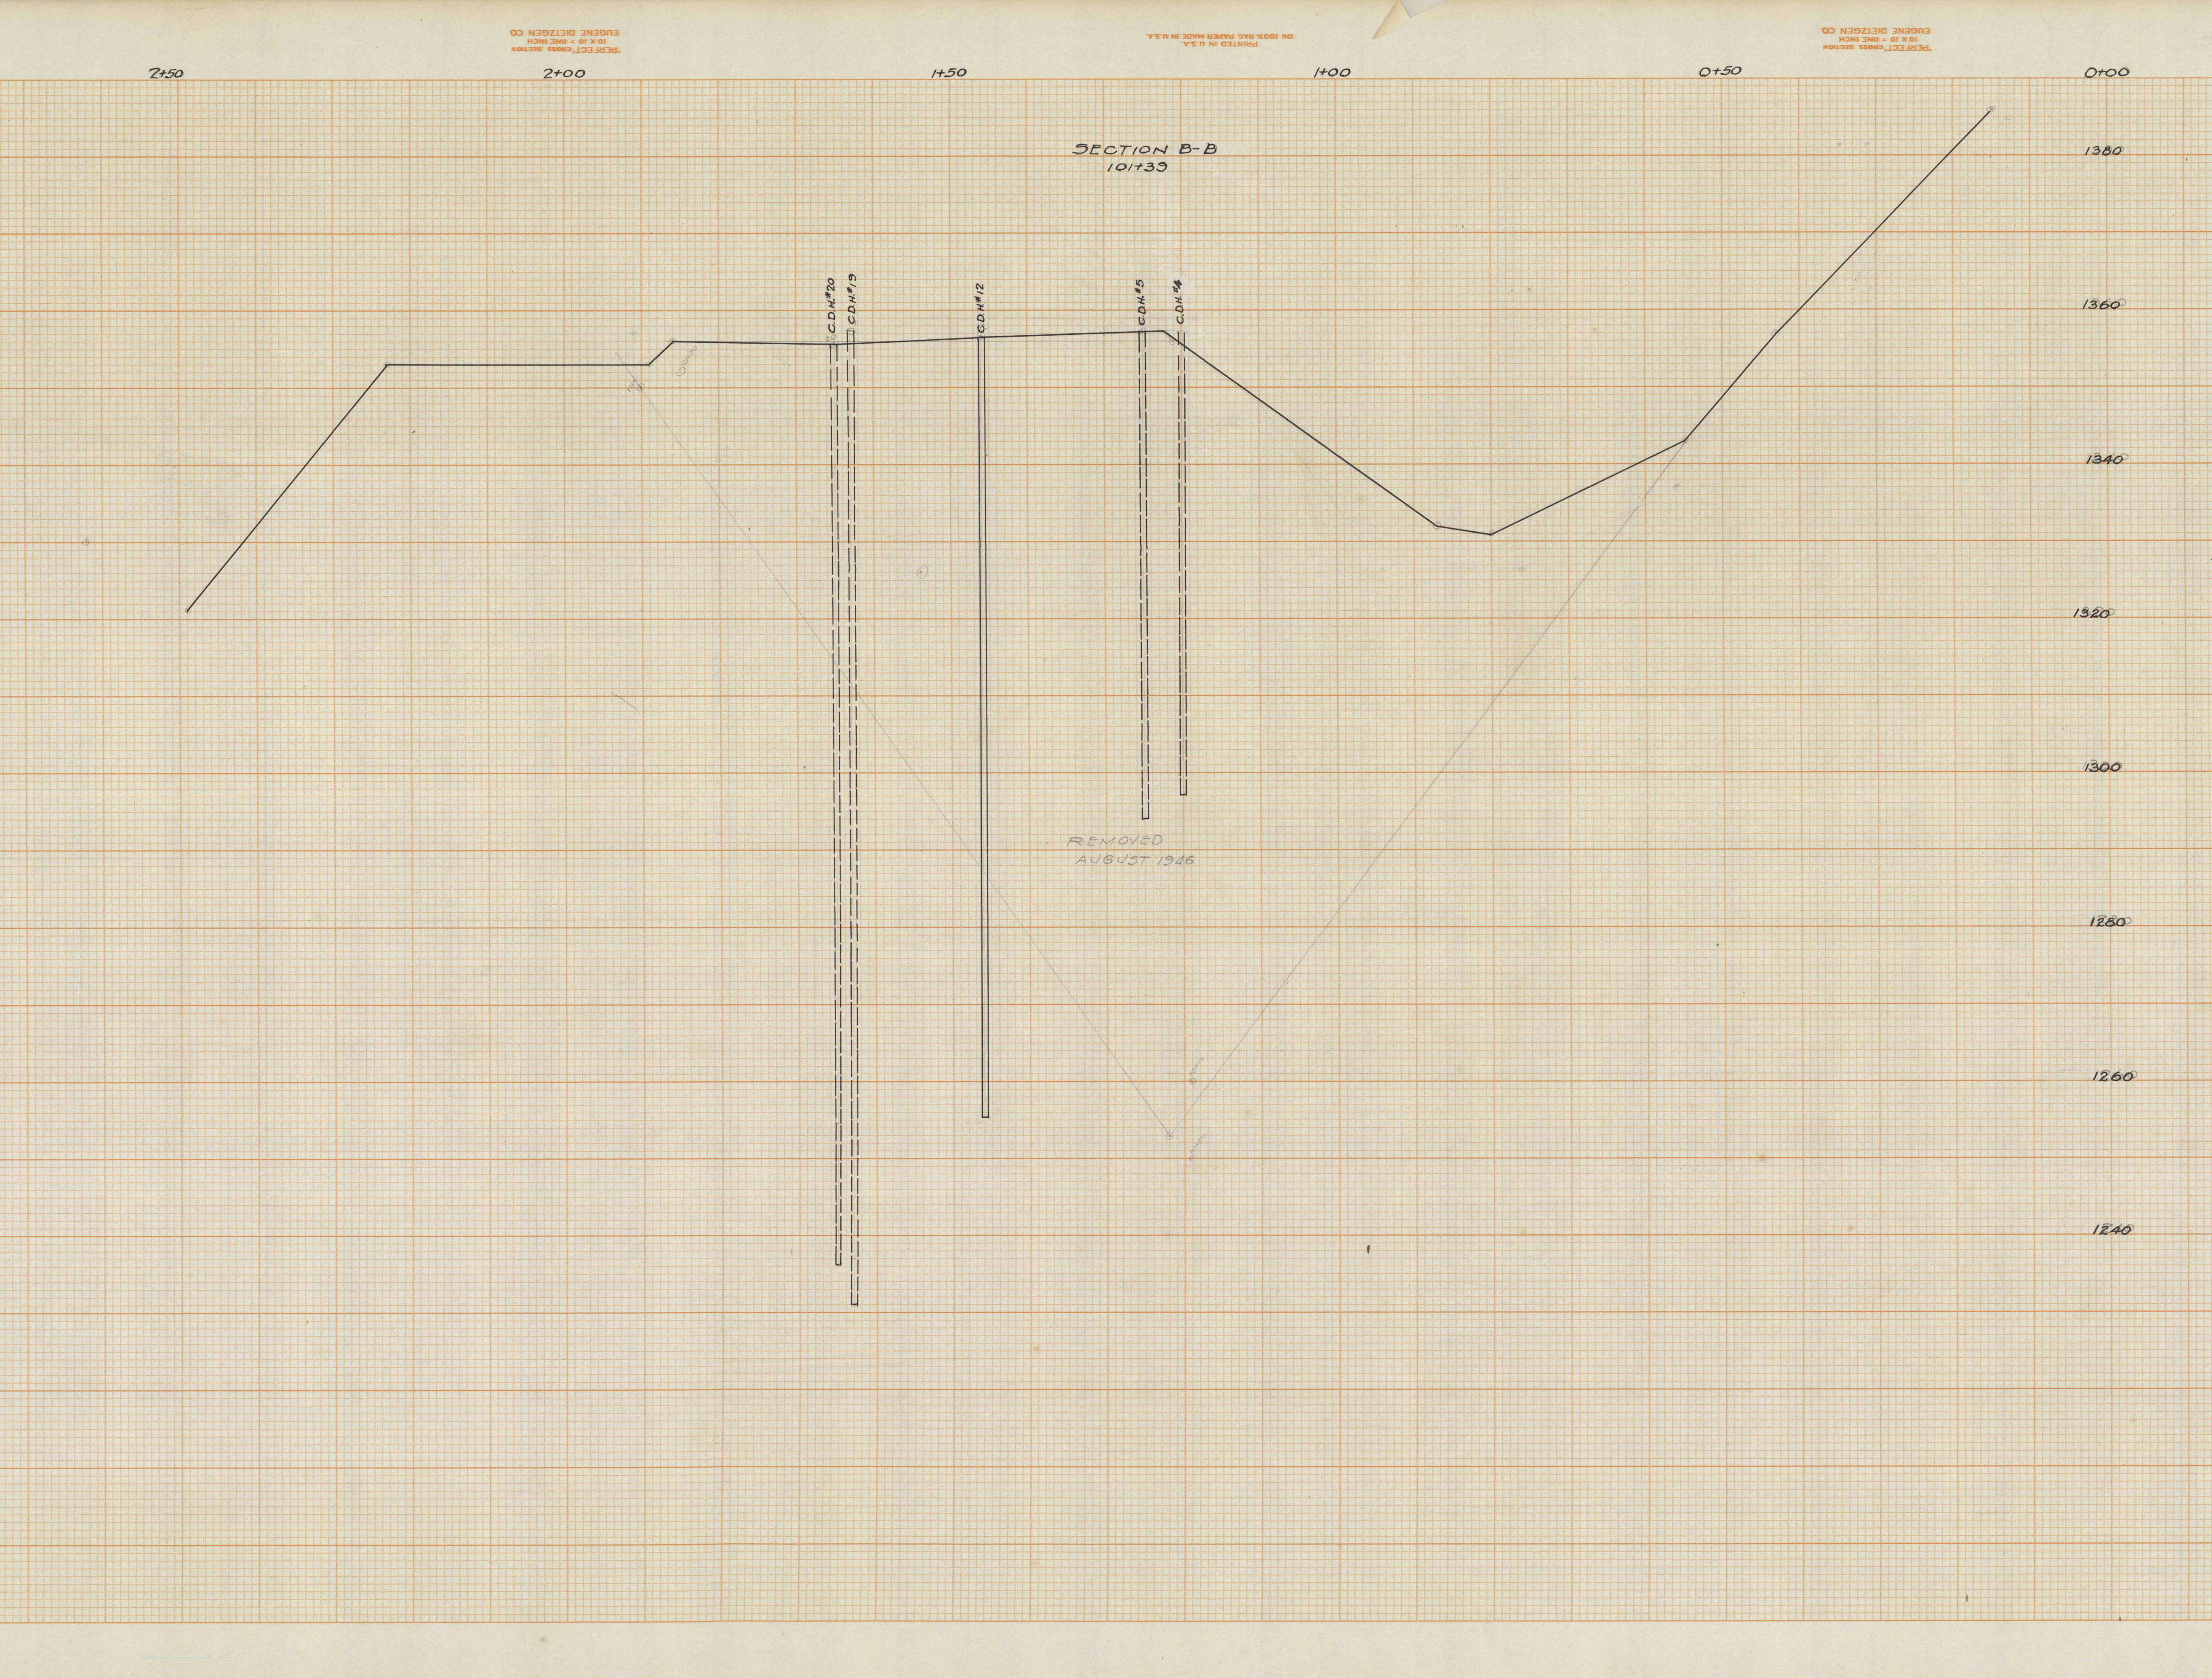
SECTION B-B
101+39
0+00
2+50
2+00
1+50
1+00
0+50
0+00
C.D.H.#20
C.D.H.#19
C.D.H.#12
C.D.H.#5
C.D.H.#4
1380
1360
1340
1320
1300
1280
1260
1240
REMOVED
AUGUST 1946

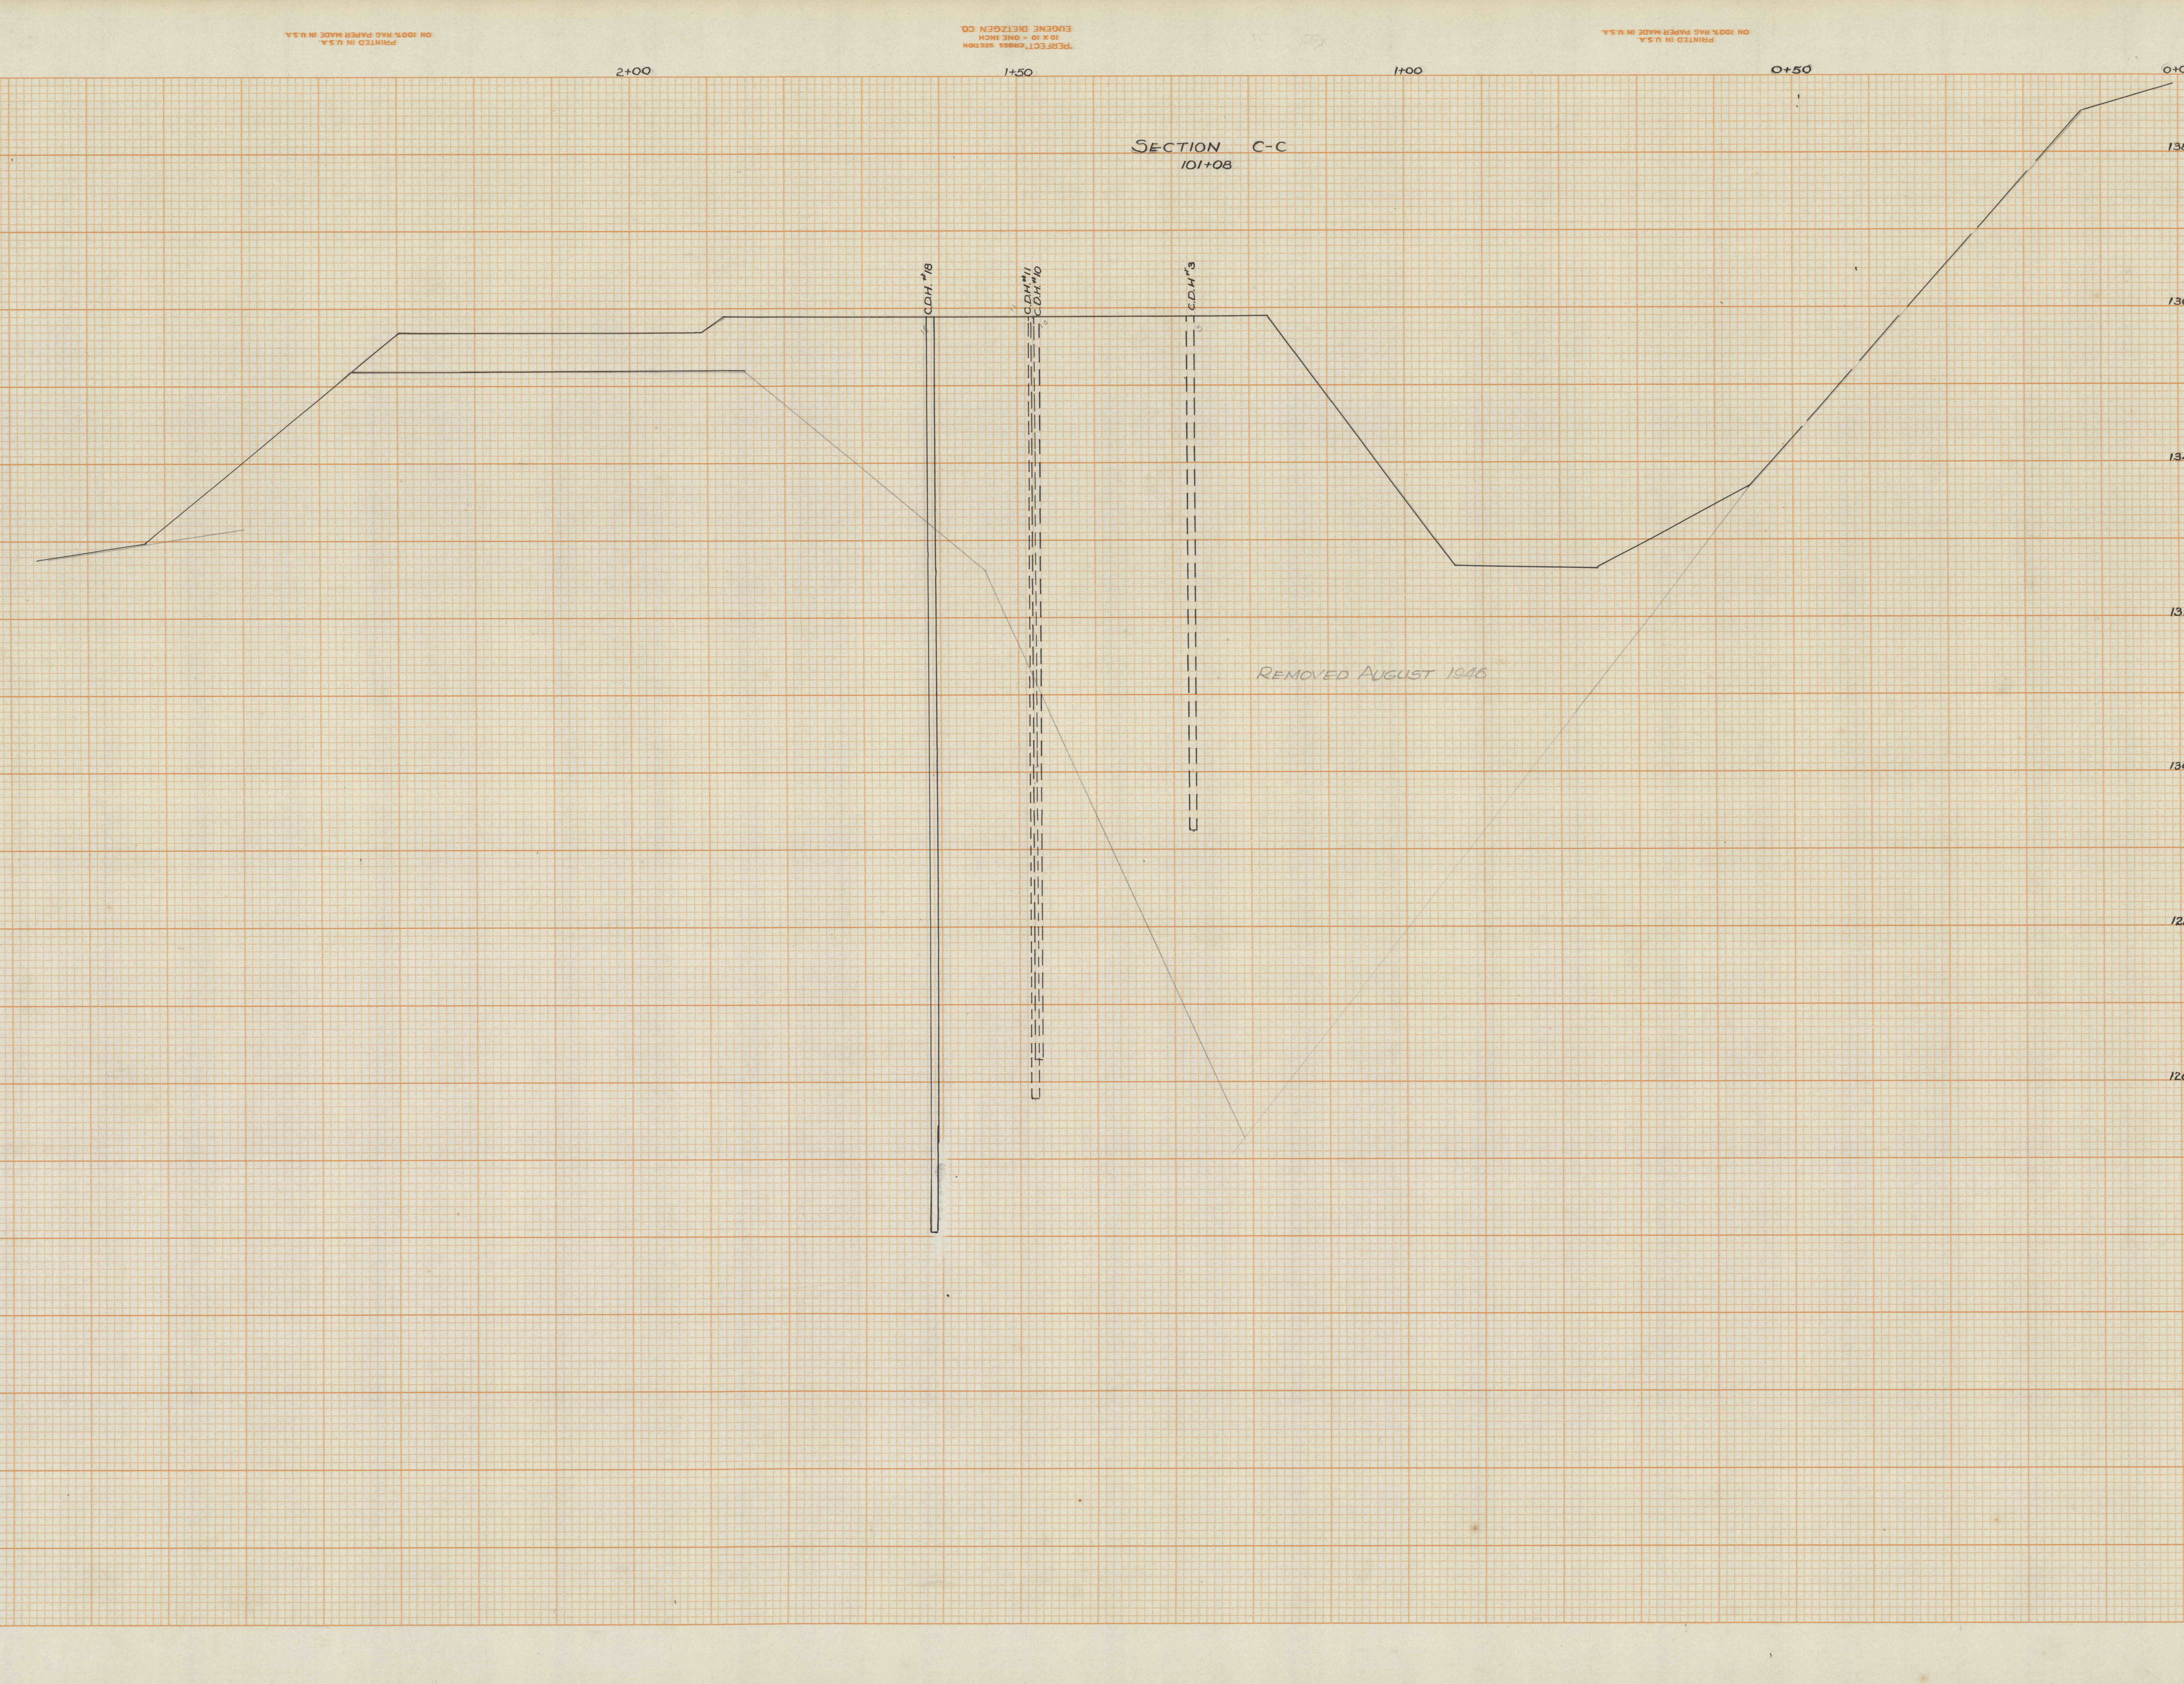
SECTION C-C
101+08
0+00
2+00
1+50
1+00
0+50
0+00
C.D.H.#18
C.D.H.#11
C.D.H.#10
C.D.H.#3
1380
1360
1340
REMOVED AUGUST 1946

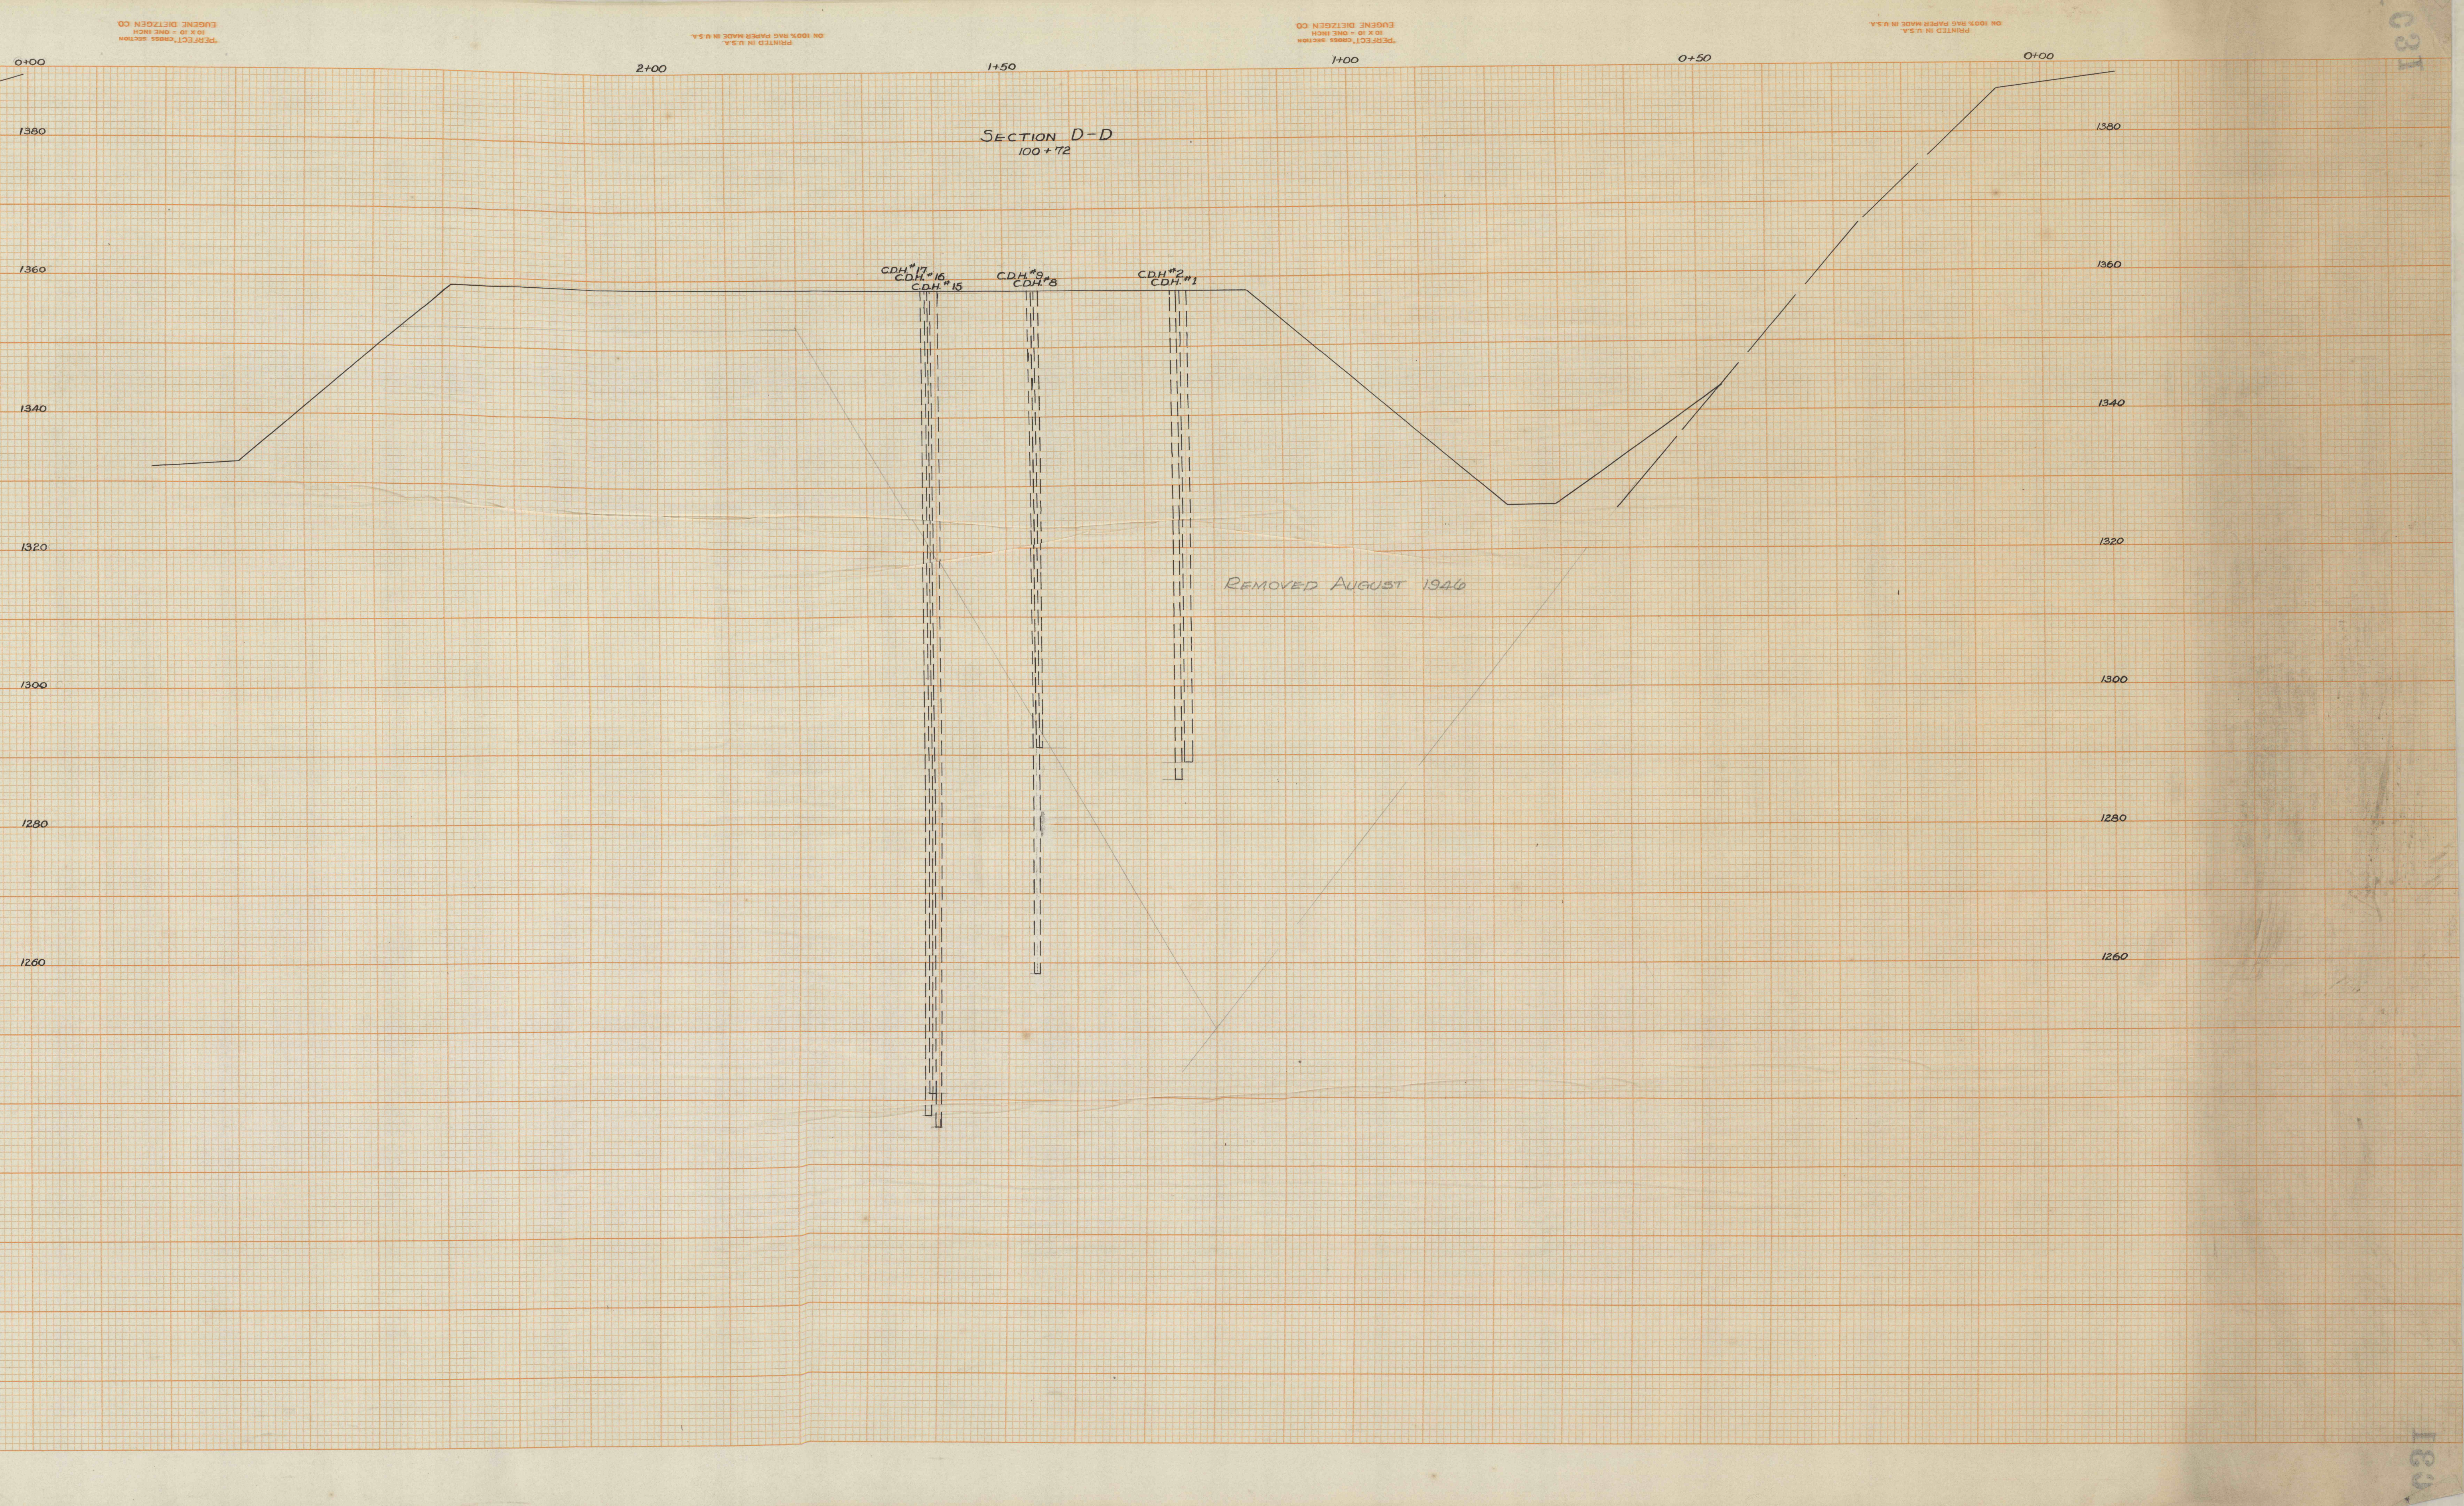
SECTION D-D
100+72
0+00
2+00
1+50
1+00
0+50
0+00
C.D.H.#17
C.D.H.#16
C.D.H.#15
C.D.H.#9
C.D.H.#8
C.D.H.#2
C.D.H.#1
1380
1360
1340
1320
1300
1280
1260
REMOVED AUGUST 1946