


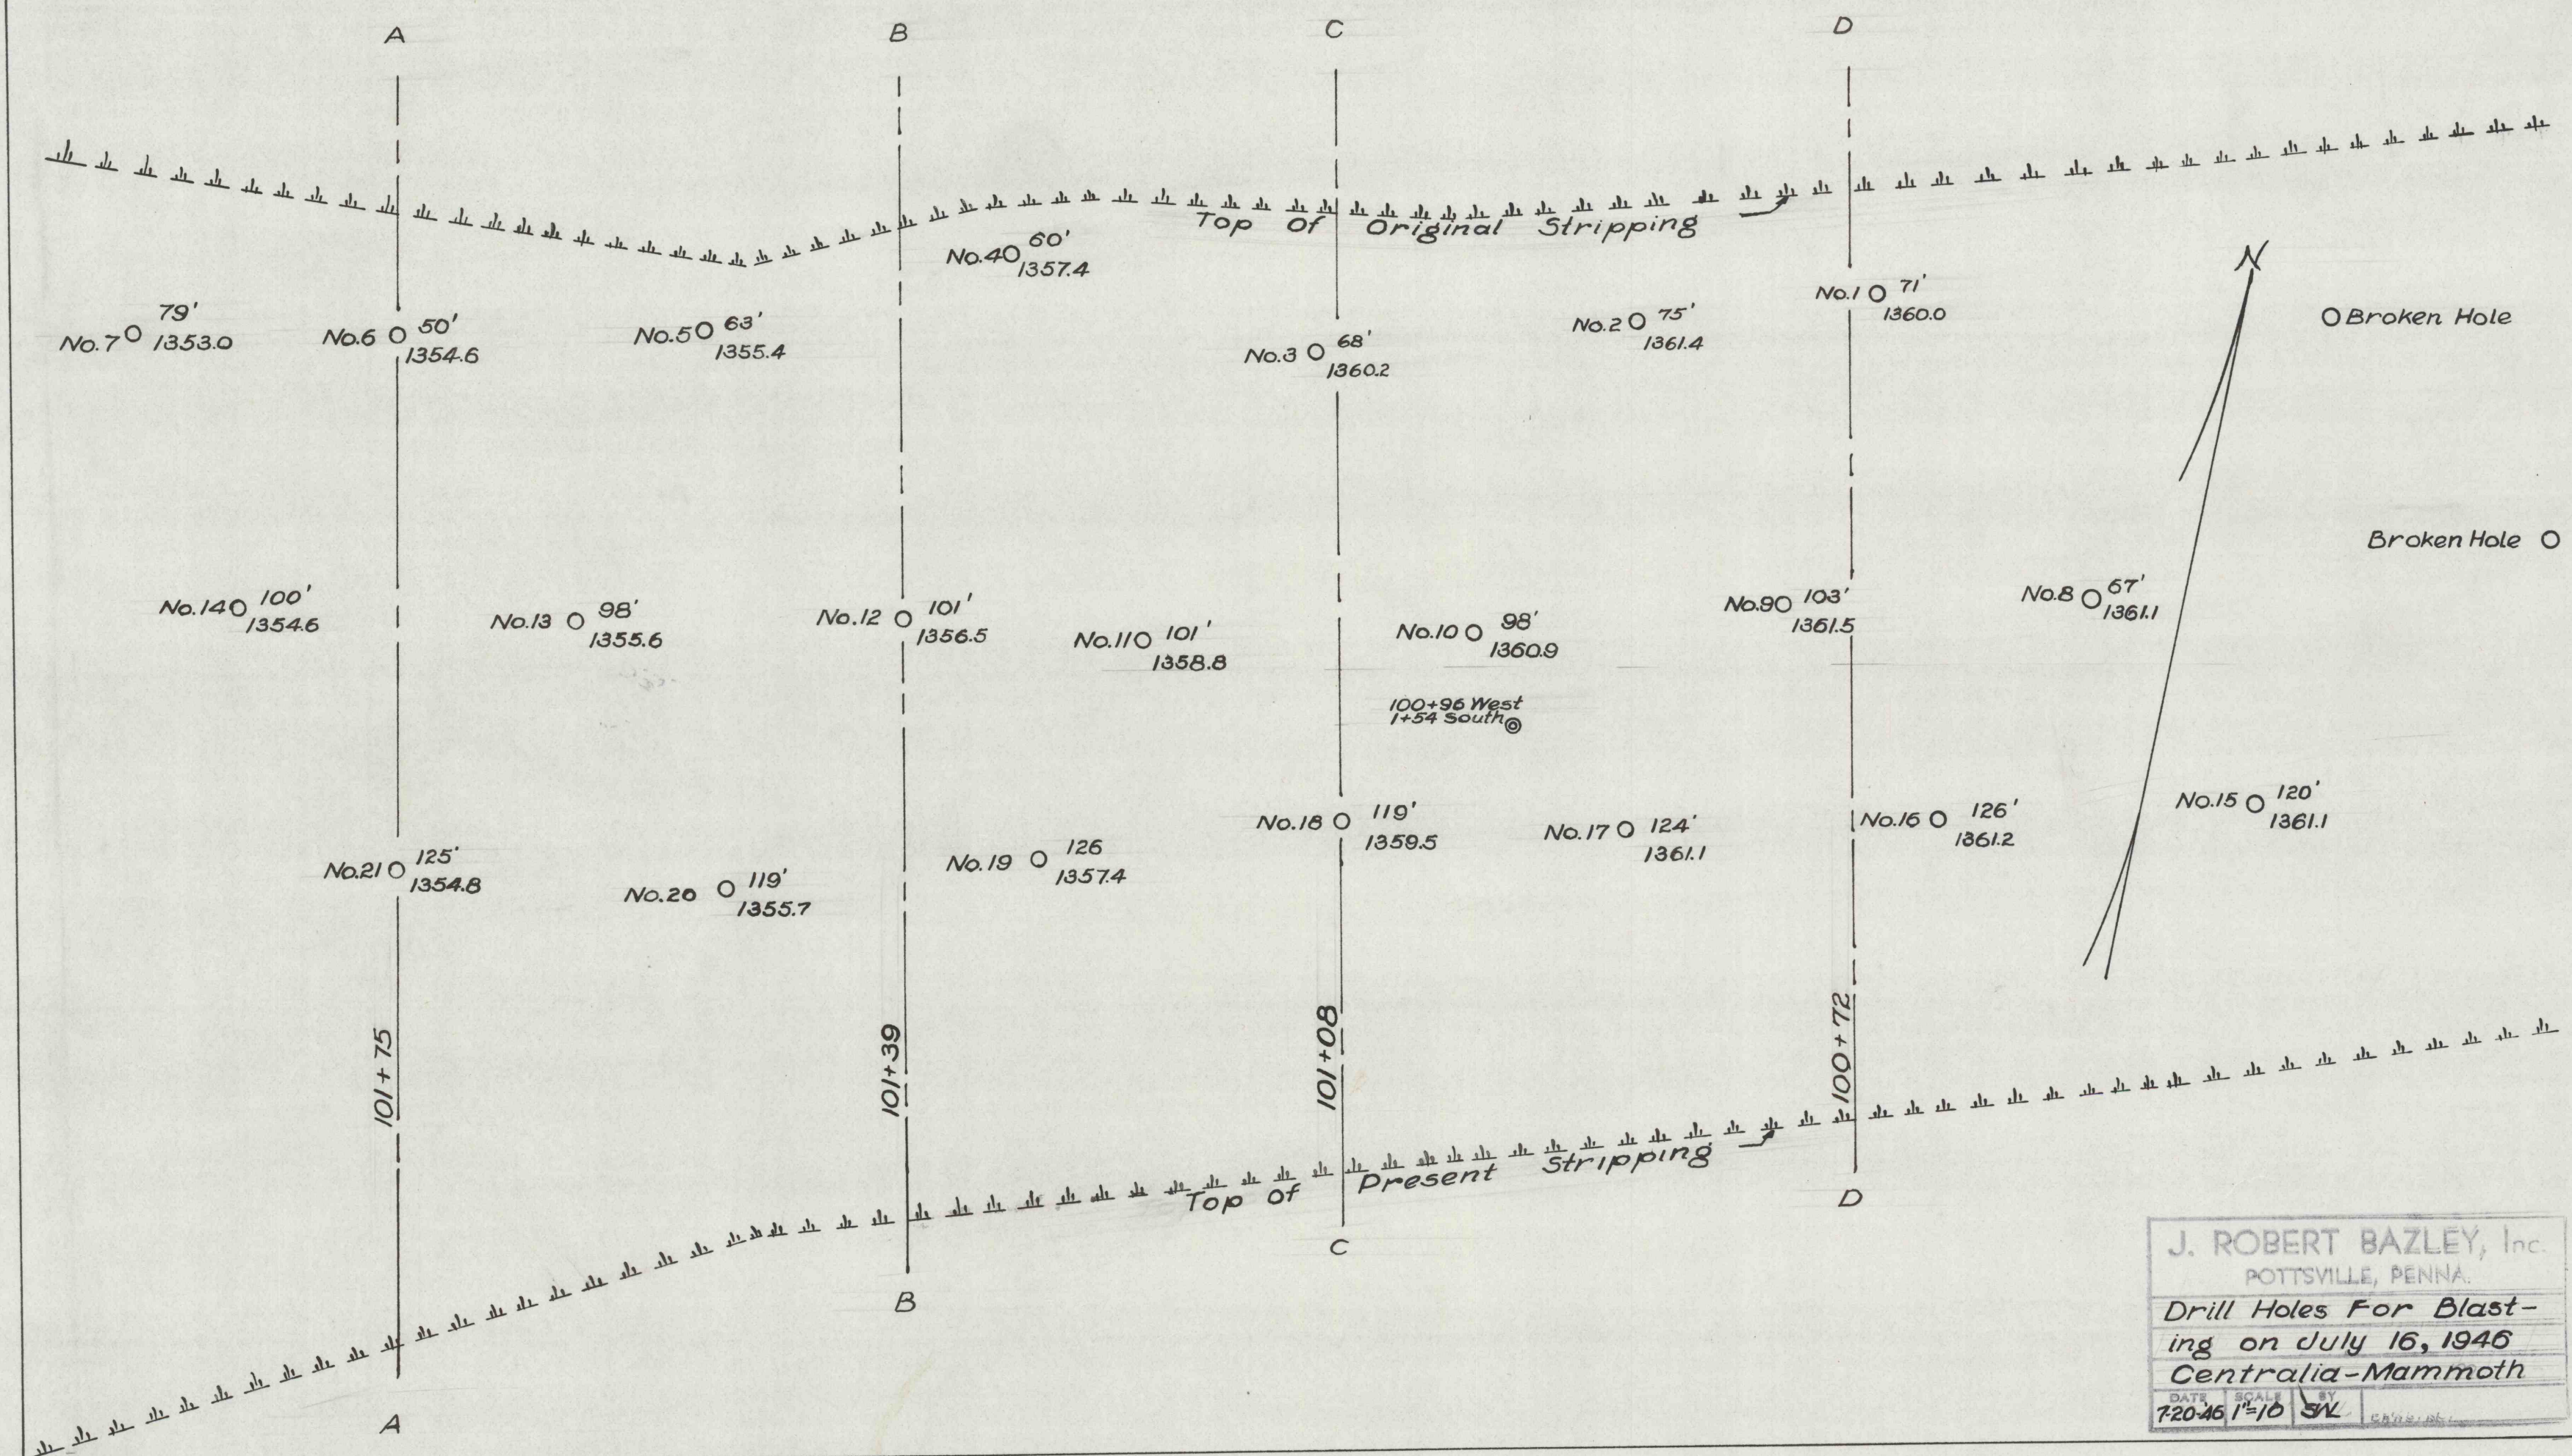

J. ROBERT BAZLEY, Inc.
POTTSVILLE, PENNA.
Drill Holes For Blast-
ing on July 16, 1946
Centralia-Mammoth

DATE	SCALE	BY
7-20-46	1"=10'	SVL