


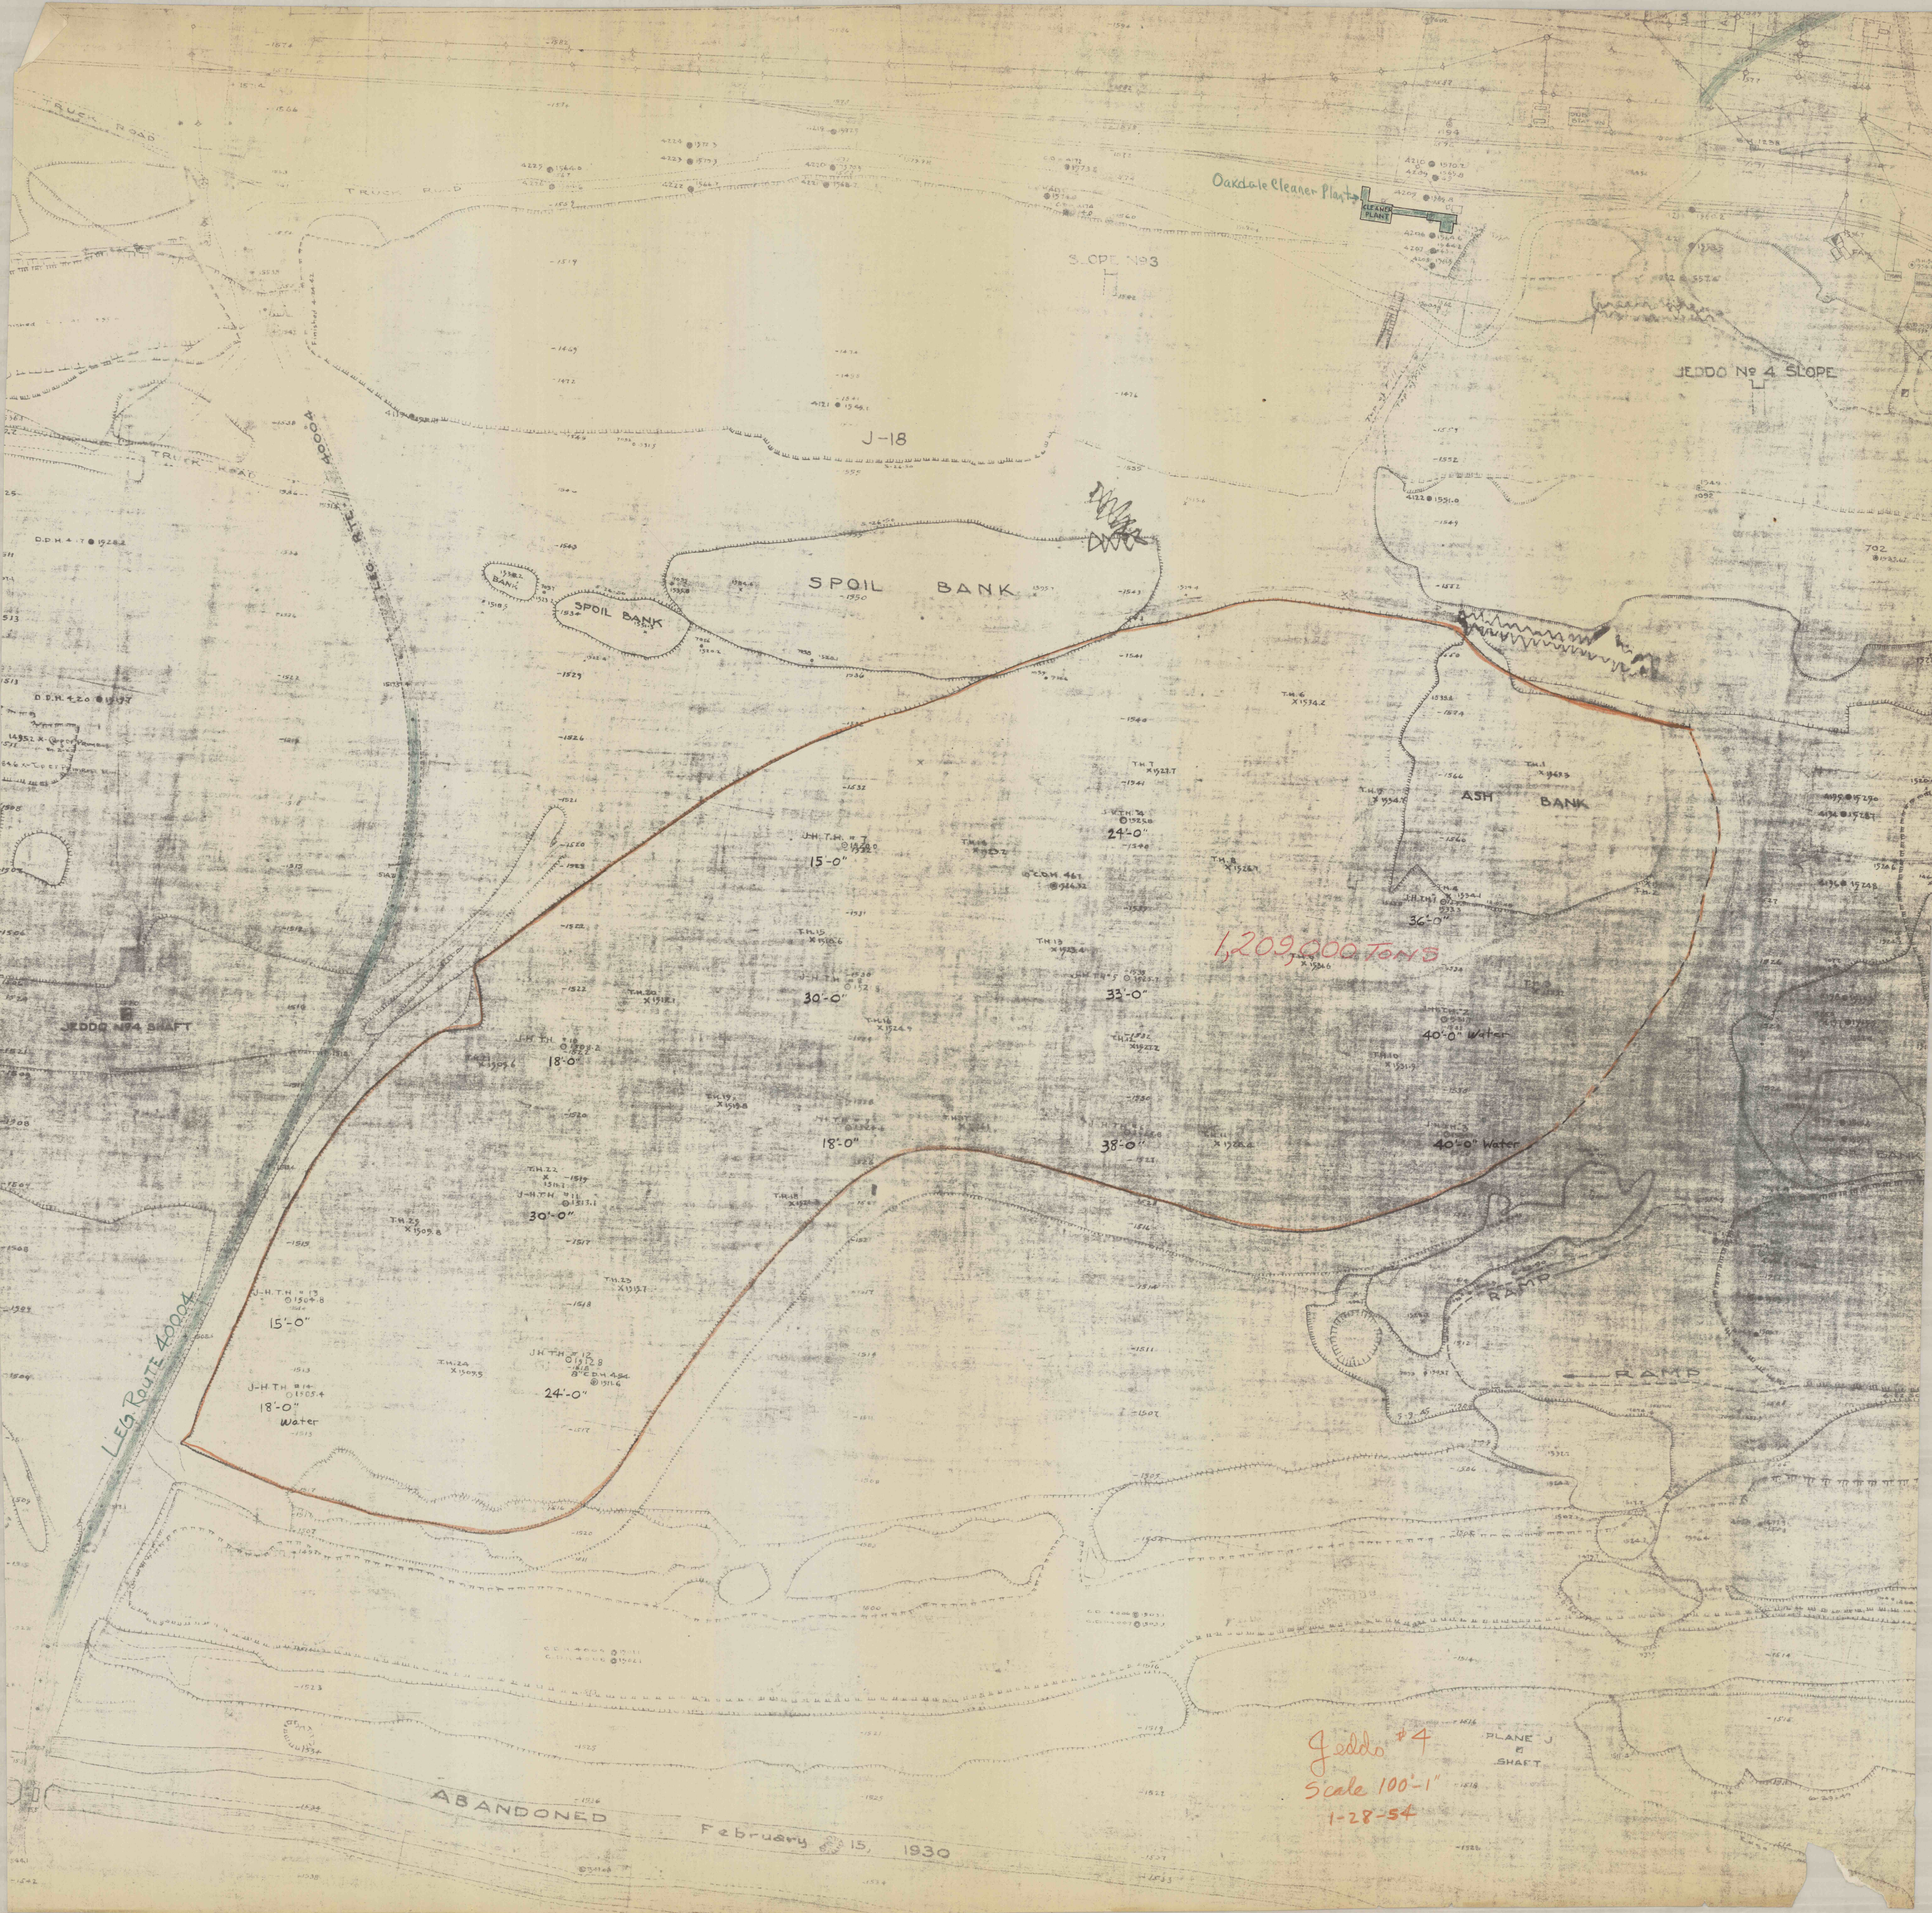

Oakdale Cleaner Plant

SLOPE N° 3

JEDDO N° 4 SLOPE

J-18

SPOIL BANK

ASH BANK

1,209,000 TONS

40'-0" Water

40'-0" Water

RAMP

RAMP

Jeddo #4
Scale 100'-1"
1-28-54

ABANDONED

February 15, 1930