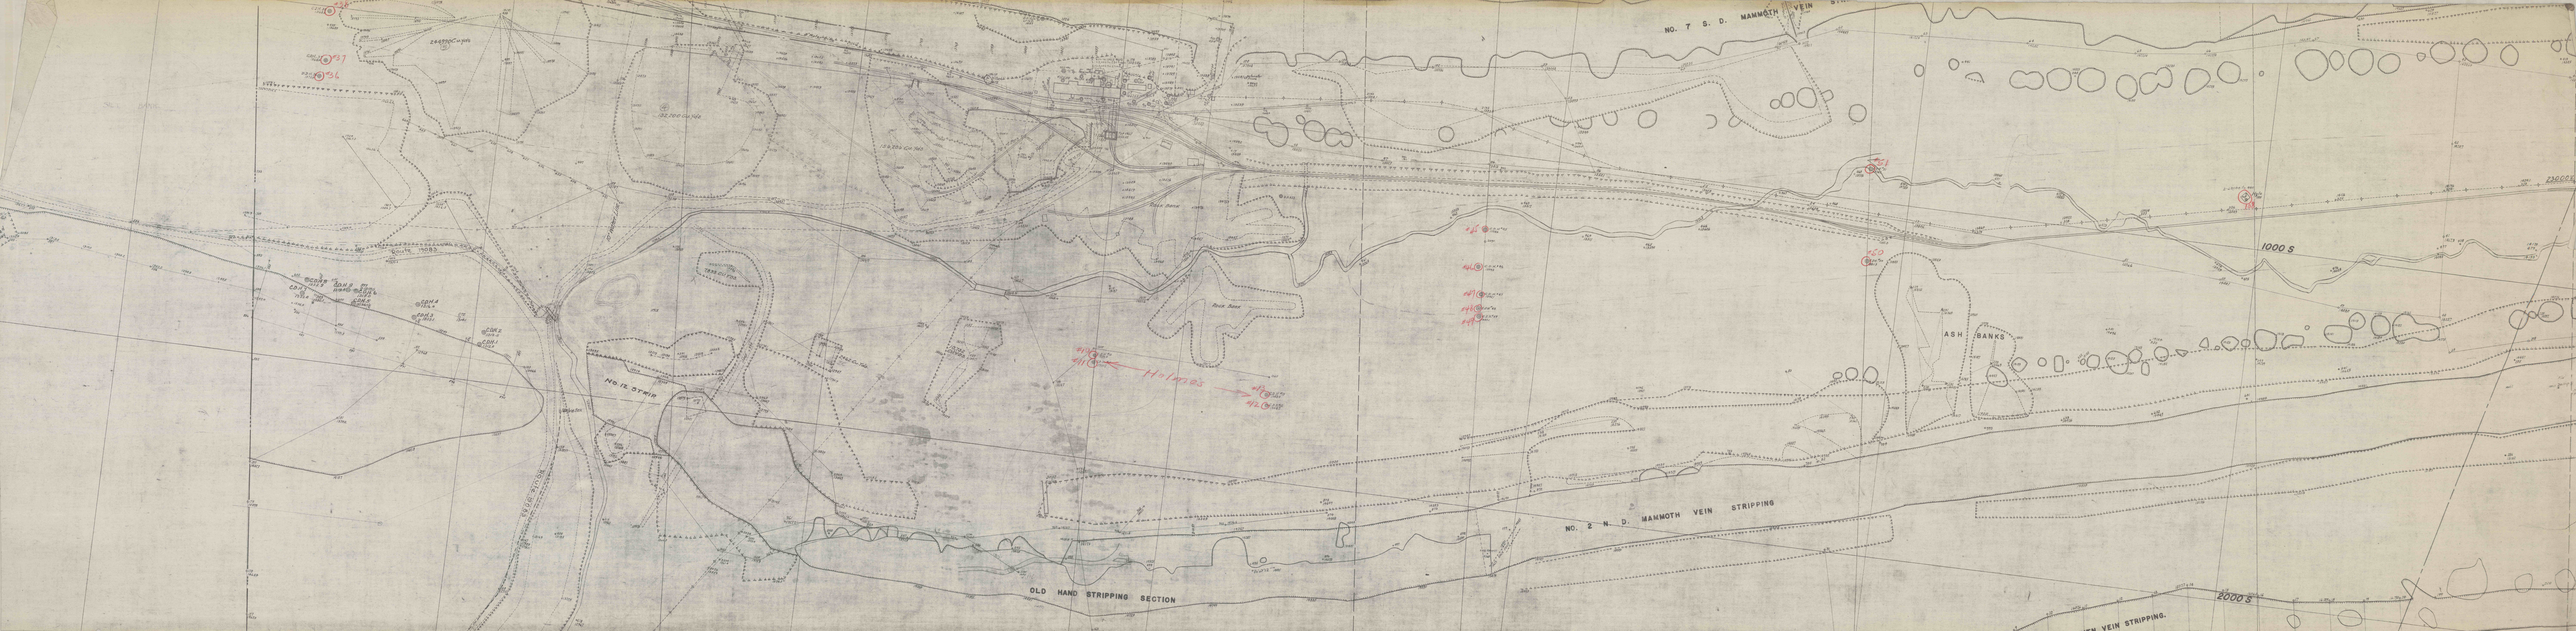
NO. 7 S. D. MAMMOTH VEIN
1000 S
ASH BANKS
NO. 2 N. D. MAMMOTH VEIN STRIPPING
OLD HAND STRIPPING SECTION
2000 S
N. 15 STRIP
H=1470.23