


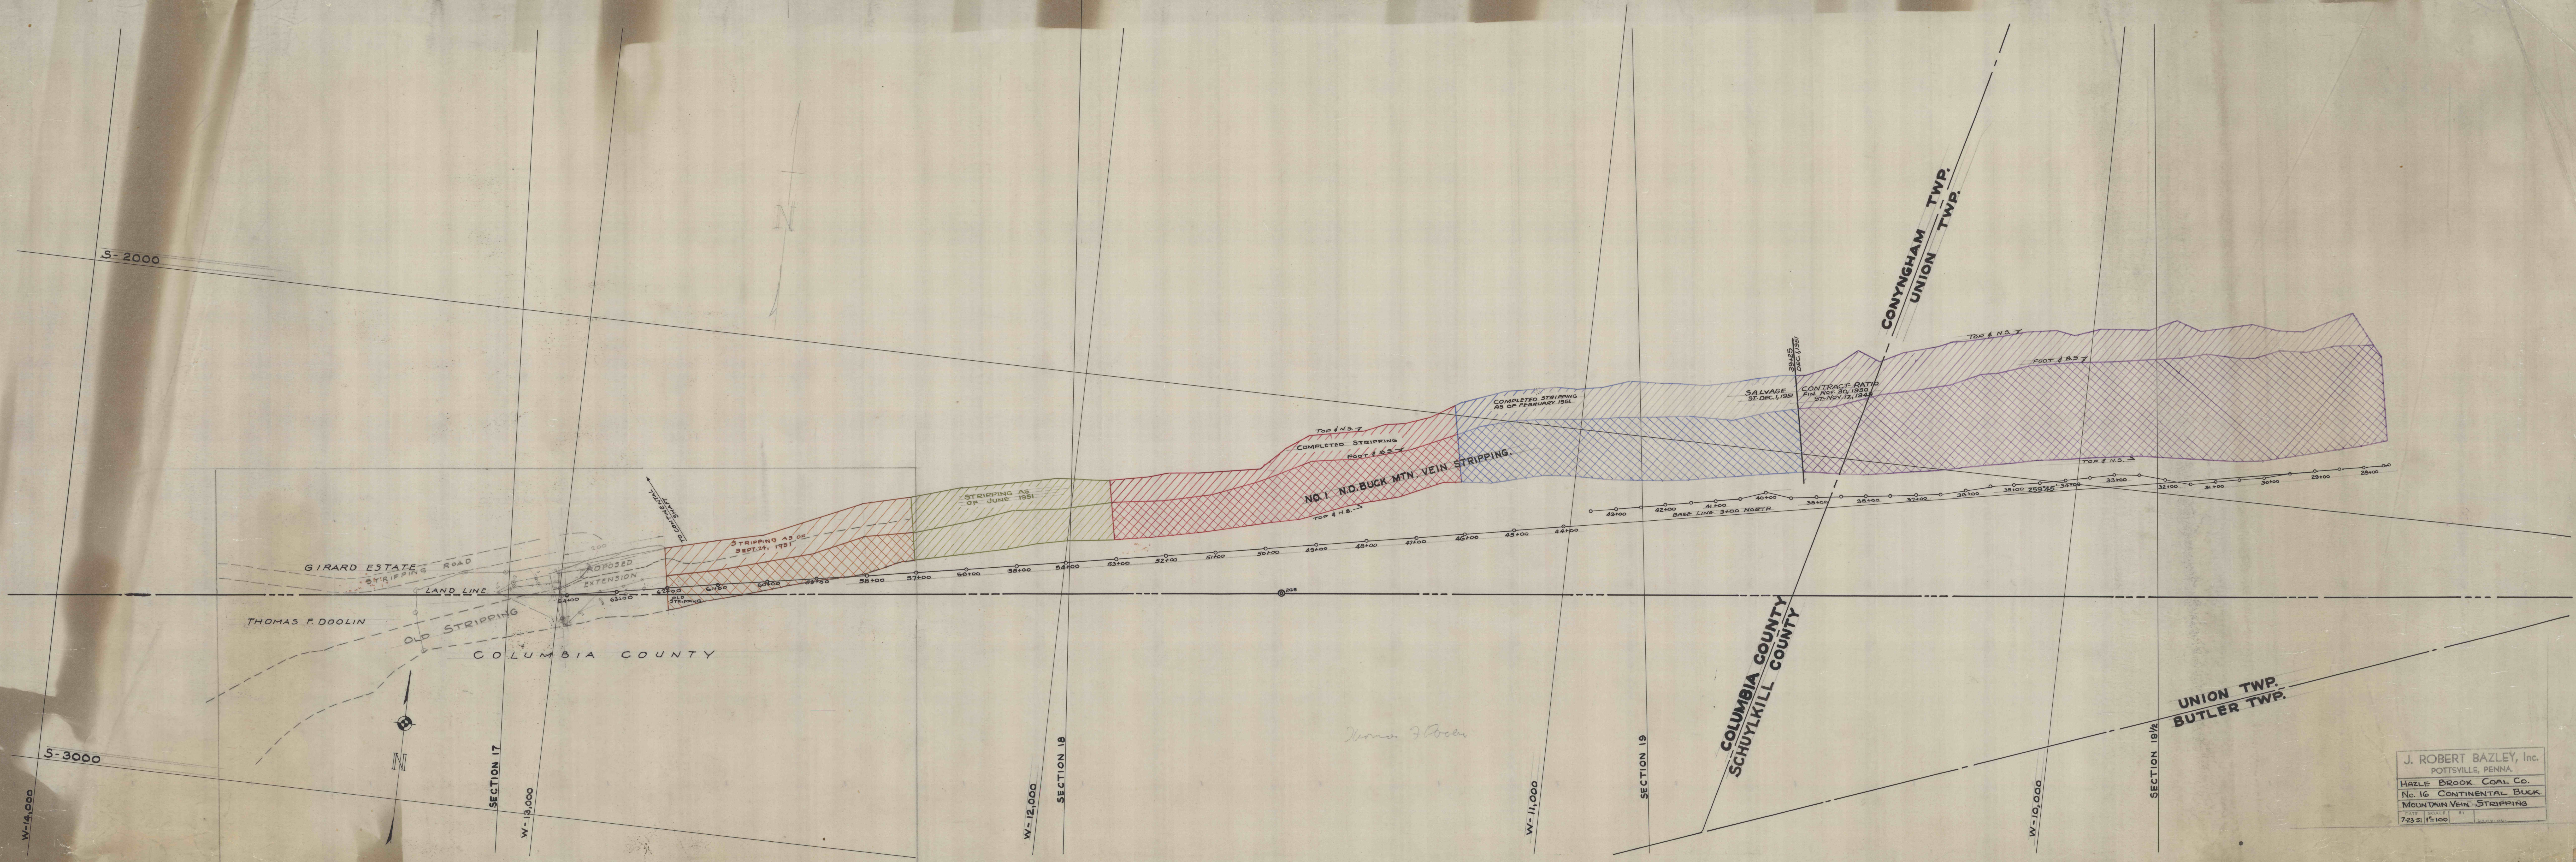

J. ROBERT BAZLEY, Inc.
POTTSVILLE, PENNA.
HAZLE BROOK COAL CO.
No. 16 CONTINENTAL BUCK
MOUNTAIN VEIN STRIPPING
7-23-51 1"=100'