


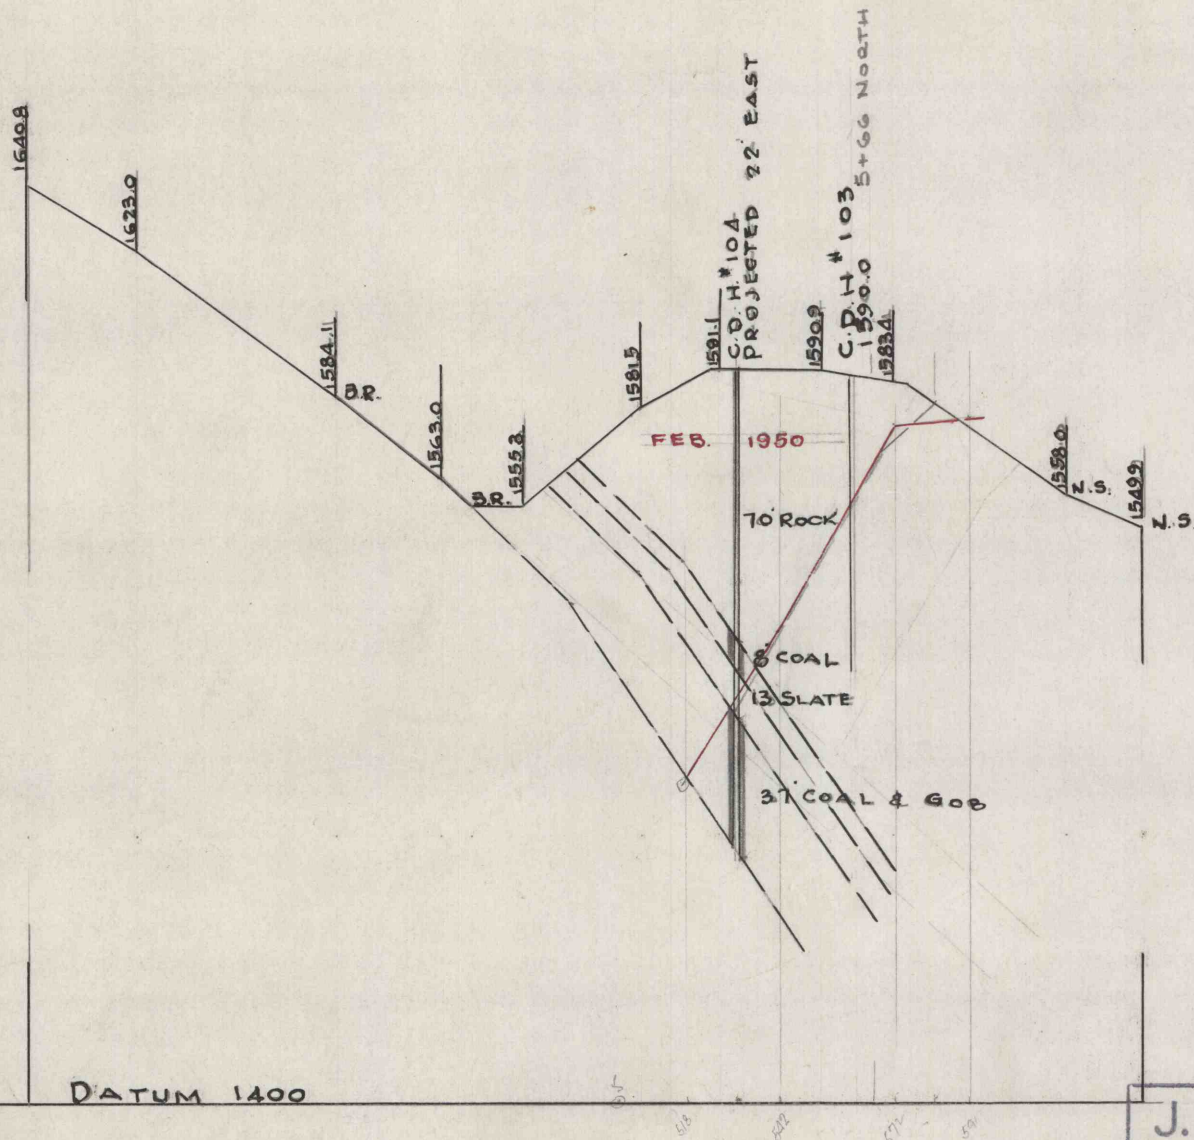

J. ROBERT BAZLEY, Inc.
POTTSVILLE, PENNA.

CONTINENTAL COLLIERY
BUCK MOUNTAIN STRIPPING
SECTION 44+50

DATE	SCALE	BY
6-20-50	1"=50'	C.W.M.

G-20