


344

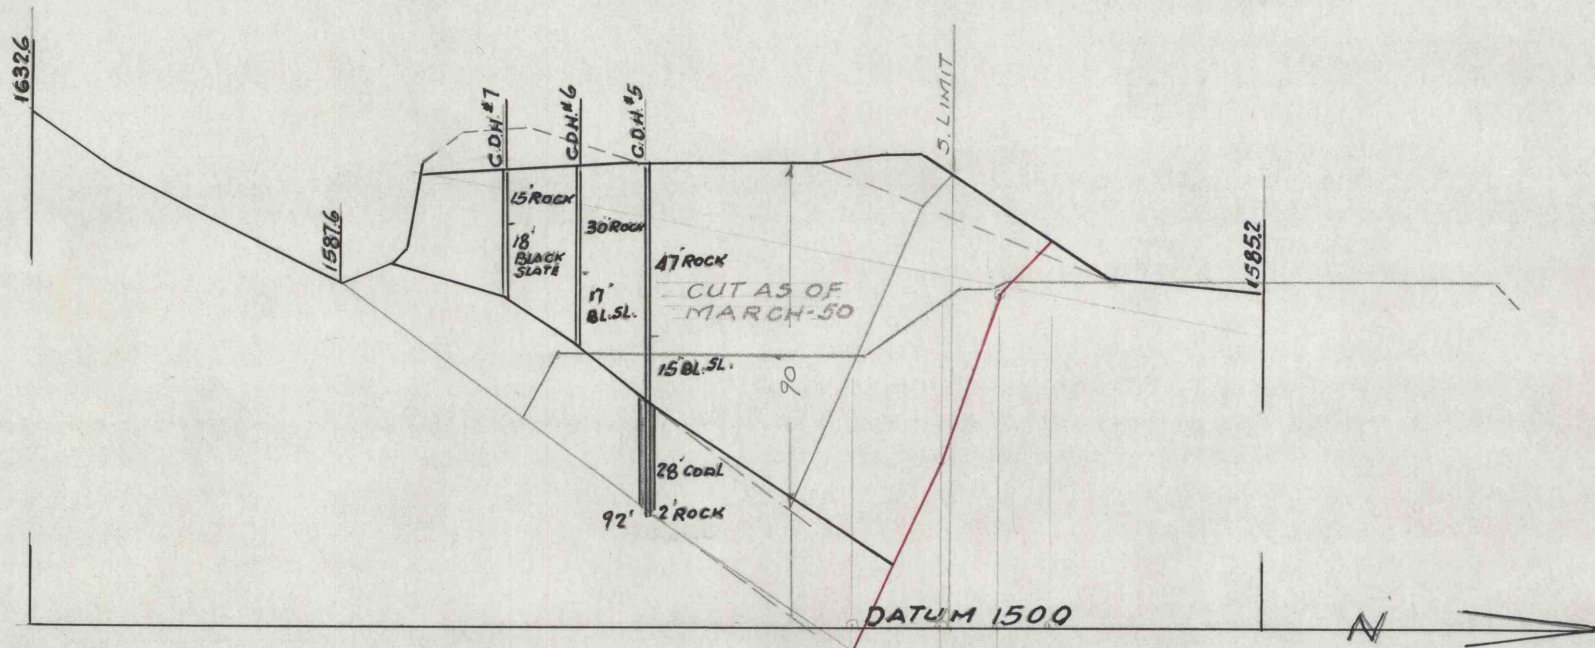

J. ROBERT BAZLEY, Inc.
POTTSVILLE, PENNA.

CONTINENTAL COLLY. BUCK MT.
VEIN STRIPPING PROVING
HOLES ON SECTION 28+50

DATE 11/24/49	SCALE 1" = 50'	BY D. R. G. INC.	Q-20
------------------	-------------------	---------------------	------