


THOMAS T. DOOLIN

GIRARD ESTATE

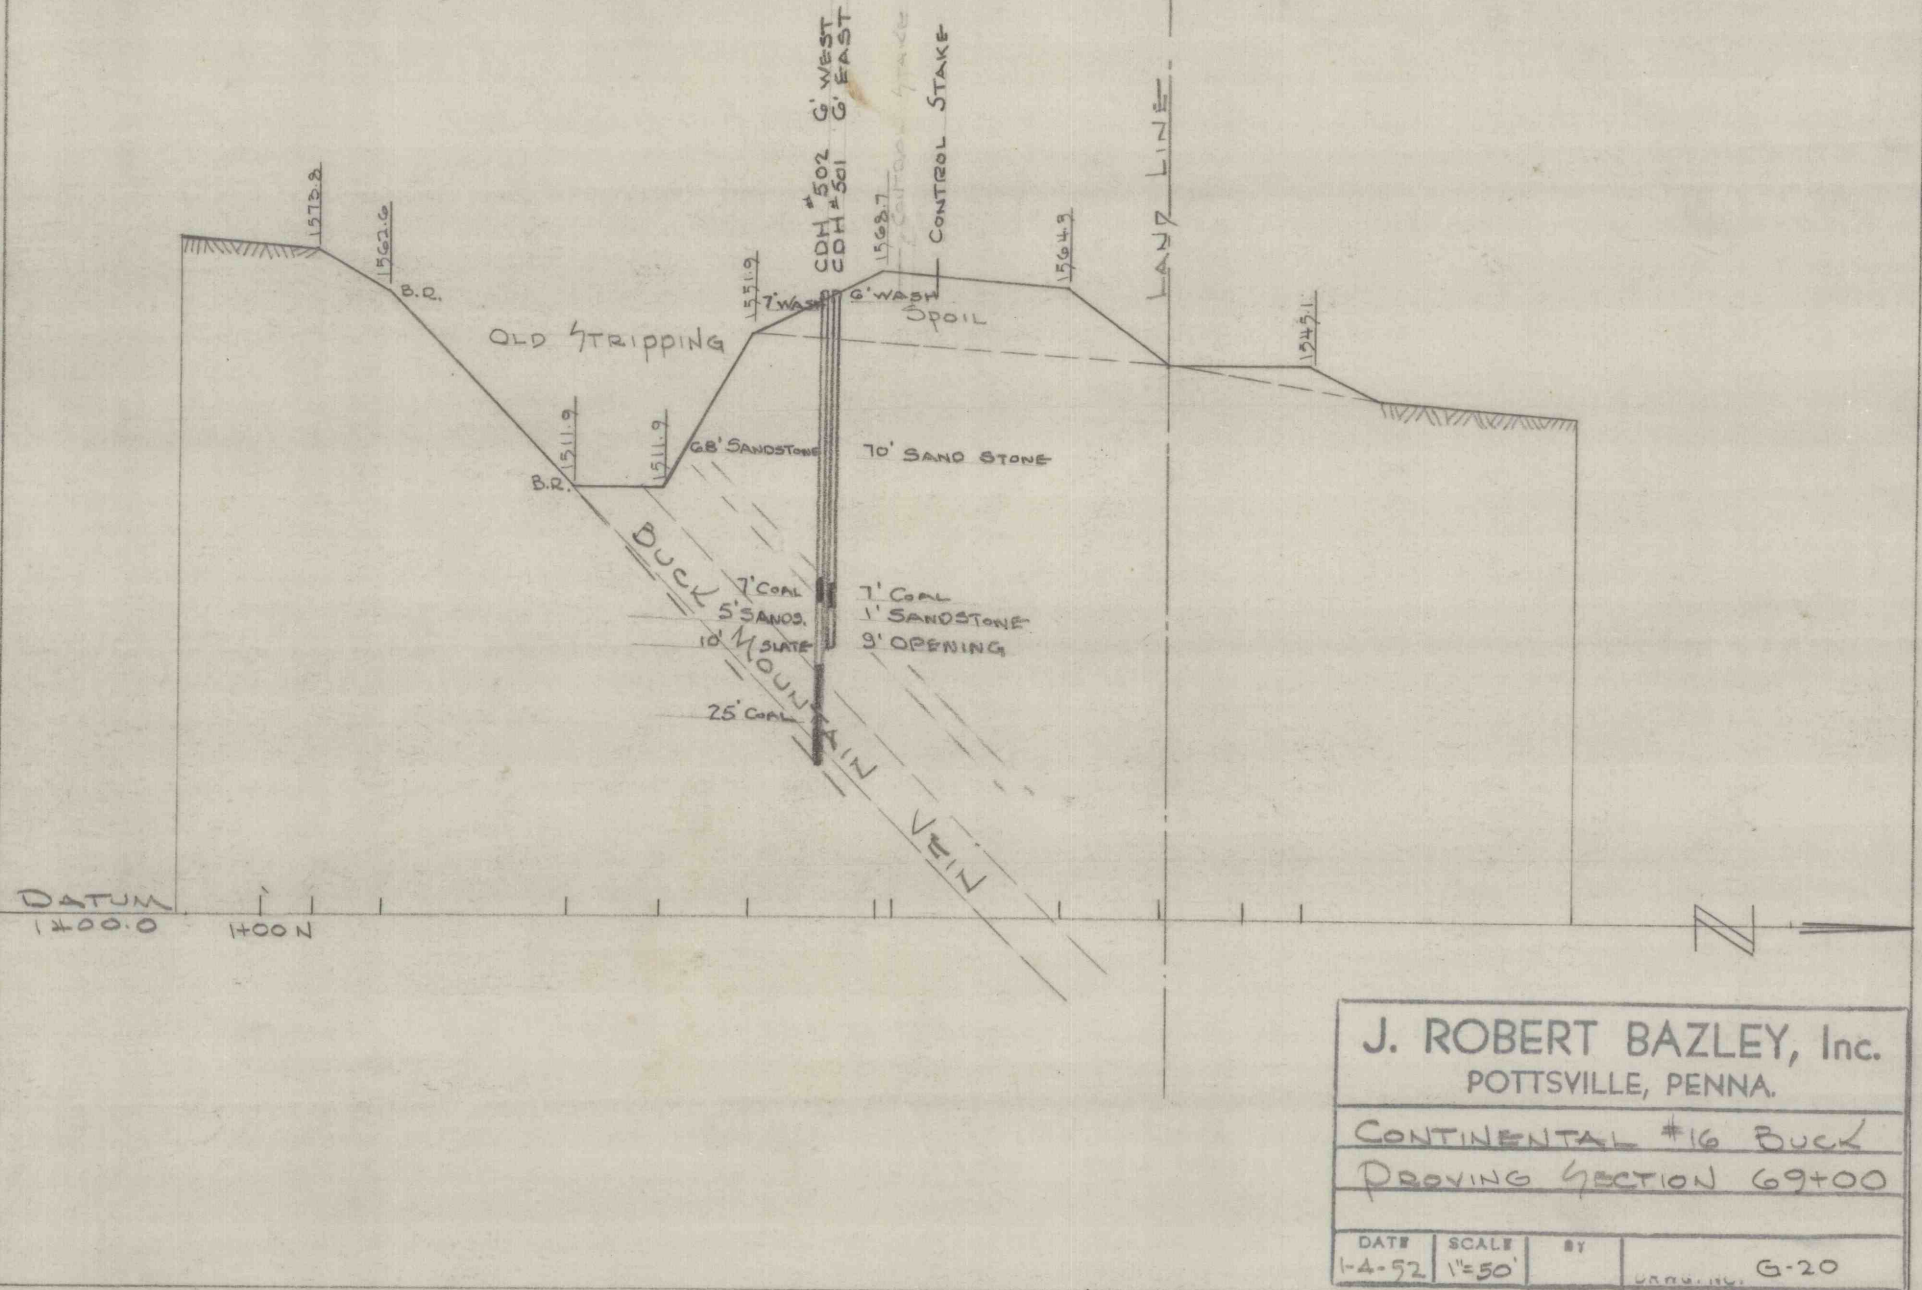

J. ROBERT BAZLEY, Inc.
POTTSVILLE, PENNA.

CONTINENTAL #16 BUCK
PROVING SECTION 69+00

DATE	SCALE	BY	DATE
1-4-52	1"=50'	J. ROBERT BAZLEY, Inc.	G-20

TO GWY 1236.9