


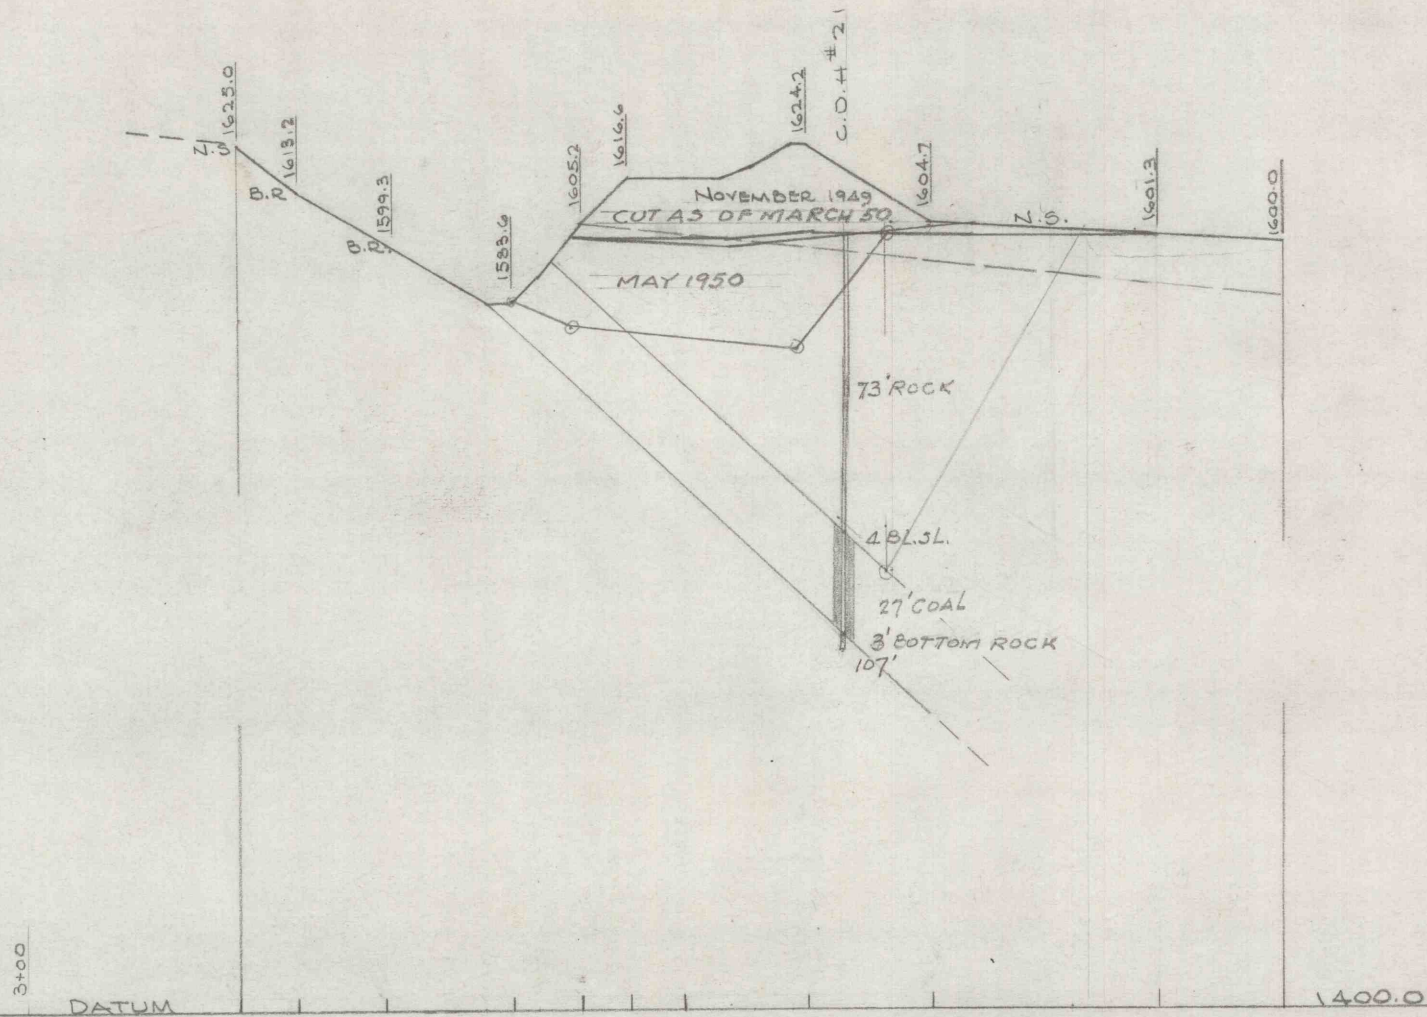

J. ROBERT BAZLEY, Inc.			
POTTSVILLE, PENNA.			
CONTINENTAL COLLIERY			
BUCK MOUNTAIN STRIPPING			
SECTION 37+00			
DATE	SCALE	BY	
12-10-49	1"=50'	C.W.M.	G-20