


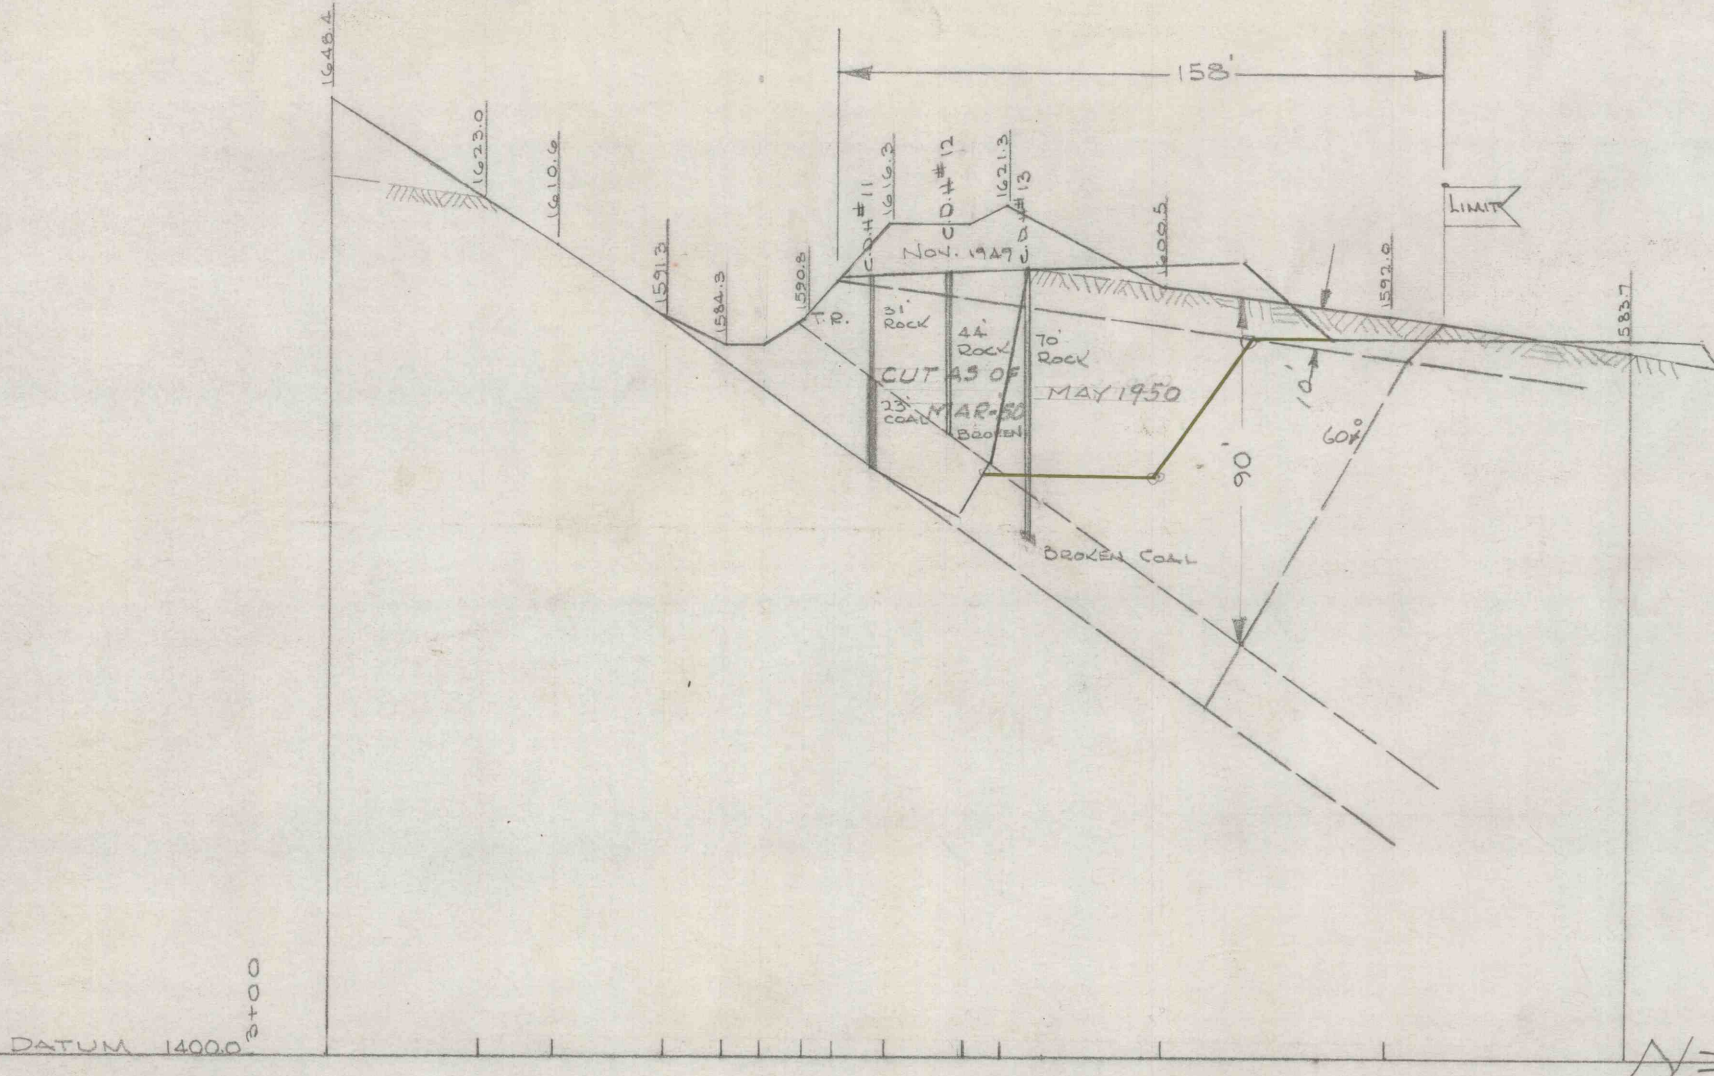

J. ROBERT BAZLEY, Inc.
POTTSVILLE, PENNA.

CONTINENTAL COLLY BUCK MTN
VEIN STRIPPING. PROVING
HOLES ON SECTION 34+00

DATE	SCALE	BY
12-1-49	1"=50'	G.W.M.

DRG. INC.