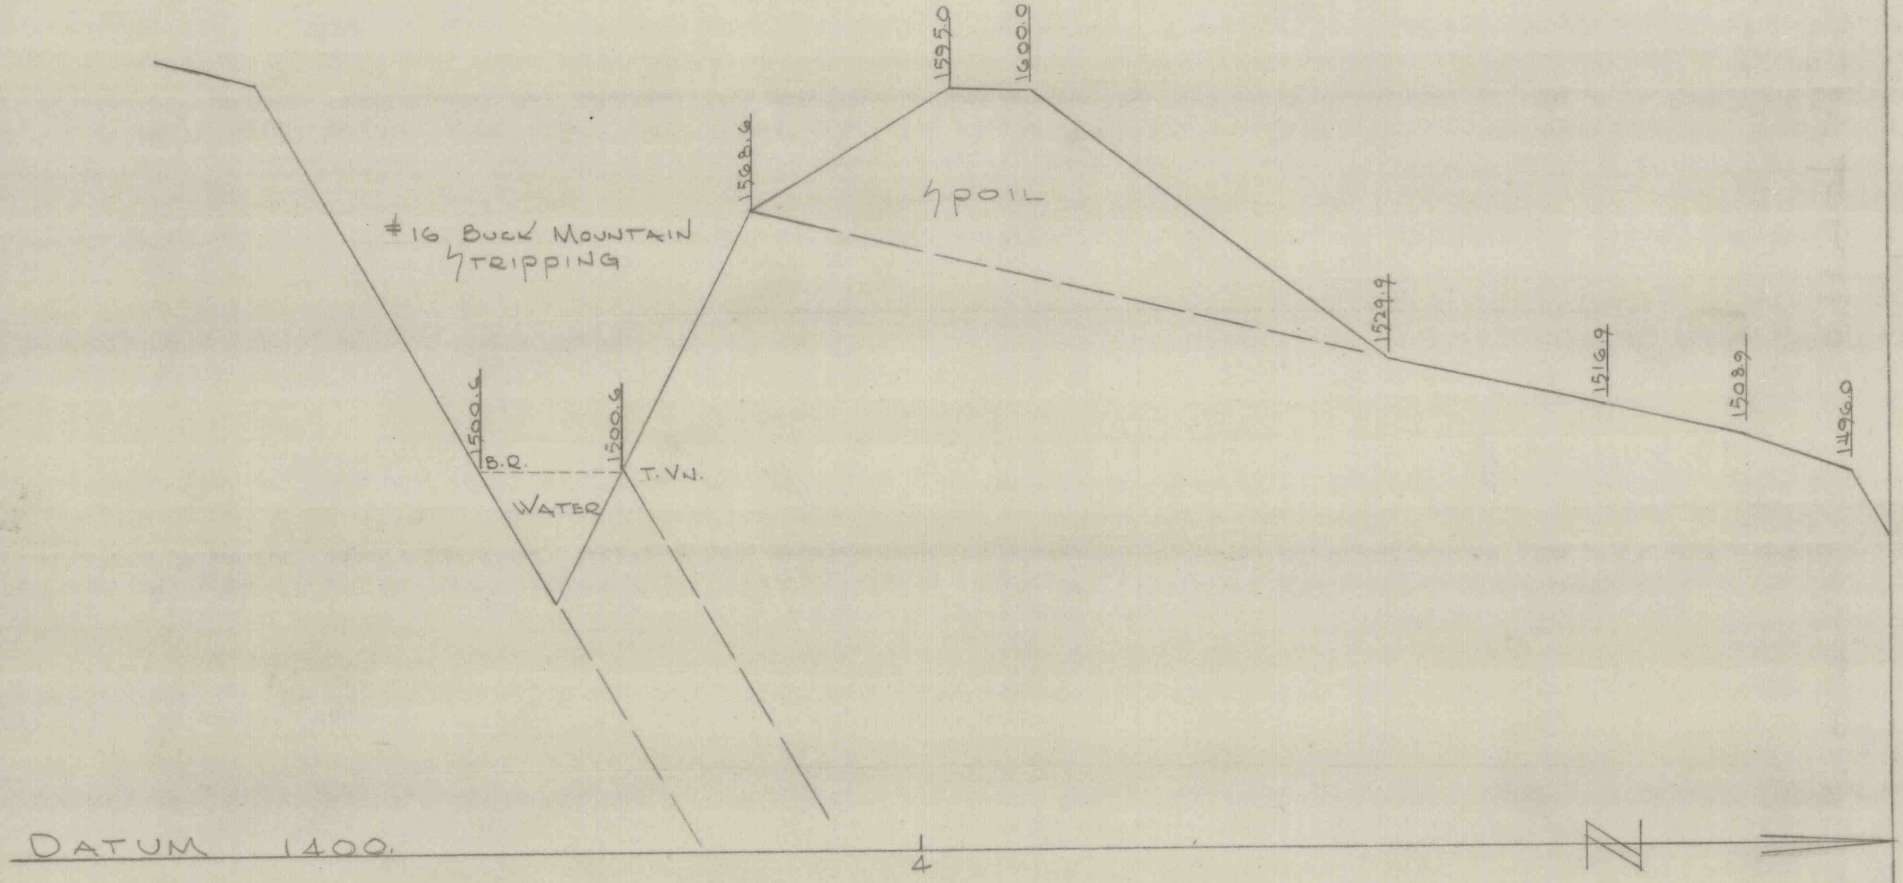

J. ROBERT BAZLEY, Inc. POTTSVILLE, PENNA.			
CONTINENTAL #16 BUCK			
MOUNTAIN VEIN STRIPPING			
SECTION 65+50			
DATE 1-30-52	SCALE 1"=50	BY C.V.M.	DRAWING: