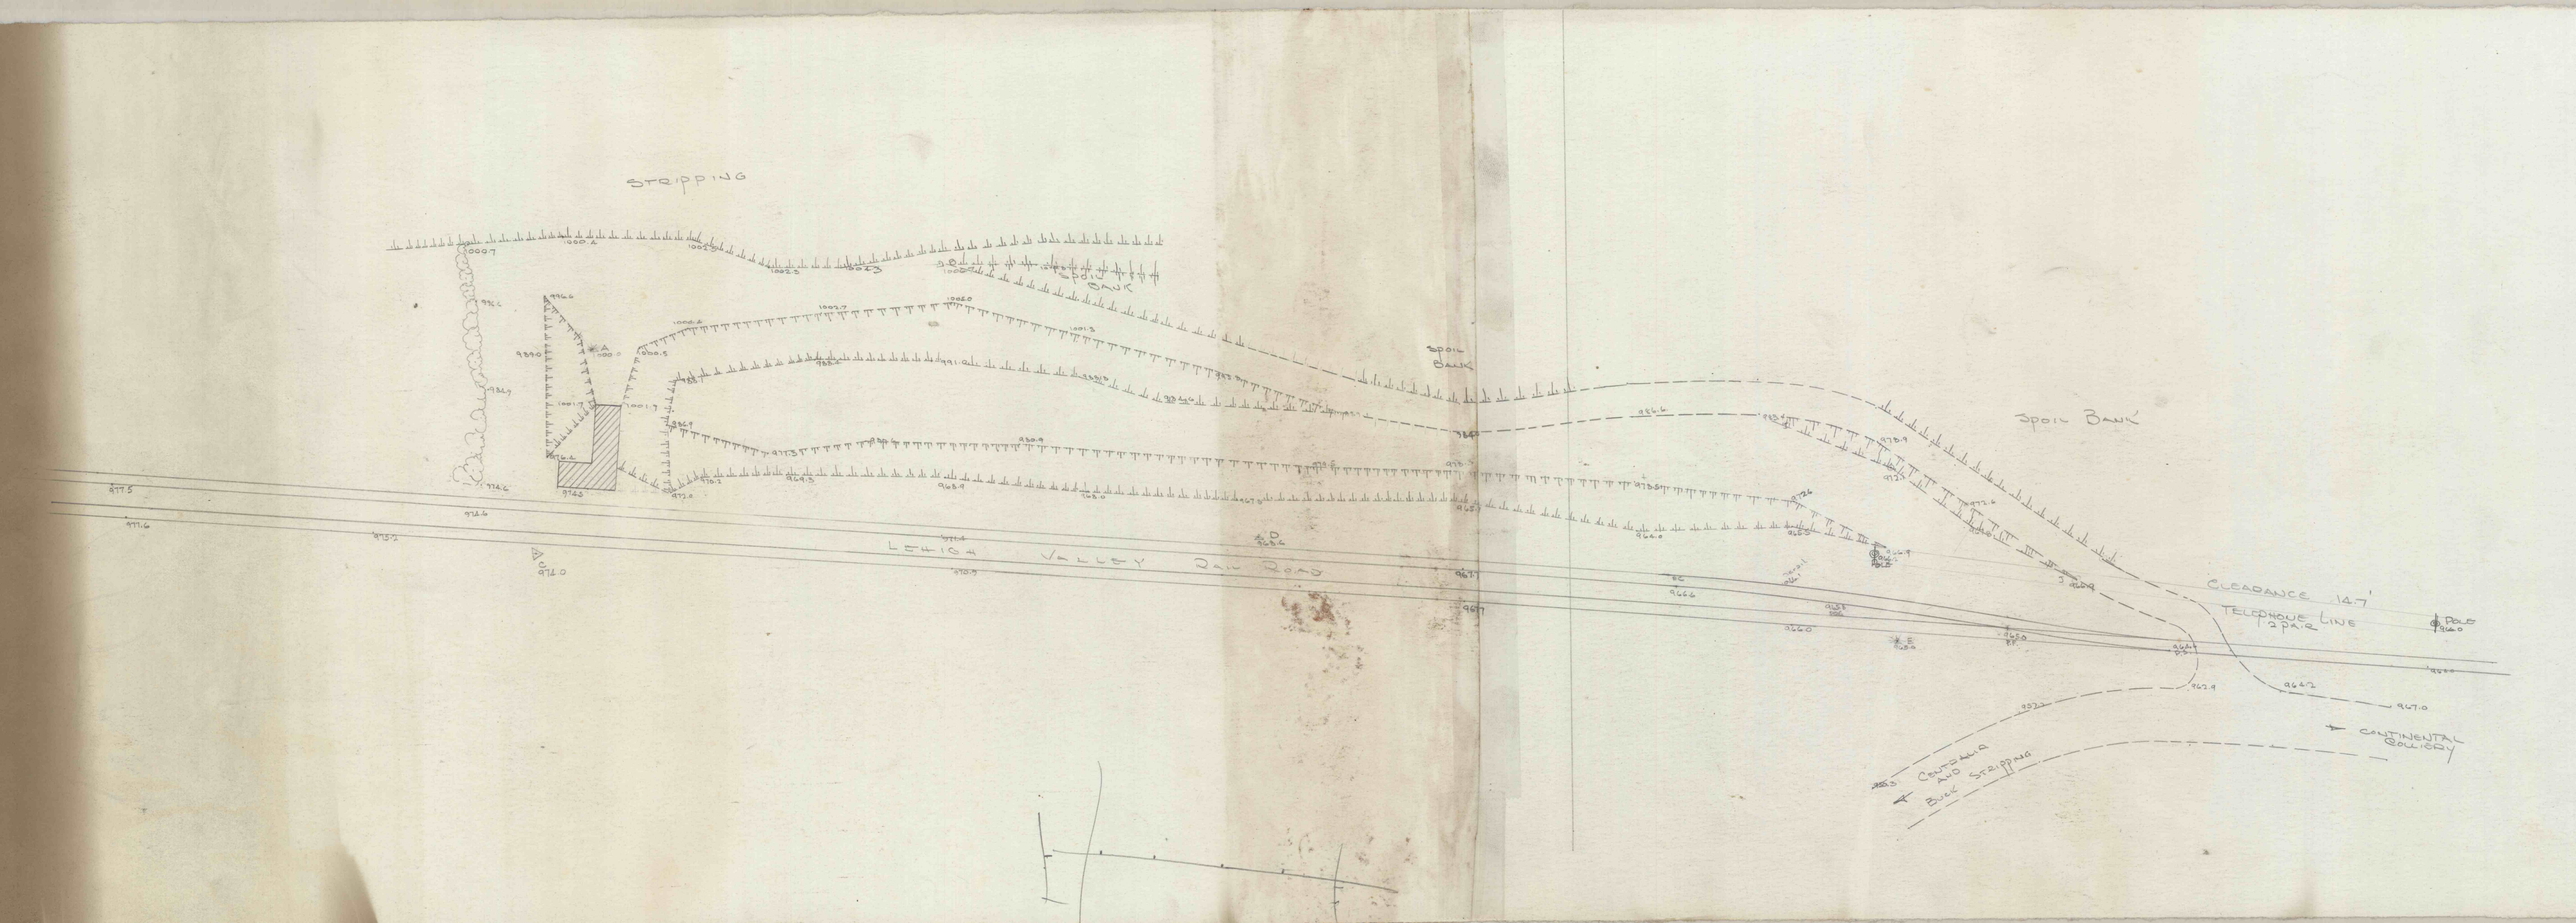
STRIPPING
SPOIL BANK
SPOIL BANK
SPOIL BANK
CLEARANCE 14.7'
TELEPHONE LINE 2 PAIR
CONTINENTAL COLLIERY
