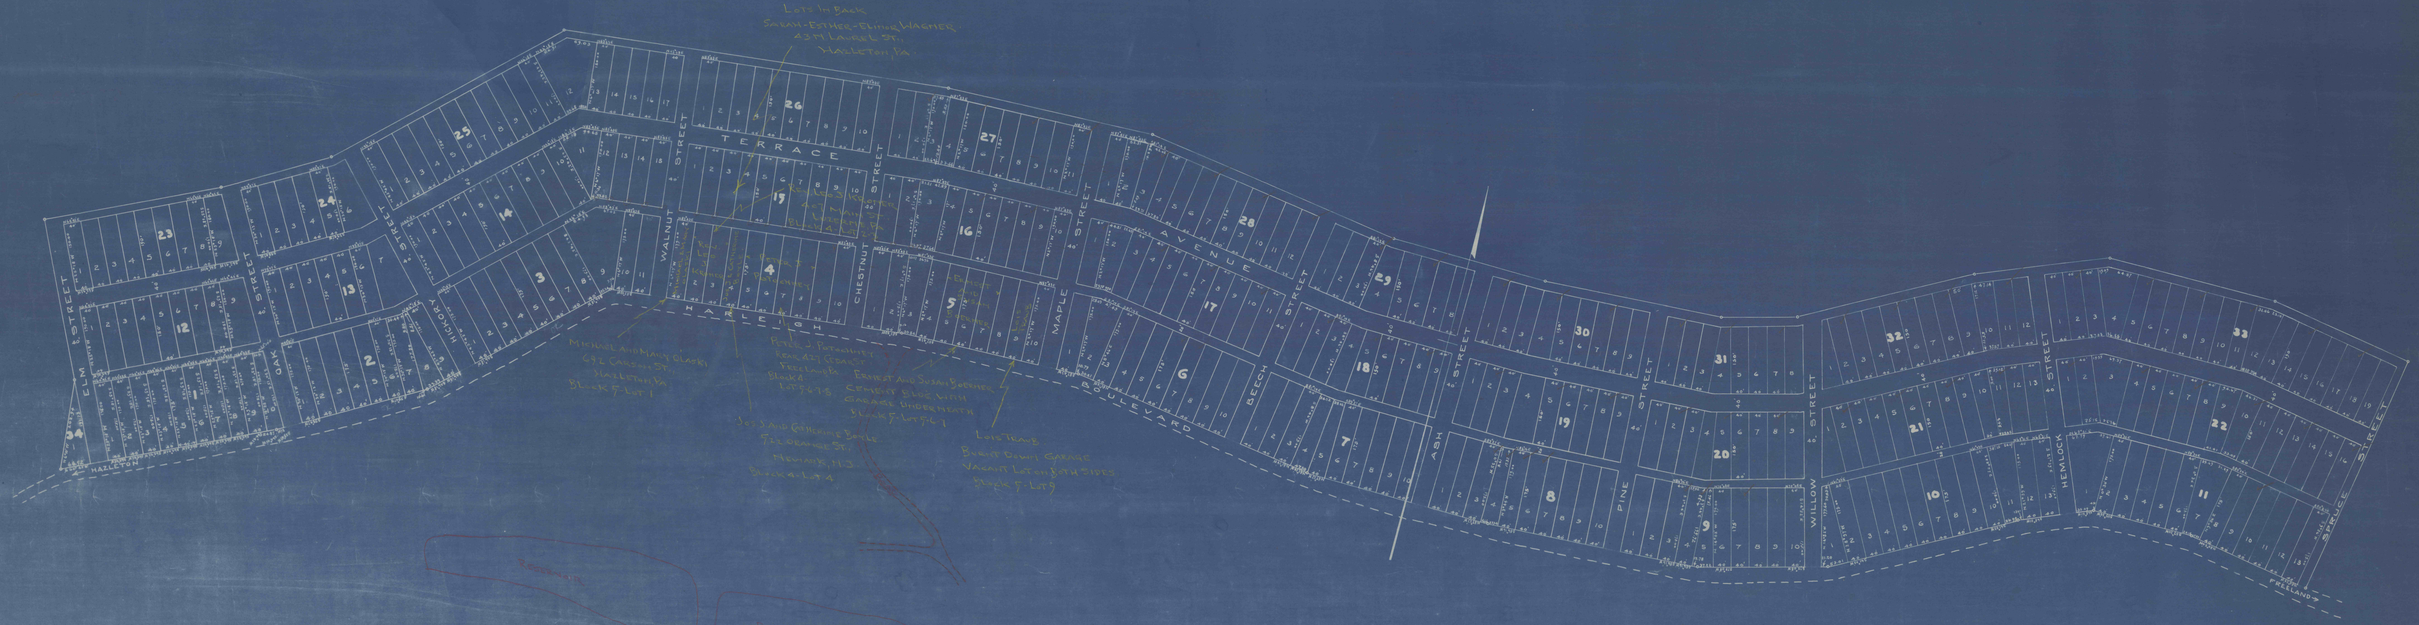


# LOT PLAN
OF
## HARLEIGH TERRACE
PROPERTY OF
## HARLEIGH LAND CO.
HAZLE TWP, LUZERNE CO., PA.
MARCH 1925 SCALE 1"=100'