



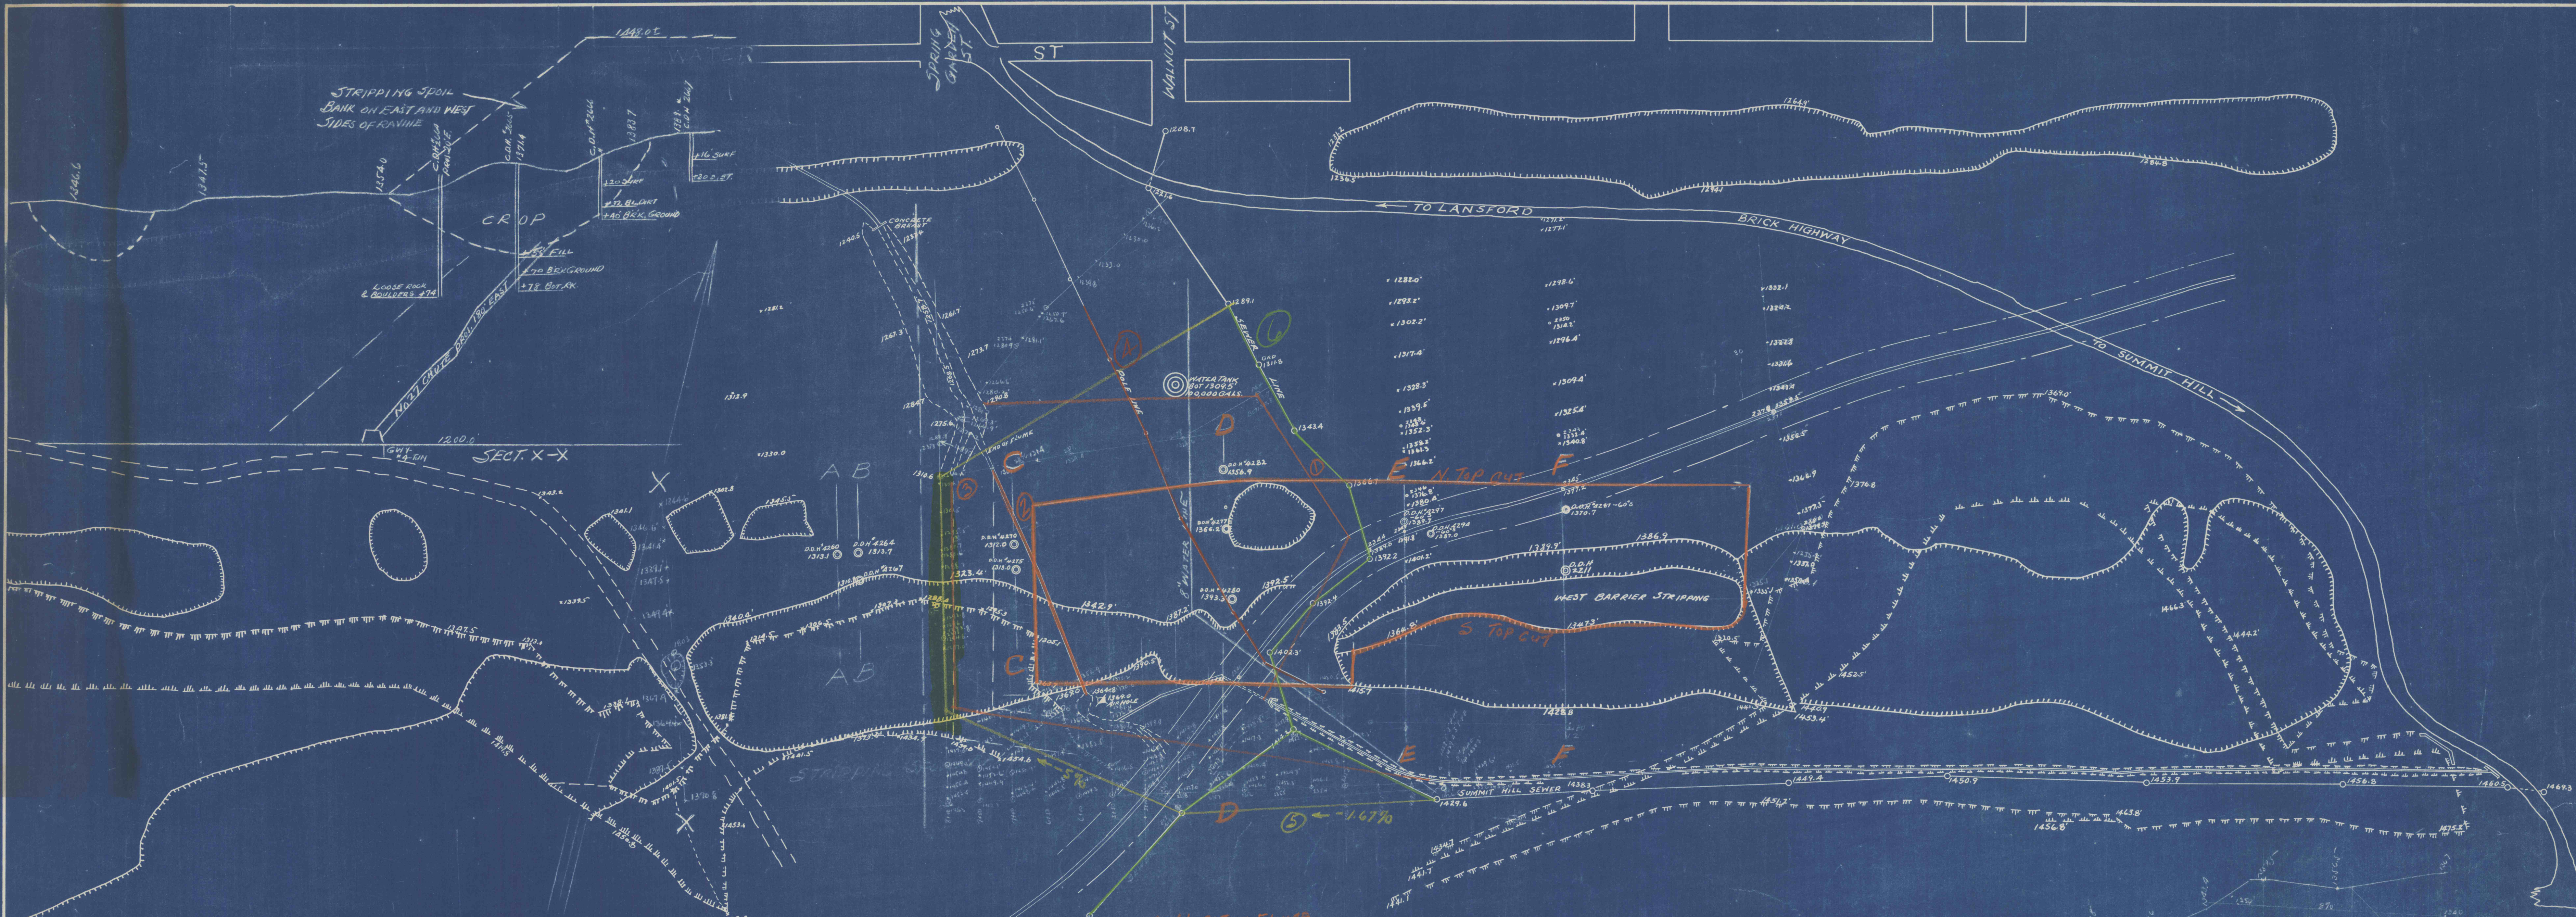

- ① TEMPORARY LOCATION FLUME
 - ② REMAINS PRESENT
 - ③ FINAL LOCATION
 - ④ PRESENT LOCATION IN CHANNEL TEL. IN LINE (FINAL LOCATION ON FILL)
 - ⑤ RELOCATION SEWER LINE
 - ⑥ PRESENT LOCATION SEWER LINE
- FILL & GRADING FOR SEWER LINE, FLUME & UTILITY

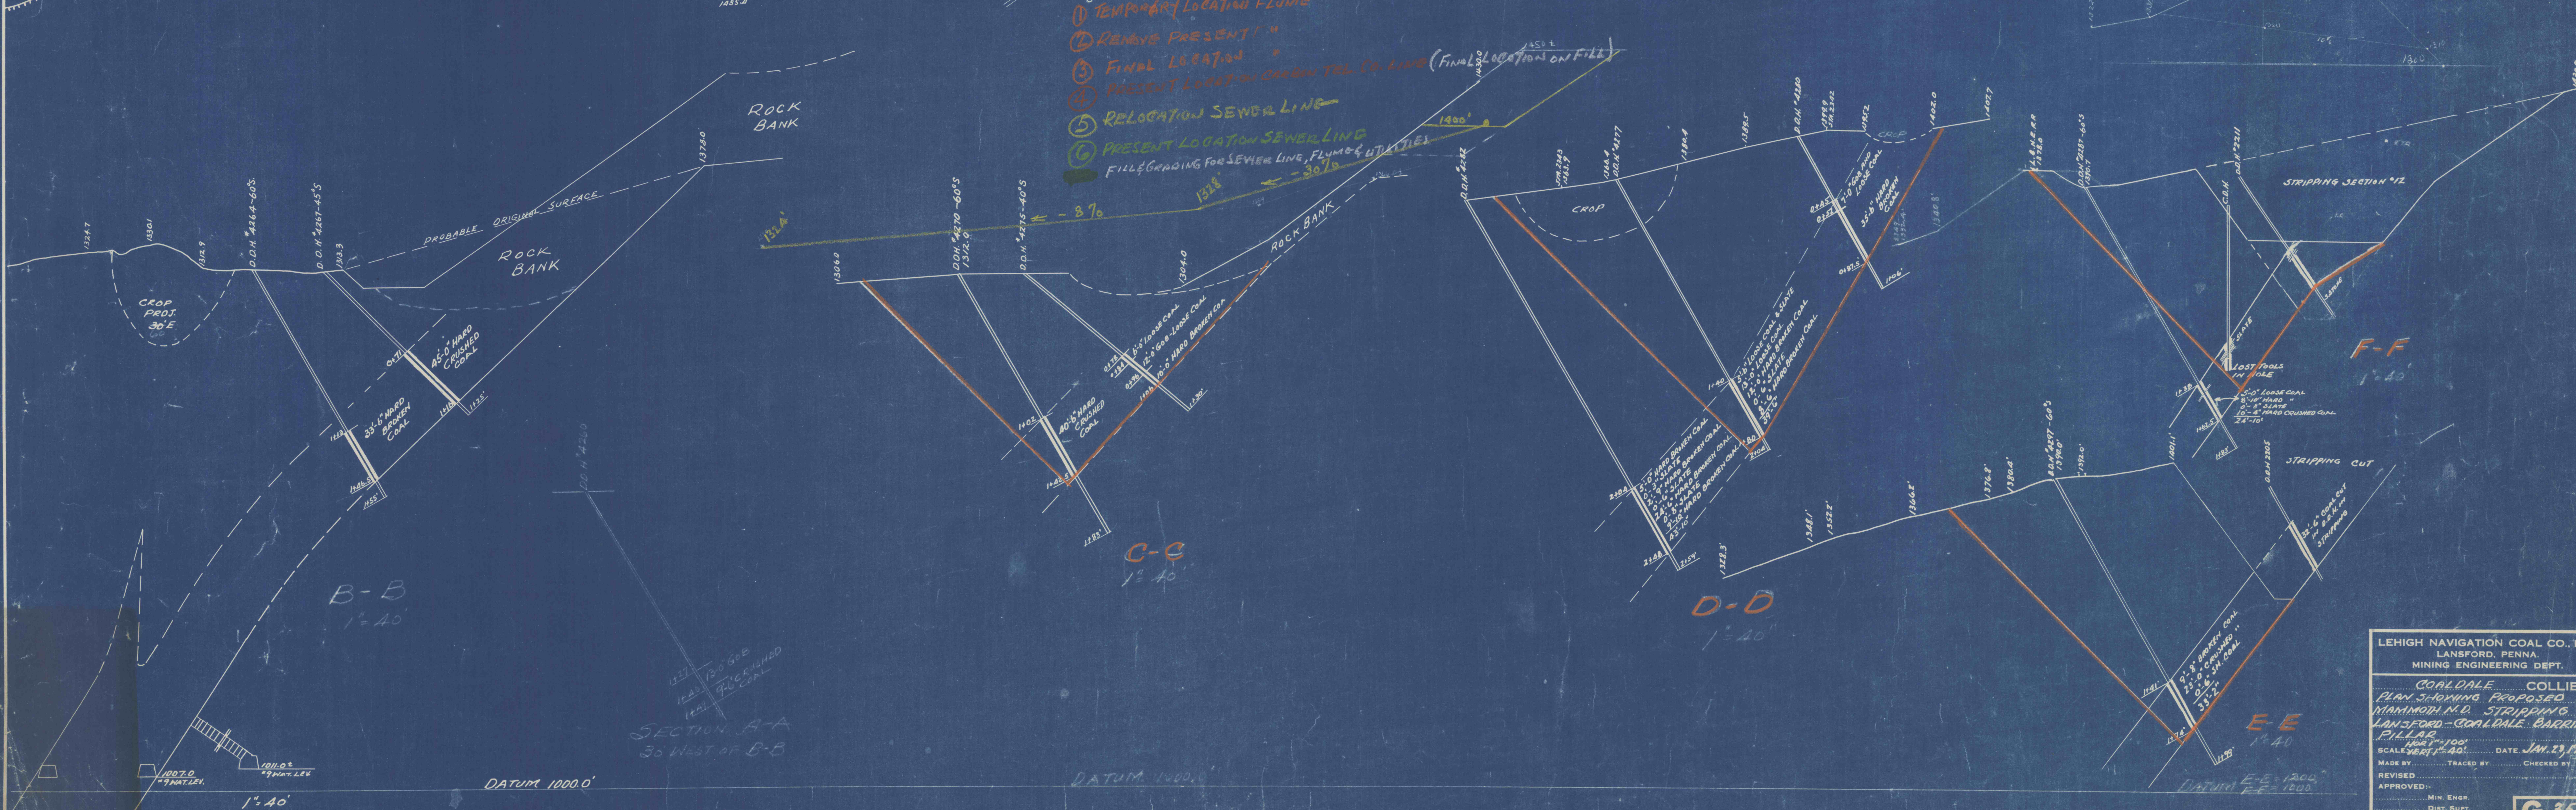

LEHIGH NAVIGATION COAL CO., INC.
LANSFORD, PENNA.
MINING ENGINEERING DEPT.

COAL DALE COLLIERY
PLAN SHOWING PROPOSED
LANSFORD - COAL DALE BARRIER
FILLAR
SCALE 1"=40' DATE JAN. 23, 1951

MADE BY: TRACED BY: CHECKED BY:
REVISOR: MIN. ENGR. DIST. SURT. GEN. MGR.

APPROVED: G 357