


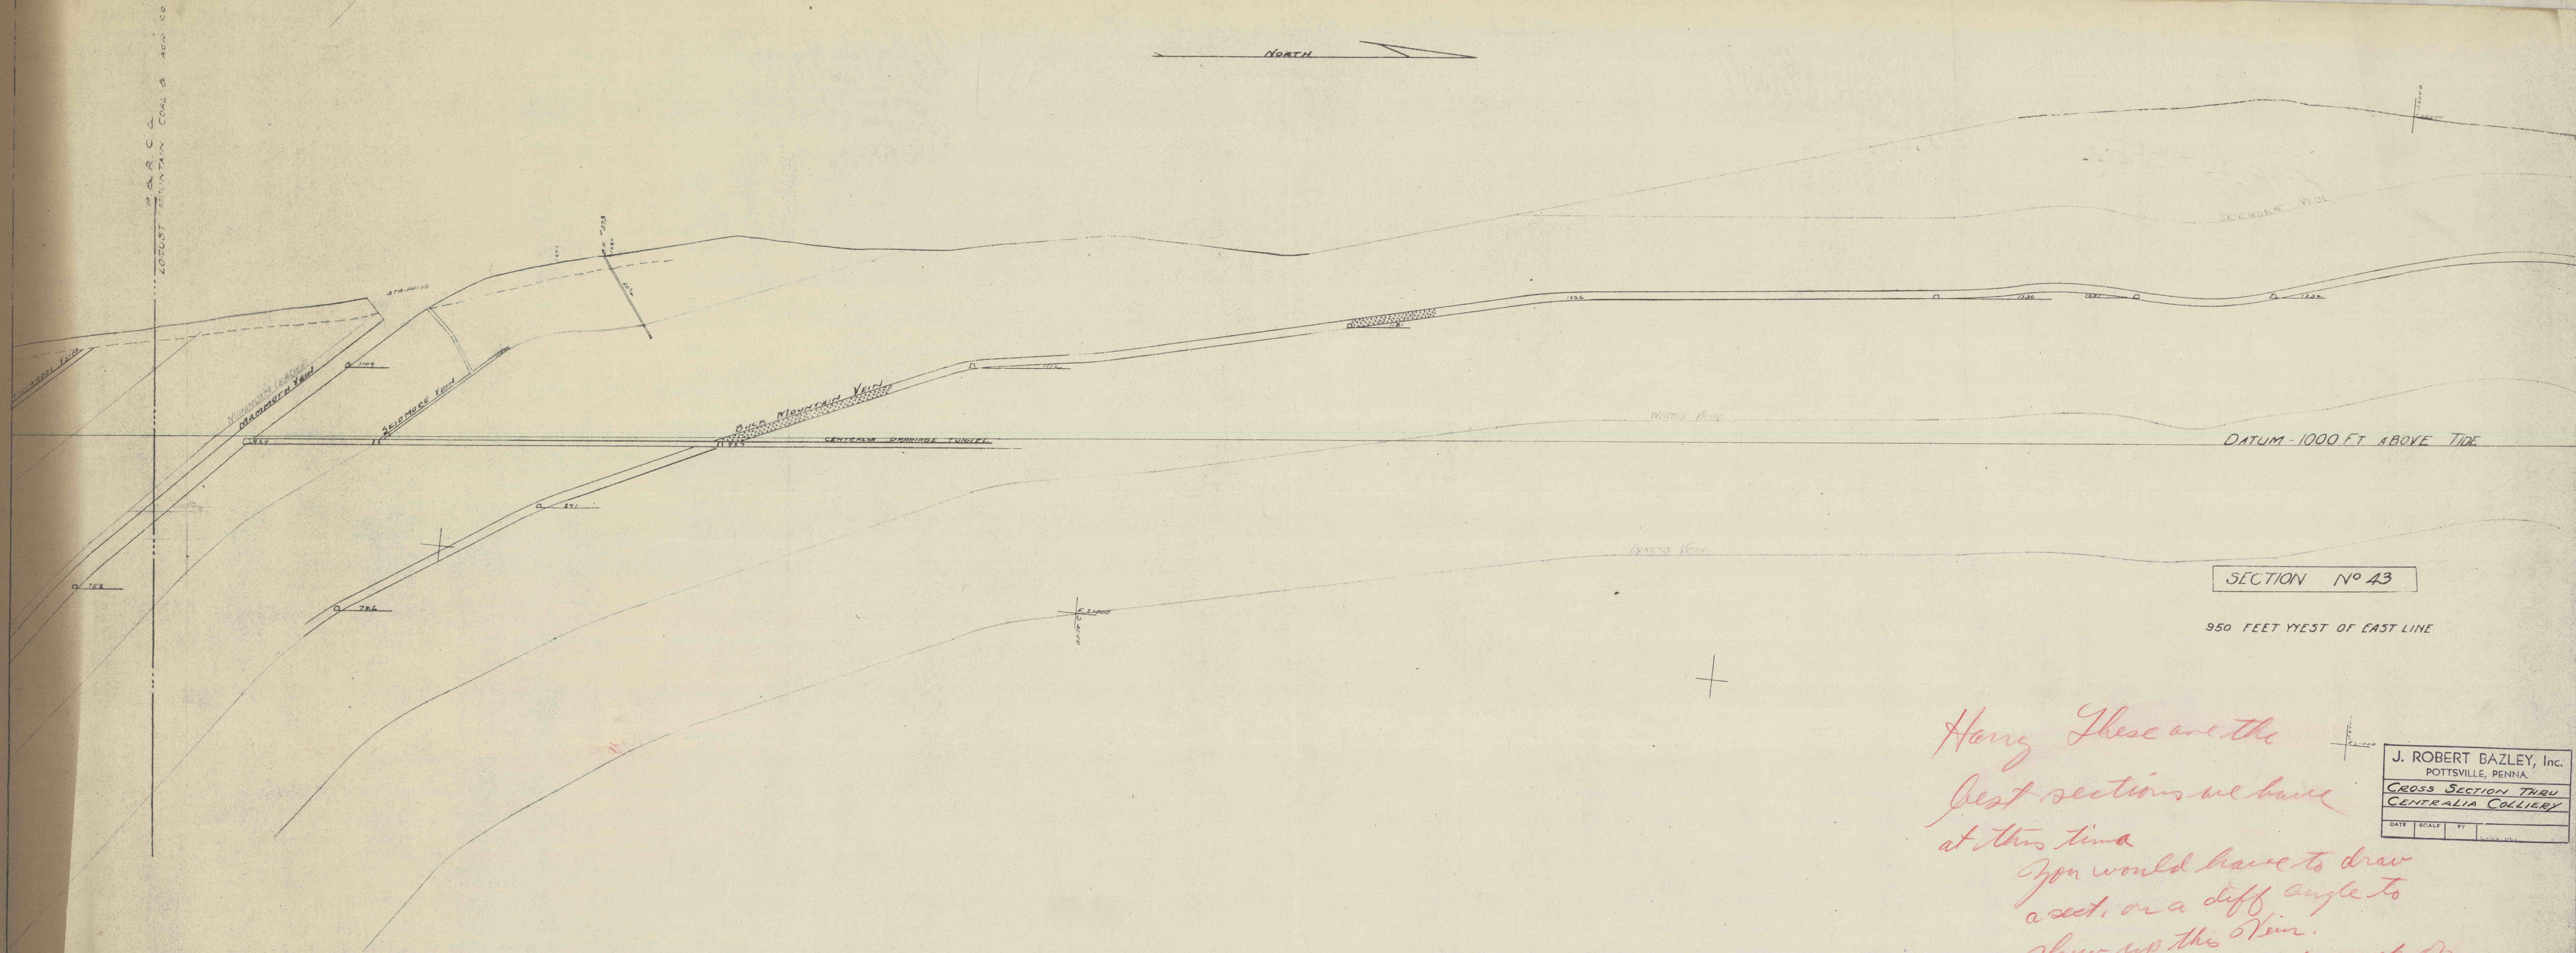

SECTION No 43

950 FEET WEST OF EAST LINE

Harry These are the
best sections we have
at this time

You would have to draw
a sect. on a diff angle to
show up this vein.
If you are not in too much of
a hurry let me know and I
will have some made for you

J. ROBERT BAZLEY, Inc.		
POTTSVILLE, PENNA.		
CROSS SECTION THRU		
CENTRALIA COLLIERY		
DATE	SCALE	BY