


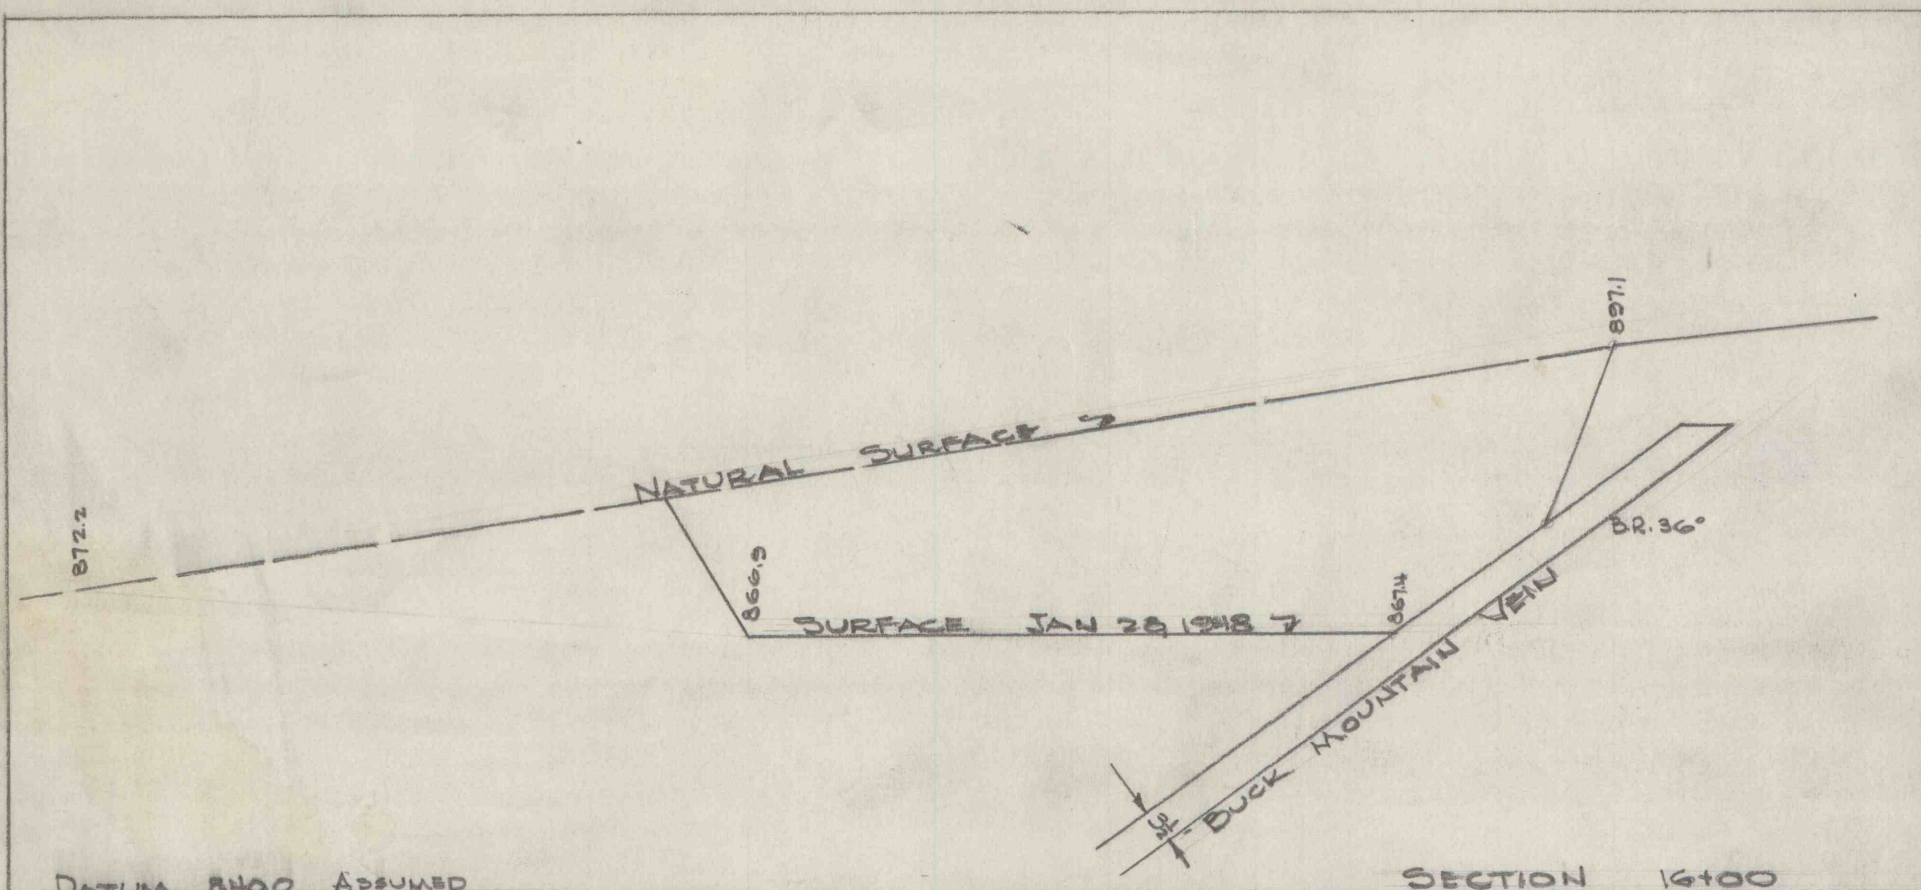

DATUM 8400 ASSUMED

SECTION 16+00

J. ROBERT BAZLEY, Inc.
POTTSVILLE, PENNA.

RAVEN RUN COAL CO.
SECTION THRU #13 STRIPPING
250' WEST OF BUCK SLOPE

DATE 1-28-48	SCALE 1"=20'	BY M	DATE 1-28-48
-----------------	-----------------	---------	-----------------