


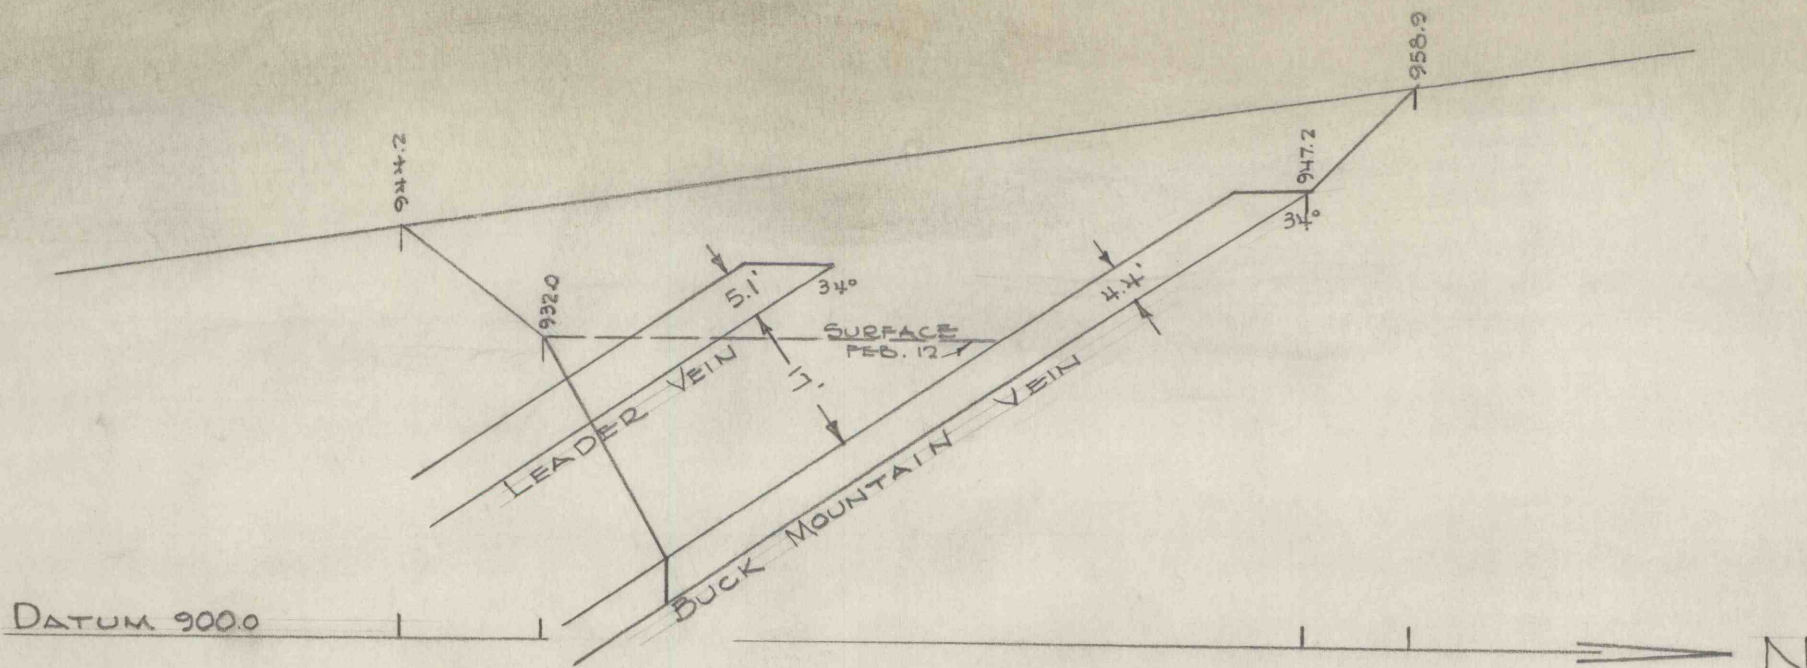

J. ROBERT BAZLEY, Inc.
POTTSVILLE, PENNA.

RAVEN RUN COAL CO.

TEST SECTION THROUGH #13 BUCK
600' WEST OF BUCK SLOPE

DATE	SCALE	BY
2-12-48	1"=20'	C-34