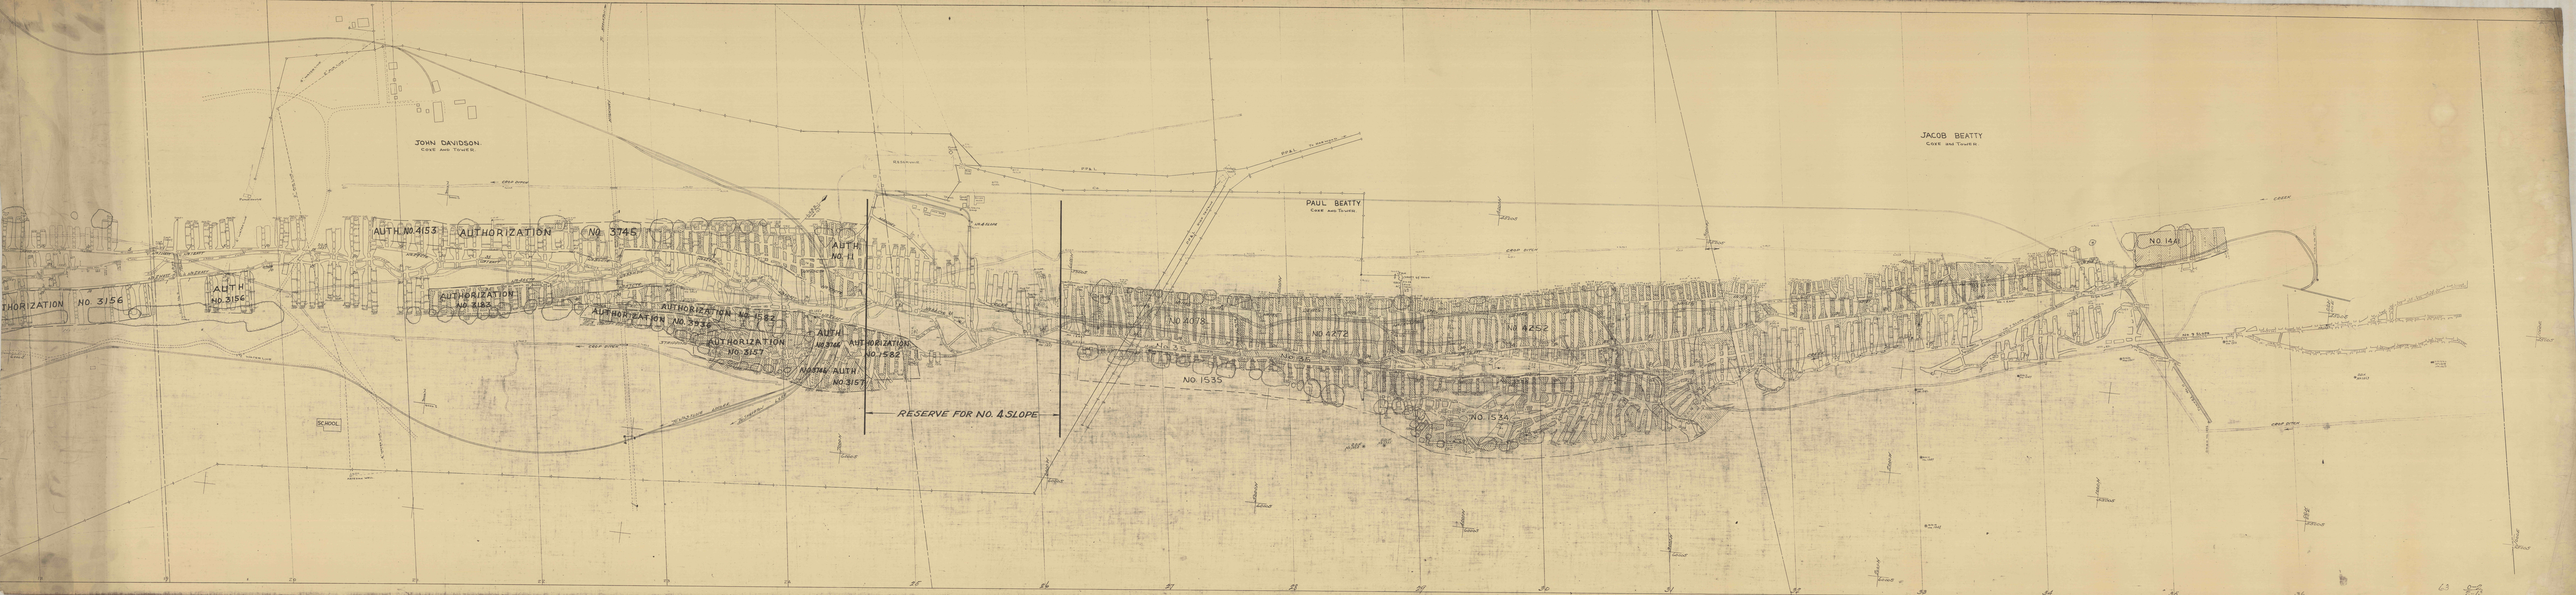

JOHN DAVIDSON.
COXE AND TOWER.
PAUL BEATTY
COXE AND TOWER.
JACOB BEATTY
COXE and TOWER.
TO HAZLETON
HIGHWAY
PUMP HOUSE
4" WATER LINE
2" AIR LINE
1½" WATER LINE
CROP DITCH
SCHOOL.
ARTESIAN WELL
SHAFT
RESERVOIR.
P.P.&L.
Co.
TRANS.
COMP. HOUSE
BOILER HOUSE
BL.SMITH SHOP
OFFICE
SMITH SHOP
WASH HOUSE
MANWAY
No. 4 SLOPE
HOSPITAL
CREEK
L.V.R.R. MILE POST No. 157
TO No. 3 SLOPE LOCO.R.R.
TO SHEPPTON L.V.R.R.
STRIPPING
P.P.&L. TO HARWOOD
TRANS. YARD
P.P.&L. HIGH TENSION
FAN
SHAFT 69' DEEP
THORIZATION NO. 3156
AUTH NO. 3156
AUTH. NO. 4153
AUTHORIZATION NO. 3745
AUTHORIZATION NO. 3183
AUTHORIZATION NO. 3936
AUTHORIZATION NO. 1582
AUTHORIZATION NO. 3157
AUTH NO. 11
AUTH NO. 3746
AUTHORIZATION NO. 1582
NO. 3746 AUTH NO. 3157
RESERVE FOR NO. 4 SLOPE
NO. 4078
NO. 4272
NO. 4252
NO. 35
NO. 35
NO. 1535
NO. 1534
NO. 1441
RESERVE
No. 1 EAST
No. 2 EAST
No. 7 SLOPE
No. 9 SLOPE
20 CAR TURNOUT
TUNNEL No. 11
D.D.H. No. 1351
D.D.H. No. 1352
D.D.H. No. 1346
D.D.H. No. 1347
D.D.H. No. 1348
D.D.H. No. 1349
D.D.H. No. 1354
D.D.H. No. 1355
D.D.H. No. 1423
9000W 5000S
9000W 6000S
7000W 6000S
6000W 5000S
4000W 4500S
3000W 4500S
2000W 6000S
1000W 5500S
1000E 5500S
25
26
27
28
29
30
31
32
33
34
35
36
63