


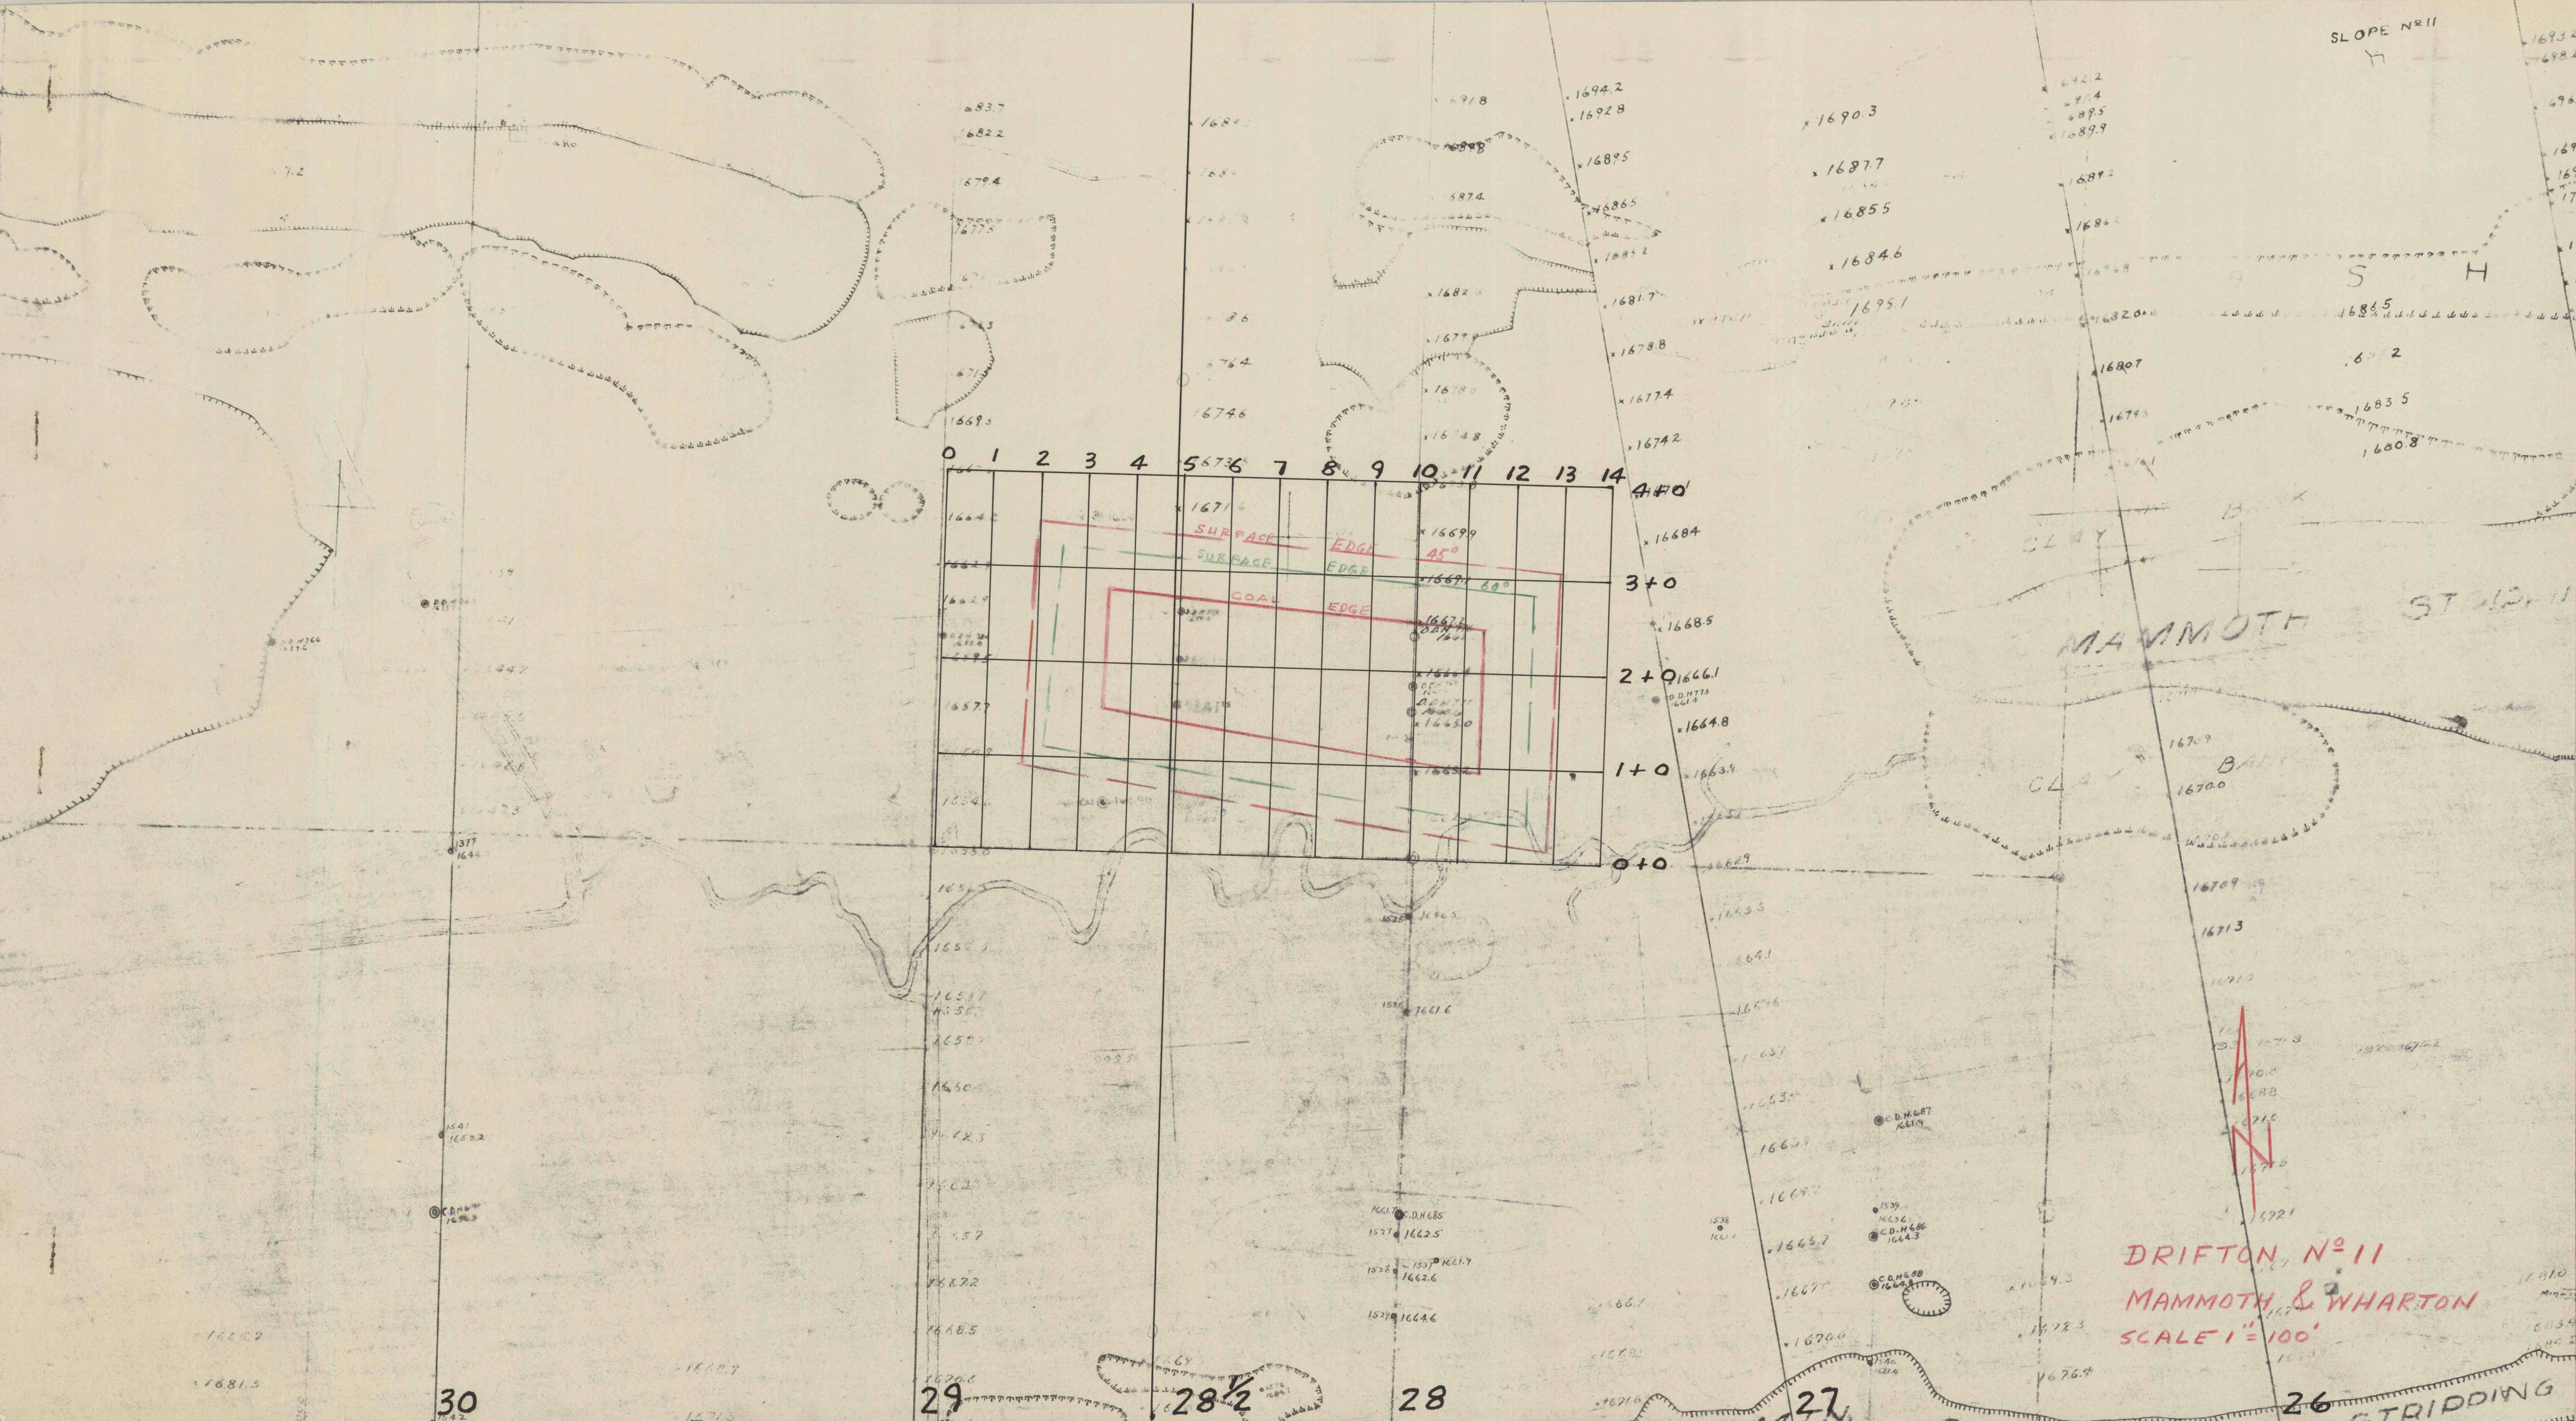

SLOPE No 11
H

CLAY
MAMMOTH
ST 12.11

DRIFTON No 11
MAMMOTH & WHARTON
SCALE 1"=100'

STRIPPING