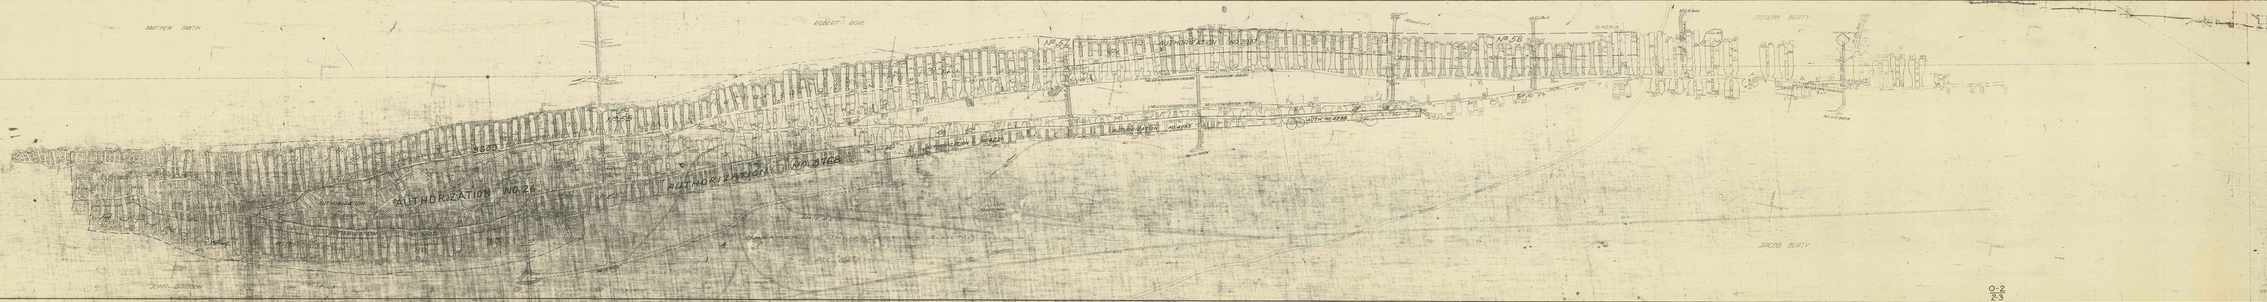

MATHEW SMITH
ROBERT ROPE
JOSEPH BEATY
Nº 55
Nº 57
AUTHORIZATION NO. 3937
Nº 58
No. 14 E. Buck
No. 8 East
Abandoned
No. 5 E. Buck
No. 8 E. Buck
TUNNEL
NO. 2 E. WHARTON - 2ND SEC.
NO. 2 S.W. WHARTON - 2ND SEC.
NO. 2 S.W. WHARTON - 1ST SEC.
NO. 2 S.E. WHARTON - 1ST SEC.
No. 4 S.E. Wharton
No. 5 S.E. Gamma
AUTH. NO. 4235
AUTHORIZATION NO. 4235
AUTHORIZATION NO. 4236
NO. 11 E. BUCK
CREEK
NO. 3609
NO. 1928
AUTHORIZATION NO. 26
AUTHORIZATION NO. 4619
AUTHORIZATION NO. 3938
AUTHORIZATION
Nº 65
1808
AUTHORIZATION NO. 3768
LOKIE R.R.
WHARTON - ONEIDA COLLIERY SLOPE No. 1 SCALE
SLOPE No. 1
PAUL BEATY
JOHN DAVIDSON
JACOB BEATY

ONEIDA No. 1&8 WHARTON VEIN

O-2
2-3