


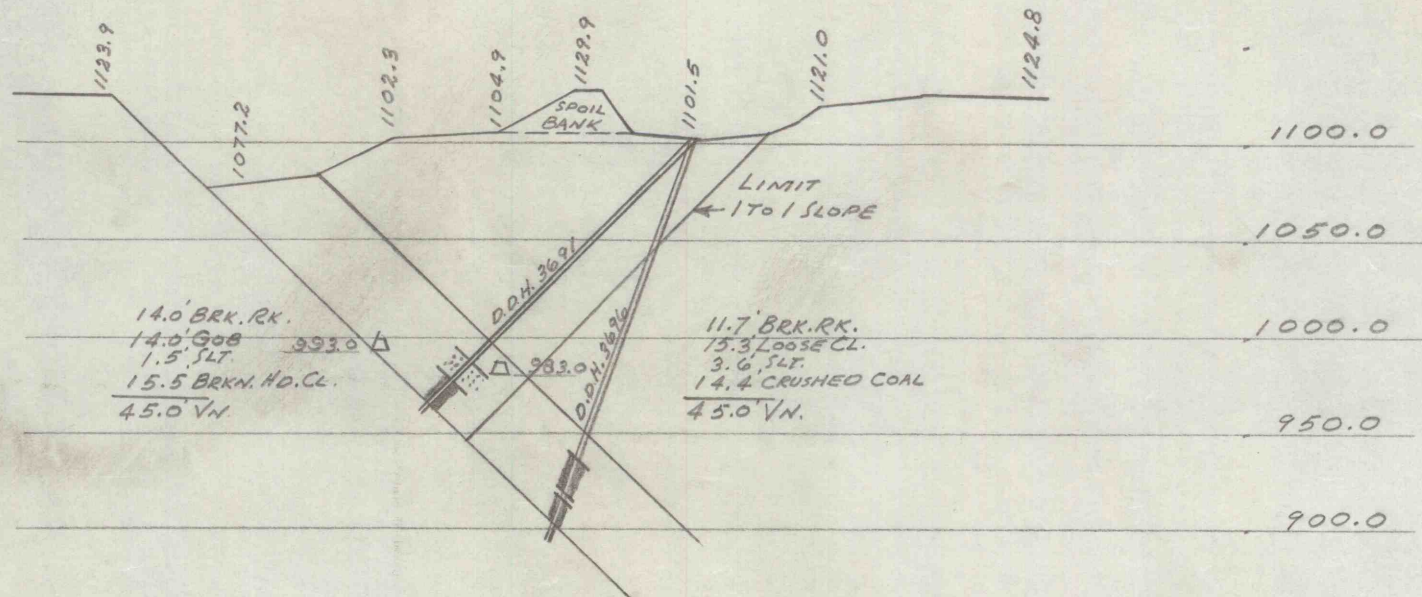

DATUM 800.0
SECTION 18

J. ROBERT BAZLEY, Inc.			
POTTSVILLE, PENNA.			
COALDALE COLLIERY			
#8 WEST MAMMOTH STRIPPING			
DATE	SCALE	BY	
2-1-49	1"=100'		