


J. ROBERT BAZLEY, Inc.
POTTSVILLE, PENNA.

SECTION THRU PRIMROSE
VEIN STRIPPING W. OF
MERRIAM SHAFT

DATE 1/29/46	SCALE 1"=20'	BY C.B.S.
-----------------	-----------------	--------------

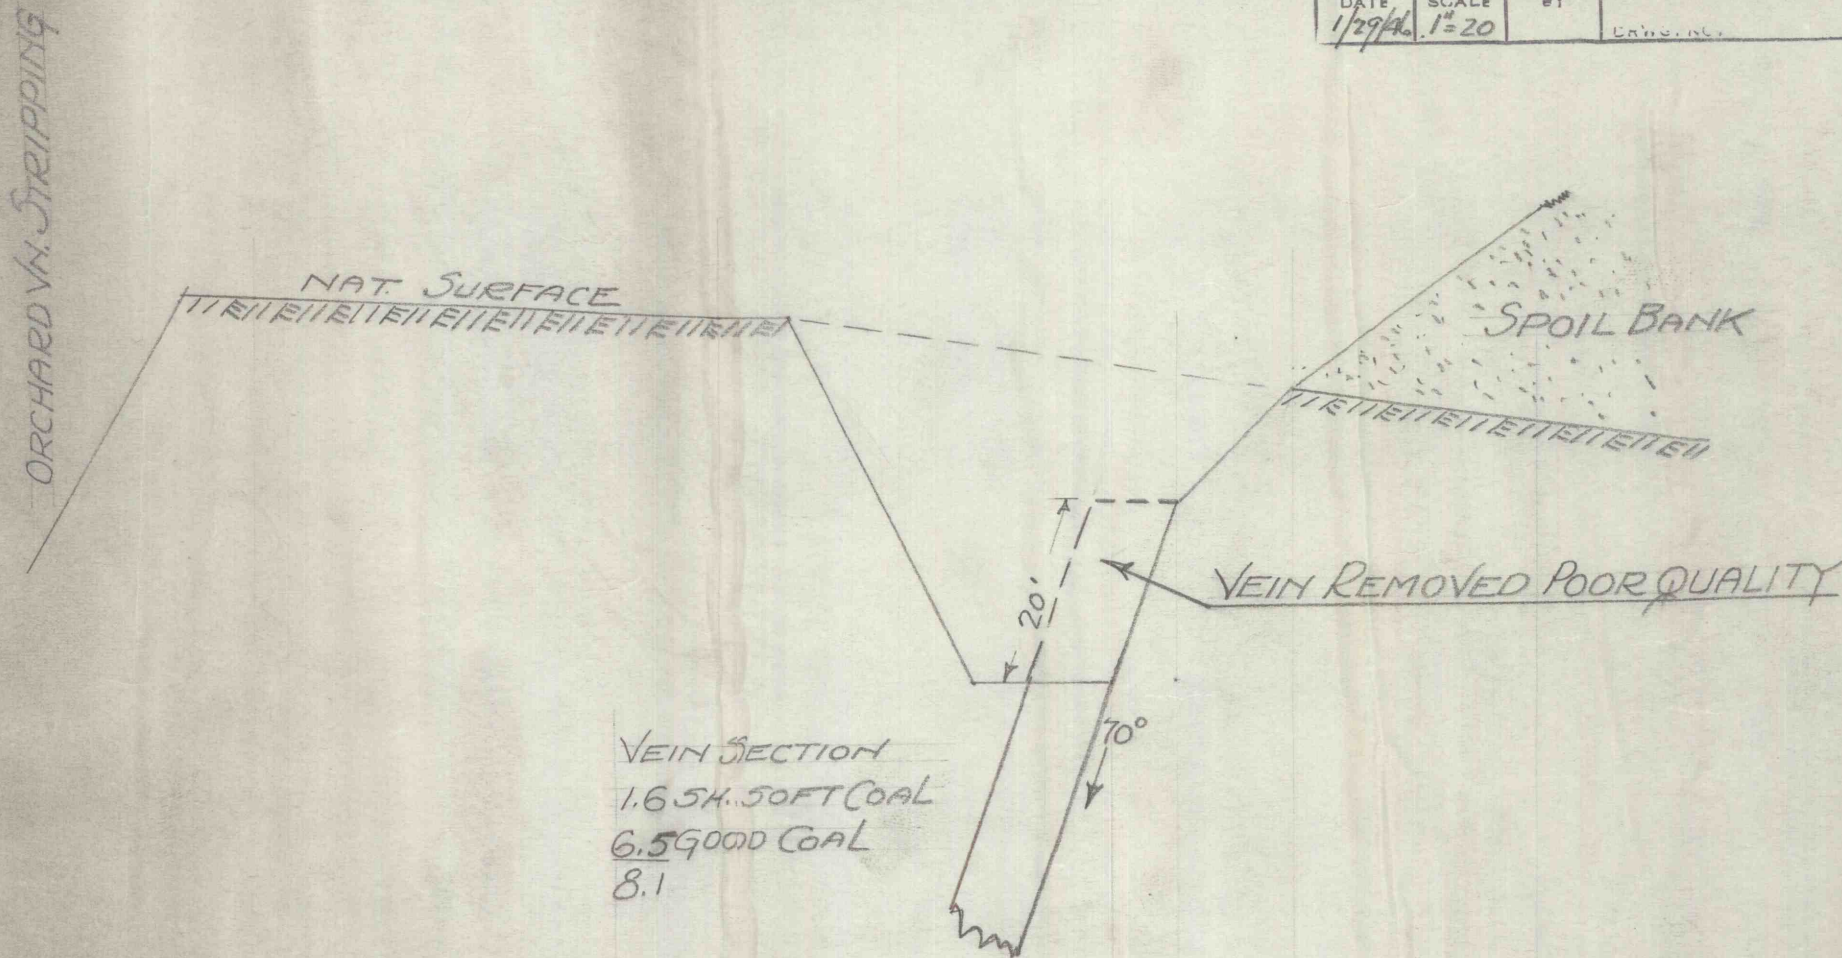

DATUM - 0

