


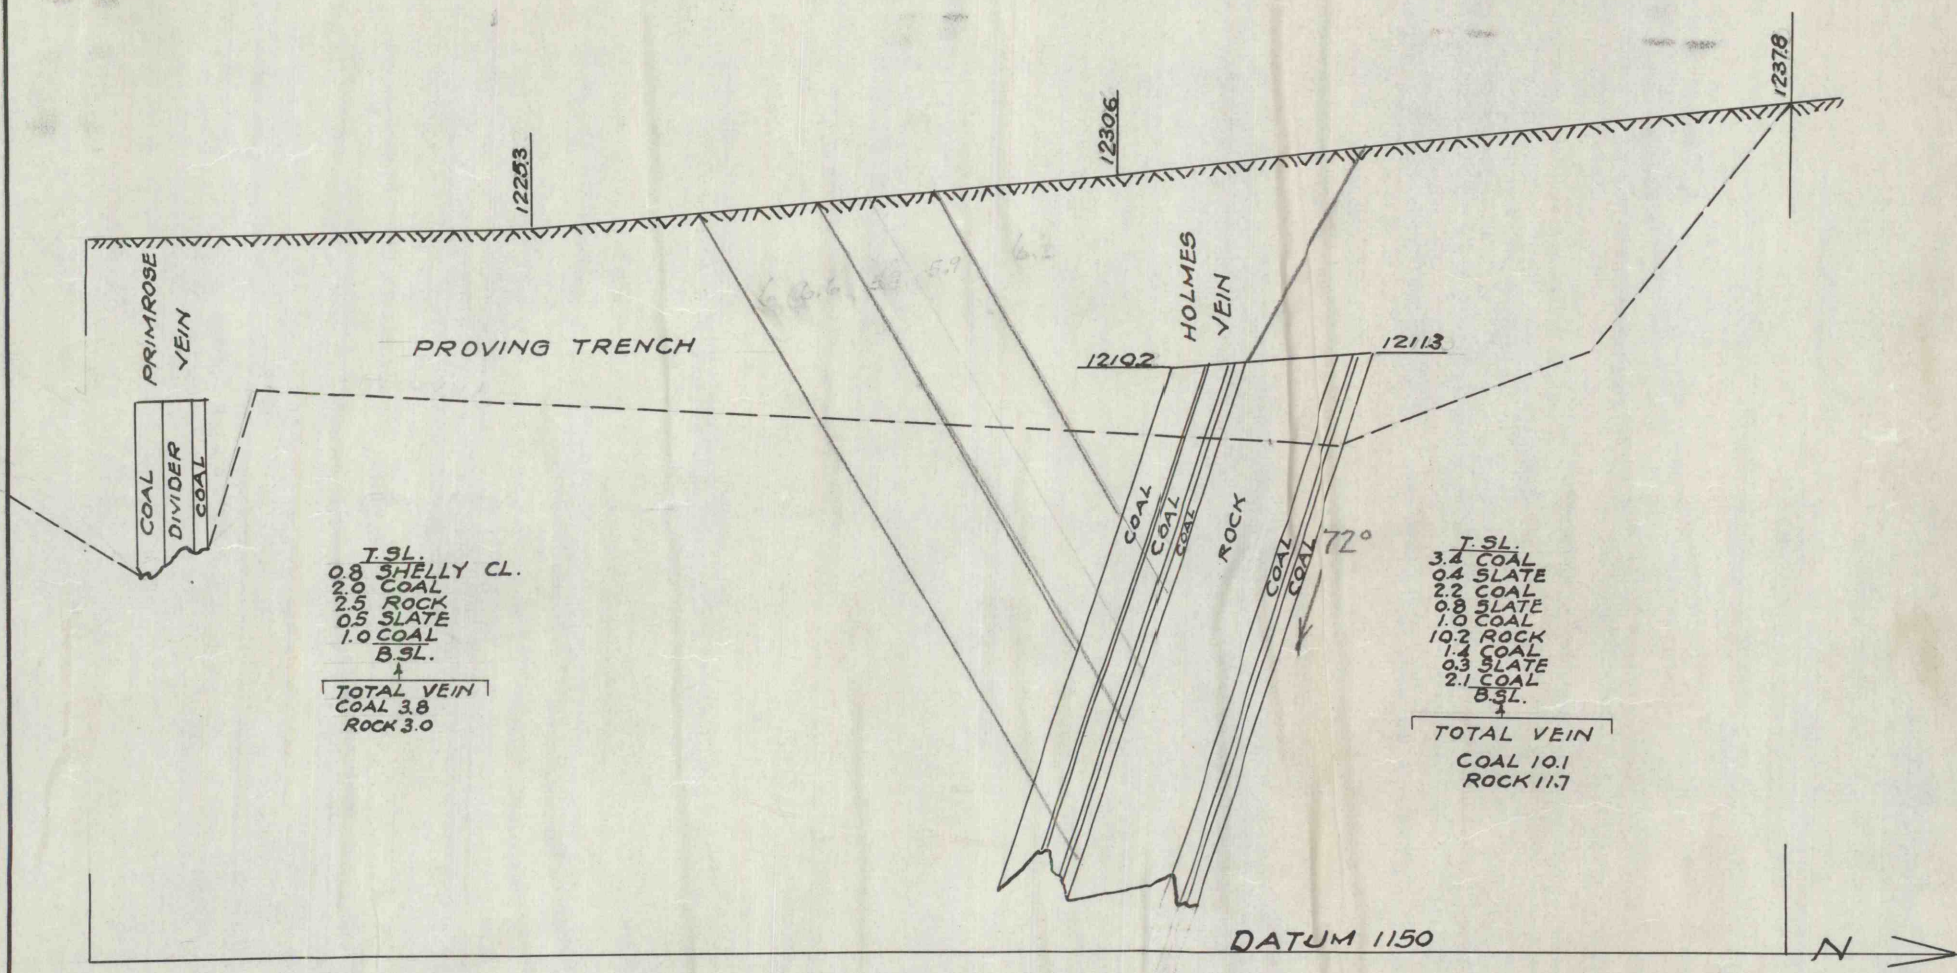

J. ROBERT BAZLEY, Inc.
POTTSVILLE, PENNA.

RAVEN RUN COAL CO.

SECT. THROUGH TRENCH PROVING

HOLMES & PRIM. VNS. SO. OF MERRIAM SH.

DATE 11-24-45	SCALE 1" = 20'	BY CR'S. INC.
------------------	-------------------	------------------