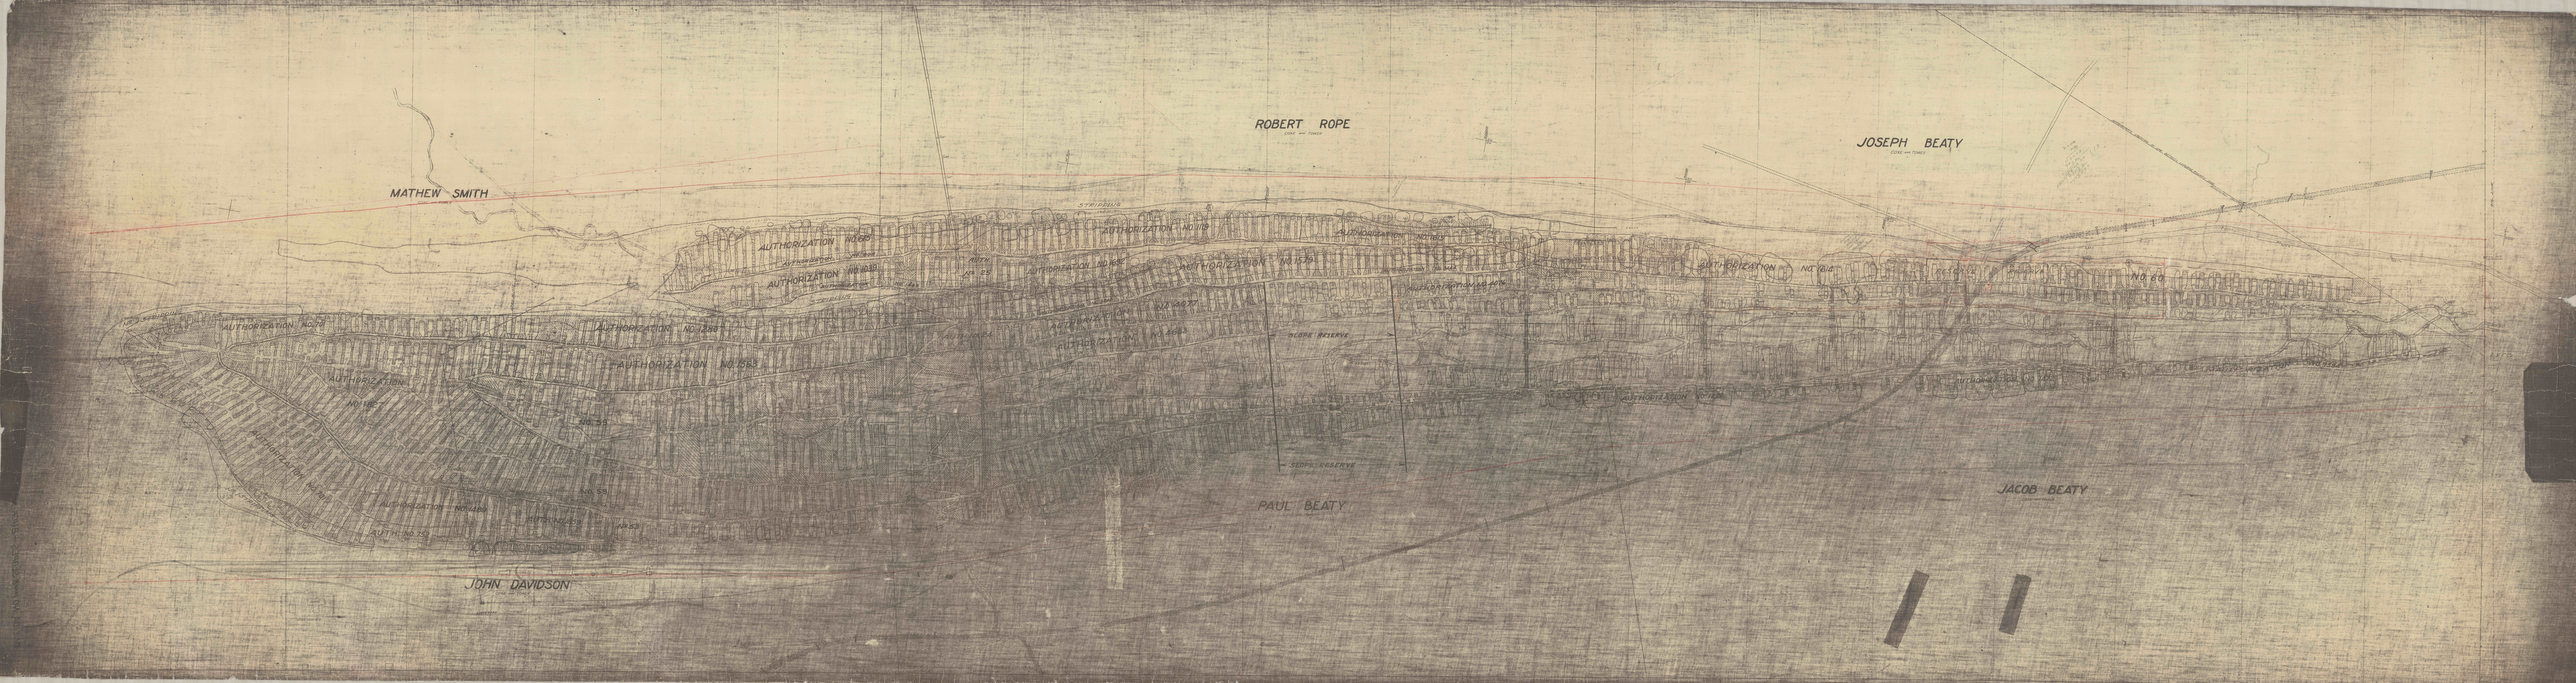

MATHEW SMITH
COXE AND TOWER
ROBERT ROPE
COXE AND TOWER
JOSEPH BEATY
COXE AND TOWER
APPROXIMATE LOCATION OF LINE BETWEEN LUZERNE COUNTY AND SCHUYLKILL COUNTY
STRIPPING
STRIPPING
No. 1 STRIPPING
No. 1 STRIPPING
AUTHORIZATION NO. 615
AUTHORIZATION NO. 808
AUTHORIZATION NO. 1039
AUTHORIZATION NO. 1460
AUTHORIZATION NO. 119
AUTHORIZATION NO. 1615
AUTH. No. 25
AUTHORIZATION NO. 1692
AUTHORIZATION NO. 1579
AUTHORIZATION NO. 4076
AUTHORIZATION NO. 1614
RESERVE
RESERVE
NO. 60
AUTHORIZATION NO. 701
AUTHORIZATION NO. 1280
AUTHORIZATION NO. 1563
AUTHORIZATION NO. 3842
NO. 4077
AUTHORIZATION
AUTH. No. 24
AUTHORIZATION NO. 4633
SLOPE RESERVE
SLOPE RESERVE
AUTHORIZATION NO. 1827
NO. 59
NO. 59
AUTHORIZATION NO. 701
AUTHORIZATION NO. 1489
AUTH. NO. 1659
No. 53
AUTH. NO. 752
AUTHORIZATION NO. 1226
AUTHORIZATION NO. 1472
AUTHORIZATION NO. 1584
PAUL BEATY
JACOB BEATY
JOHN DAVIDSON
COXE AND TOWER
SCHOOL
LOWE ROAD