


LUZERNE COUNTY
SCHUYLKILL COUNTY

ANDREW DOUGLAS
L.V.C.CO.

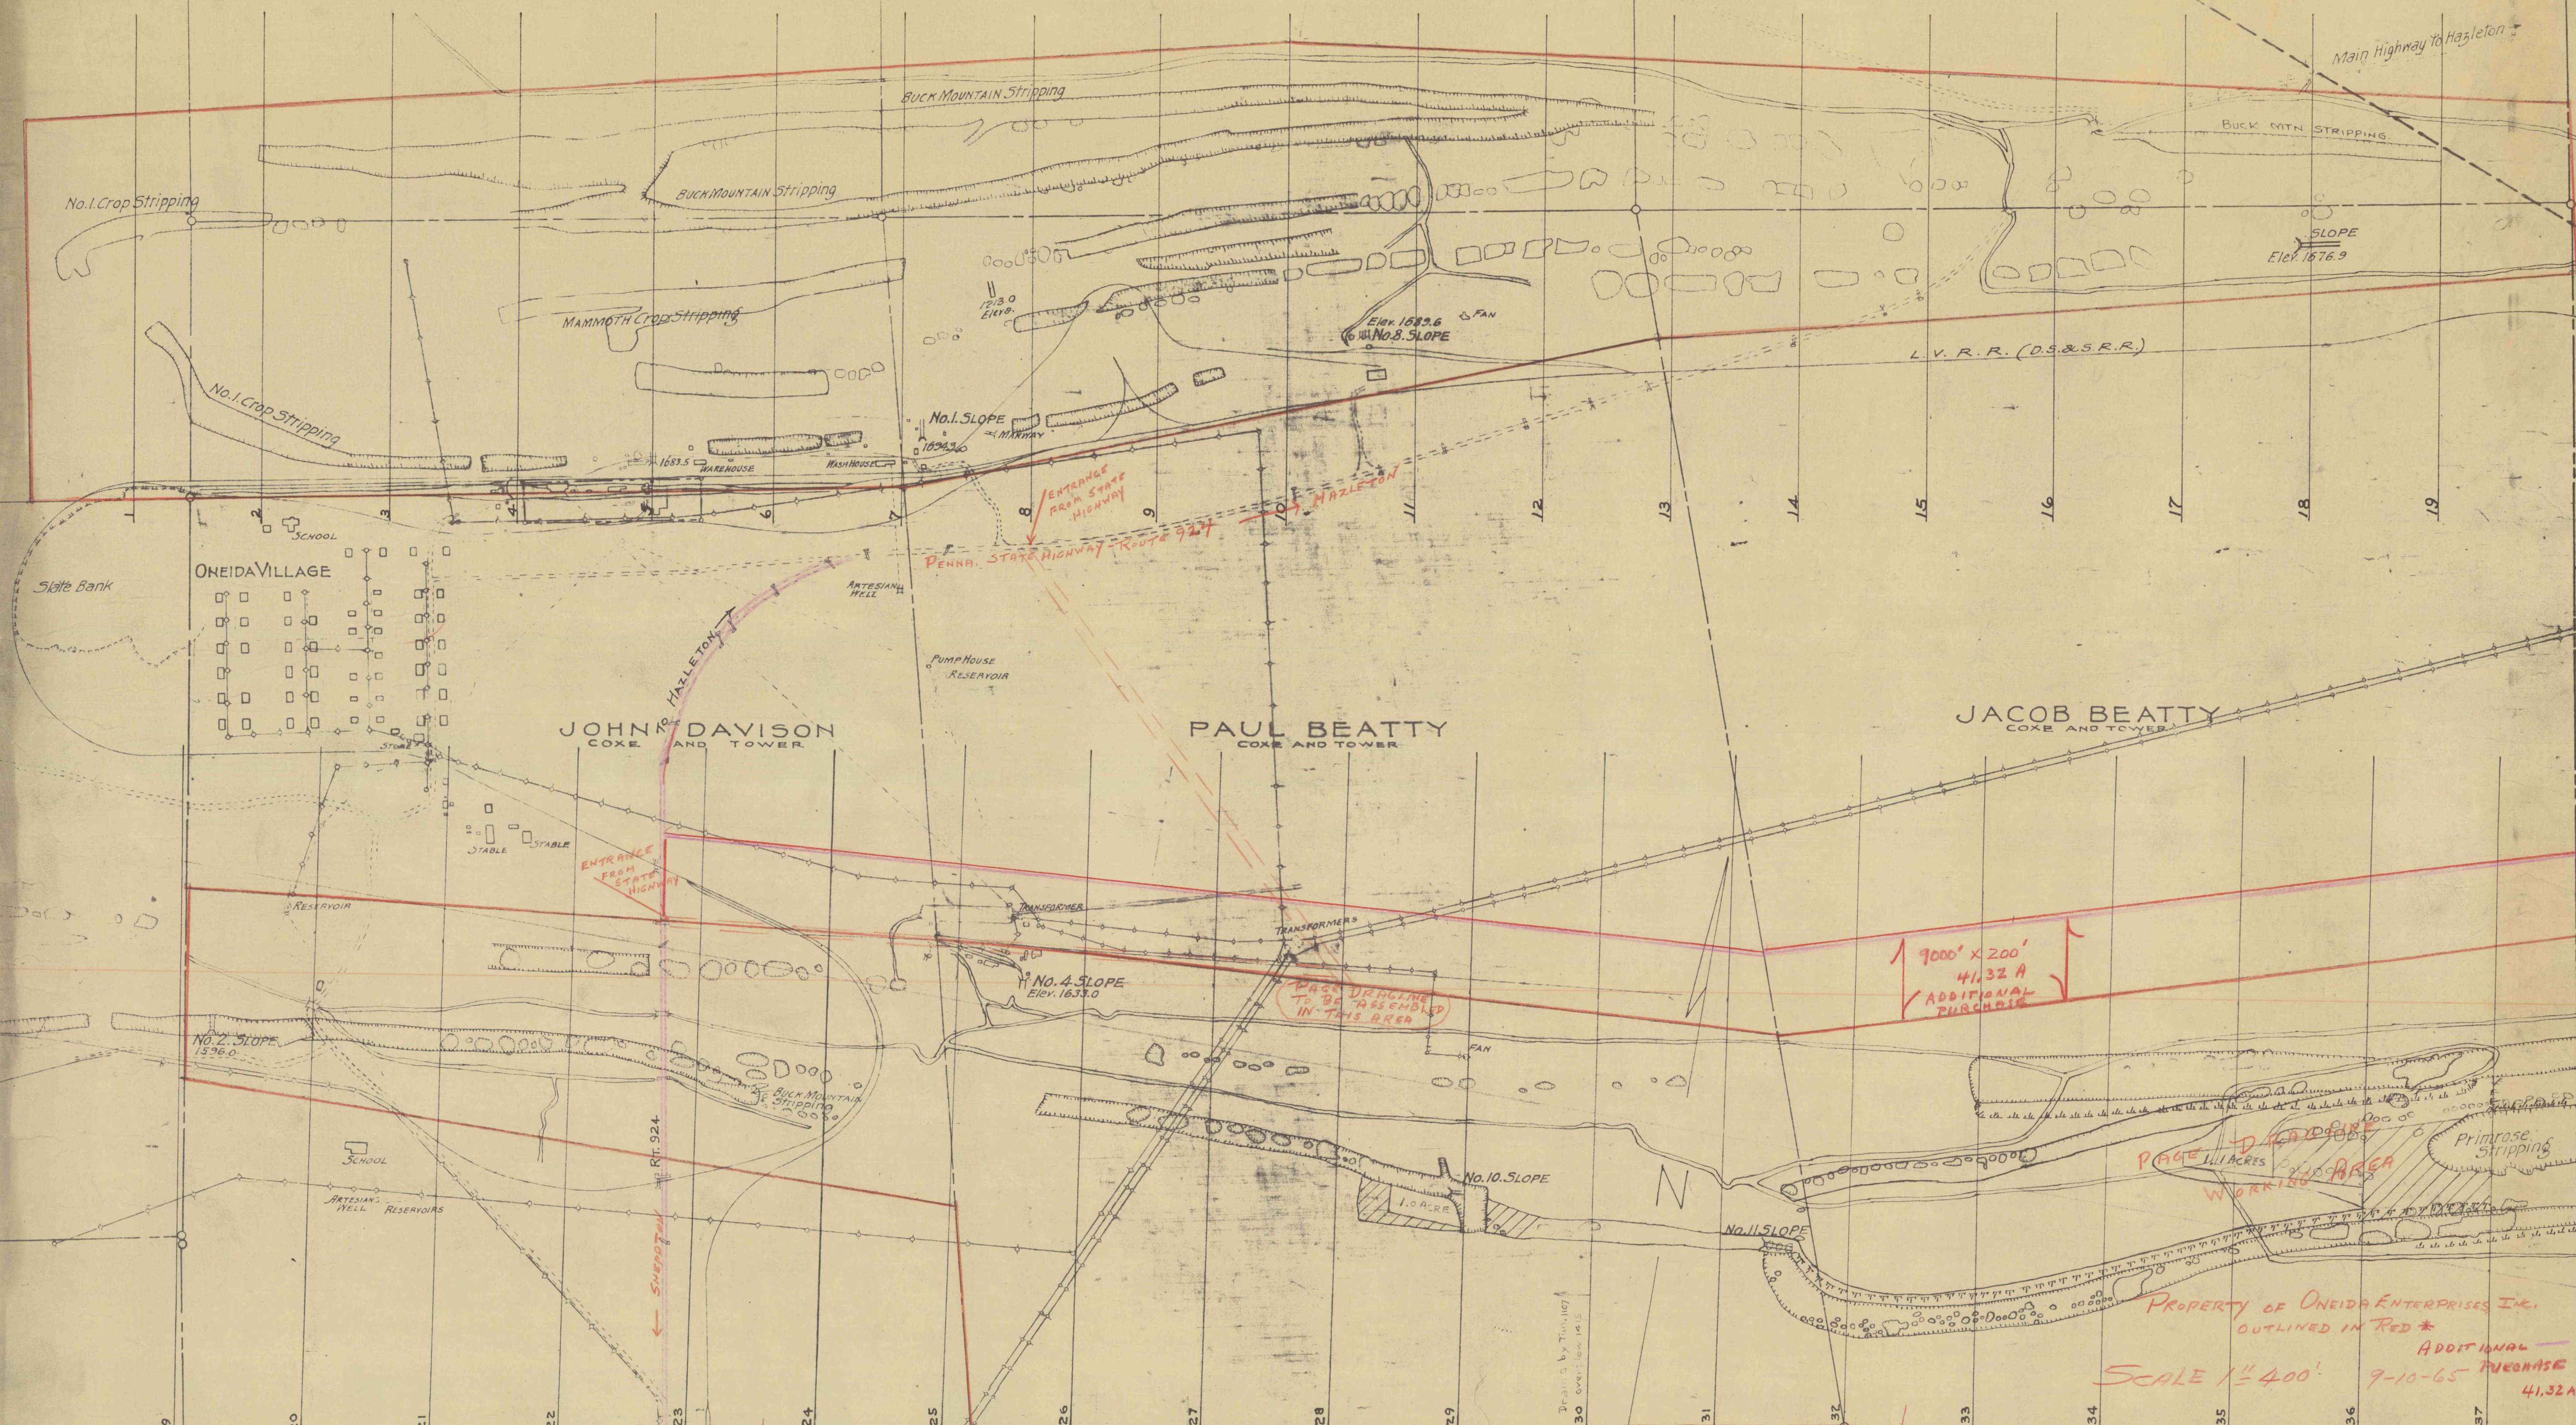

LEHIGH VALLEY COAL CO.
GLEN ALDEN COAL CO.

WILLIAM SPROAT
G.A.C.CO.

CHARLES COCHRAN
GIRARD ESTATE

JAMES CHAPMAN
G.A.C.CO.

PROPERTY OF ONEIDA ENTERPRISES INC.
OUTLINED IN RED *
ADDITIONAL -
9-10-65 PURCHASE
41.32A

SCALE 1" = 400'