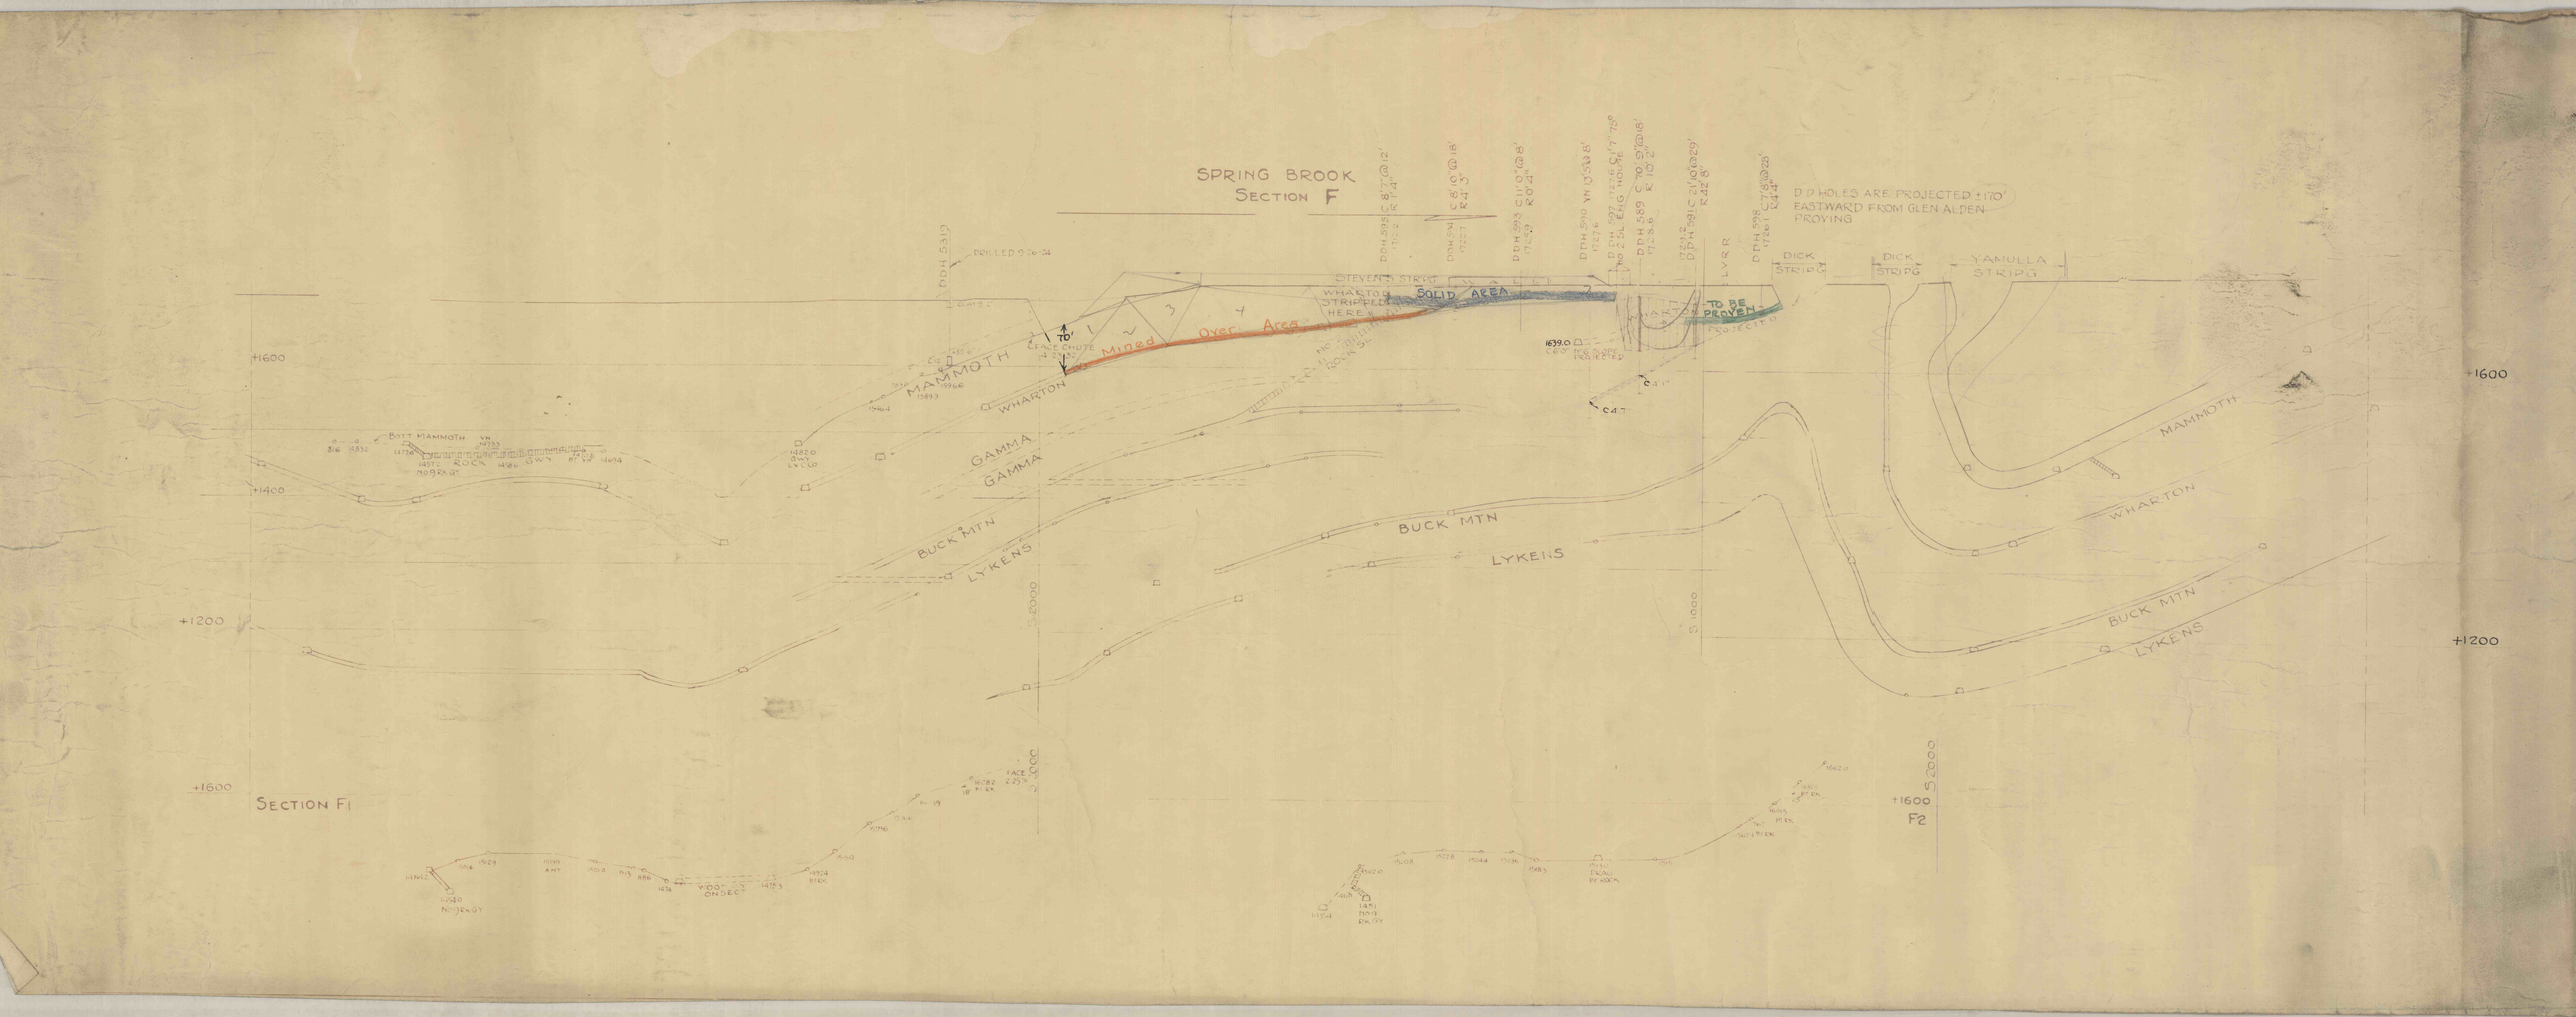
SPRING BROOK
SECTION F
DDH 5319
DRILLED 9-26-24
DDH 595 @ 87' @ 12° R 4°
DDH 534 @ 18' @ 43°
DDH 593 @ 0° @ 8° R 0°
DDH 590 @ 8° @ 16° R 0°
DDH 589 @ 0° @ 16° R 0°
DDH 591 @ 40° @ 29° R 42°
DDH 596 @ 25° @ 44°
D D HOLES ARE PROJECTED ±170' EASTWARD FROM GLEN ALDEN PROVING
STEVENS STRIP
WHARTON STRIPPED HERE
SOLID AREA
Mined Over Area
TO BE PROVEN
PROJECTED
DICK STRIPG
DICK STRIPG
YAMUDLA STRIPG
LYR R
CRANE CHUTE
MAMMOTH
WHARTON
GAMMA
BUCK MTN
LYKENS
+1600
+1400
+1200
S 2000
S 1000
SECTION F1
SECTION F2