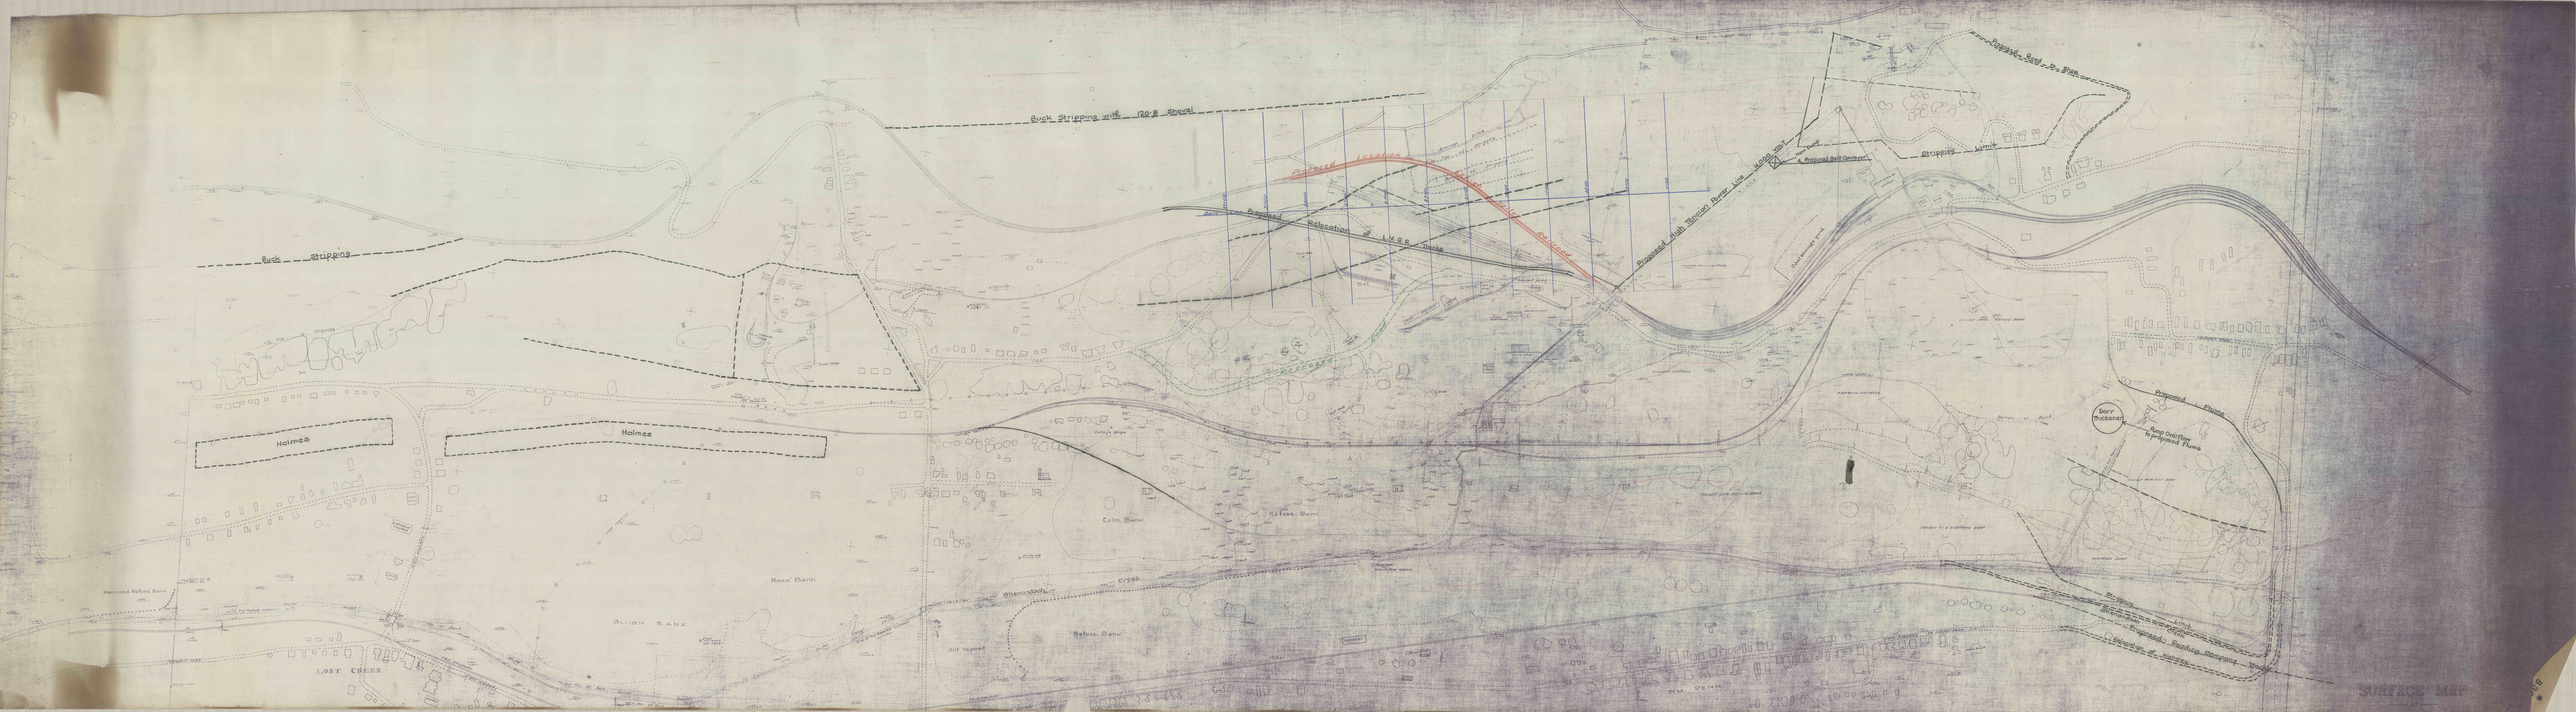

Buck Stripping with 120-B Shovel
Buck Stripping
Top of Stripping
Holmes
Holmes
Mammoth Slope
Tender Slope
Fan House
Catholic Church
Hammond Refuse Bank
Rip Rapped Channel
LOST CREEK
SLUSH BANK
Rock Bank
Shenandoah Creek
Refuse Bank
Silt Deposit
Culm Bank
Curley's Slope
Lehigh Valley R.R.
Removed
End of Rip Rapped Channel
G I R A R D
E S T A T E
Base Line
Proposed Relocation of L.V.R.R. Tracks
Proposed Location of Lehigh Valley Railroad
Drainage Ditch
Top of Stripping
Bottom of Stripping
Test Hole A
Test Hole B
Test Hole C
Timber Yard
Township Road
Proposed Road
Proposed High Tension Power Line 4,000 VOLT
New Dump & Proposed Belt Conveyor
Coal Storage Yard
Holmes Vein Stripping
Mammoth Stripping
Stripping Limit
Proposed Road to Shop
Locust 19th Refuse Bank
Bottom of Bank
Top of Stripping
Proposed Flume
Dorr Thickener
Pump Overflow to proposed Flume
Locust Mtn. Silt Bank
Packer No. 4 Refuse Bank
Packer No. 4 Stripping Dump
Stripping Dump
Washery
William Penn Washery
WM. PENN
Stripping Limit
Shenandoah Creek
Proposed Reading Company Tracks
Relocation of Highway

SURFACE MAP