


PPSI - MC-JAI

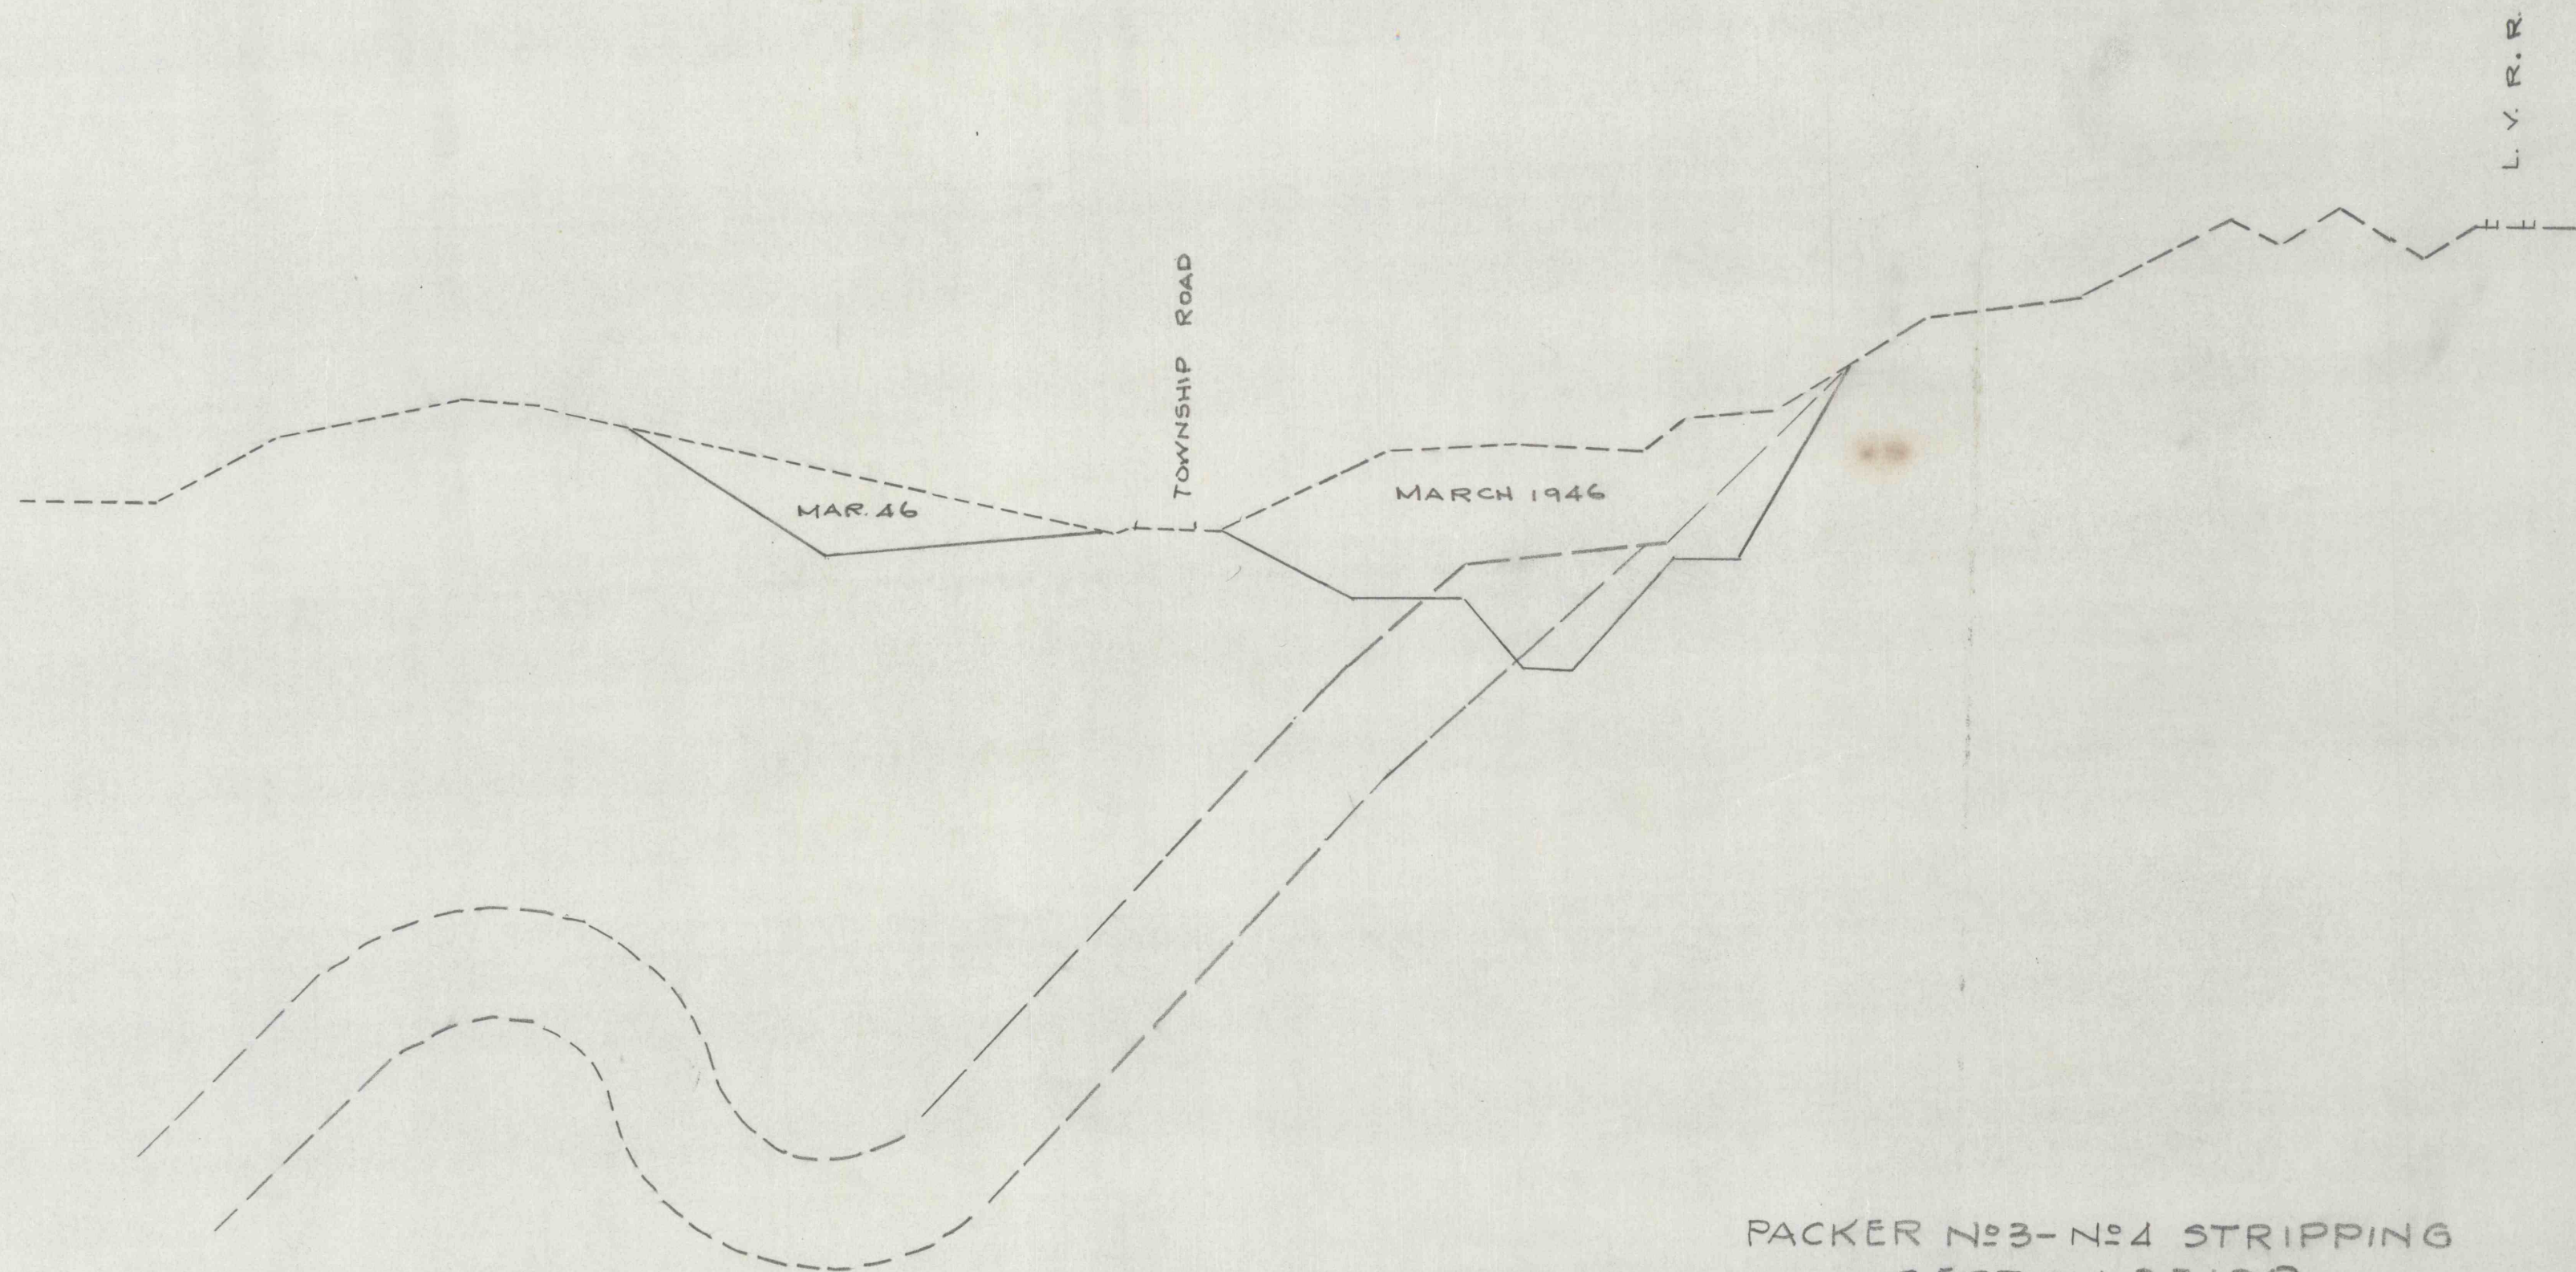

PACKER N°3-N°4 STRIPPING
SECTION 33+00
1" = 50'