


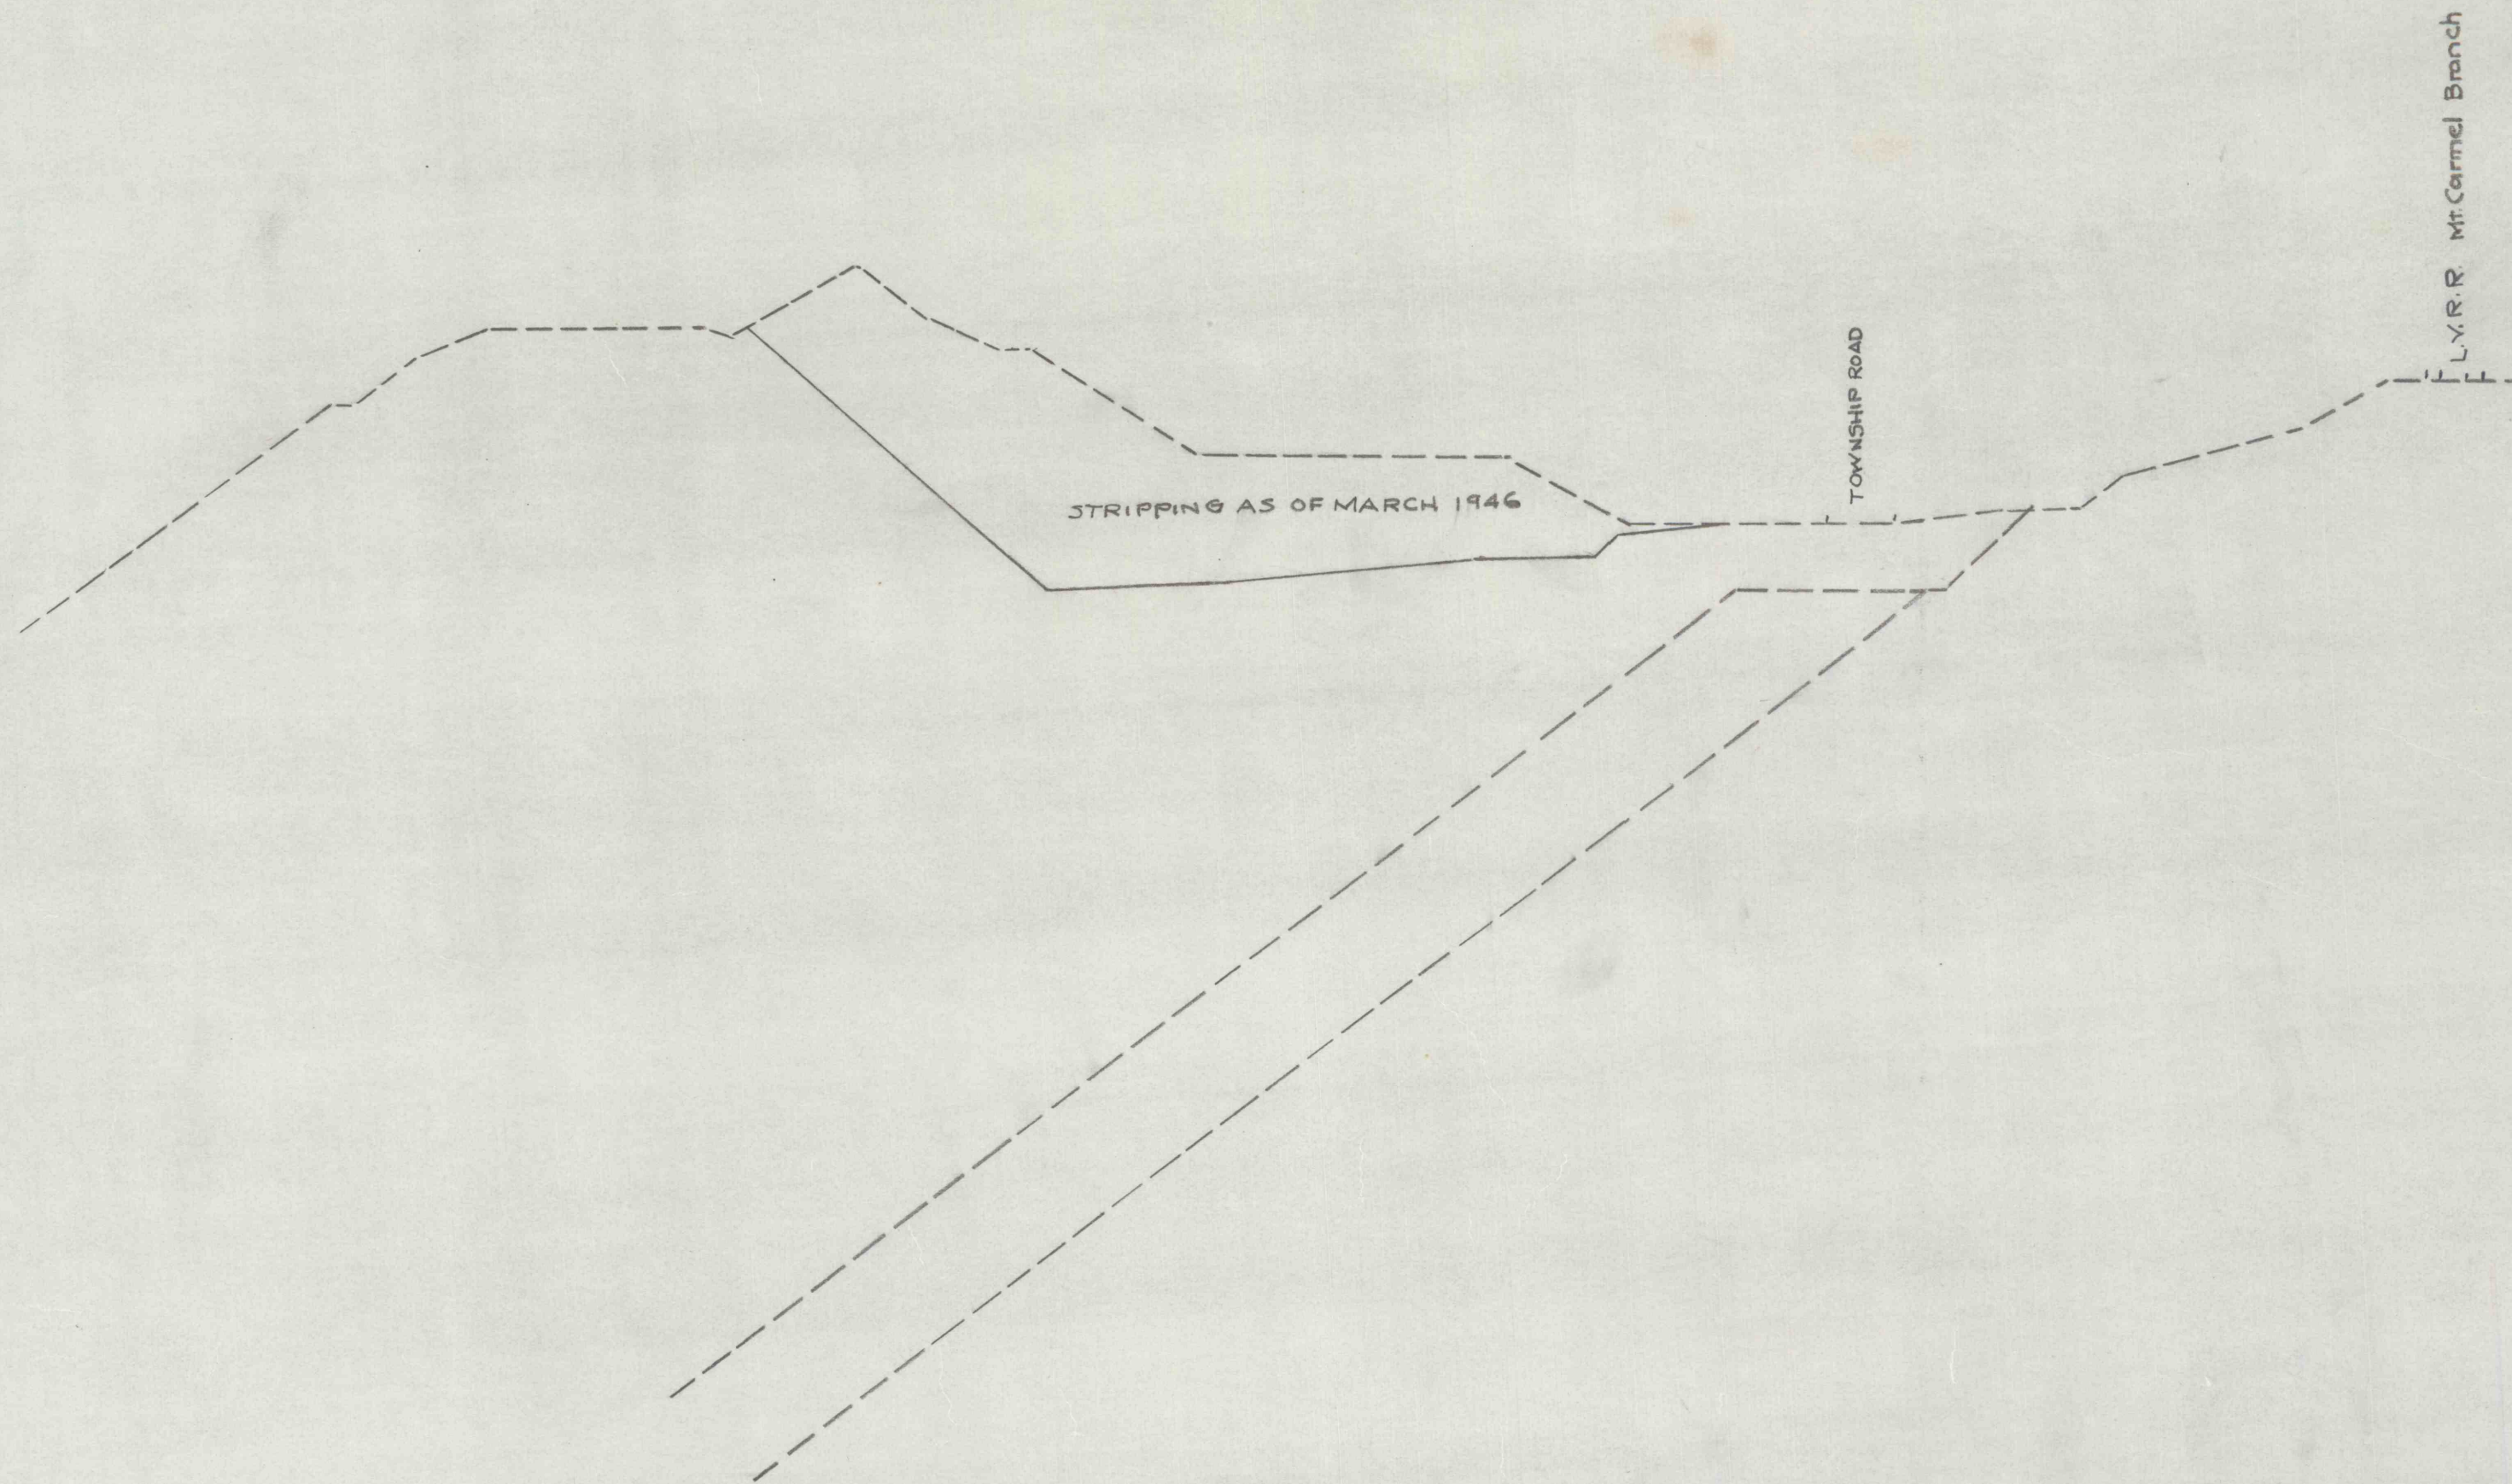

PACKER N°3-N°4 STRIPPING  
SECTION 29+00.  
1" = 50'