


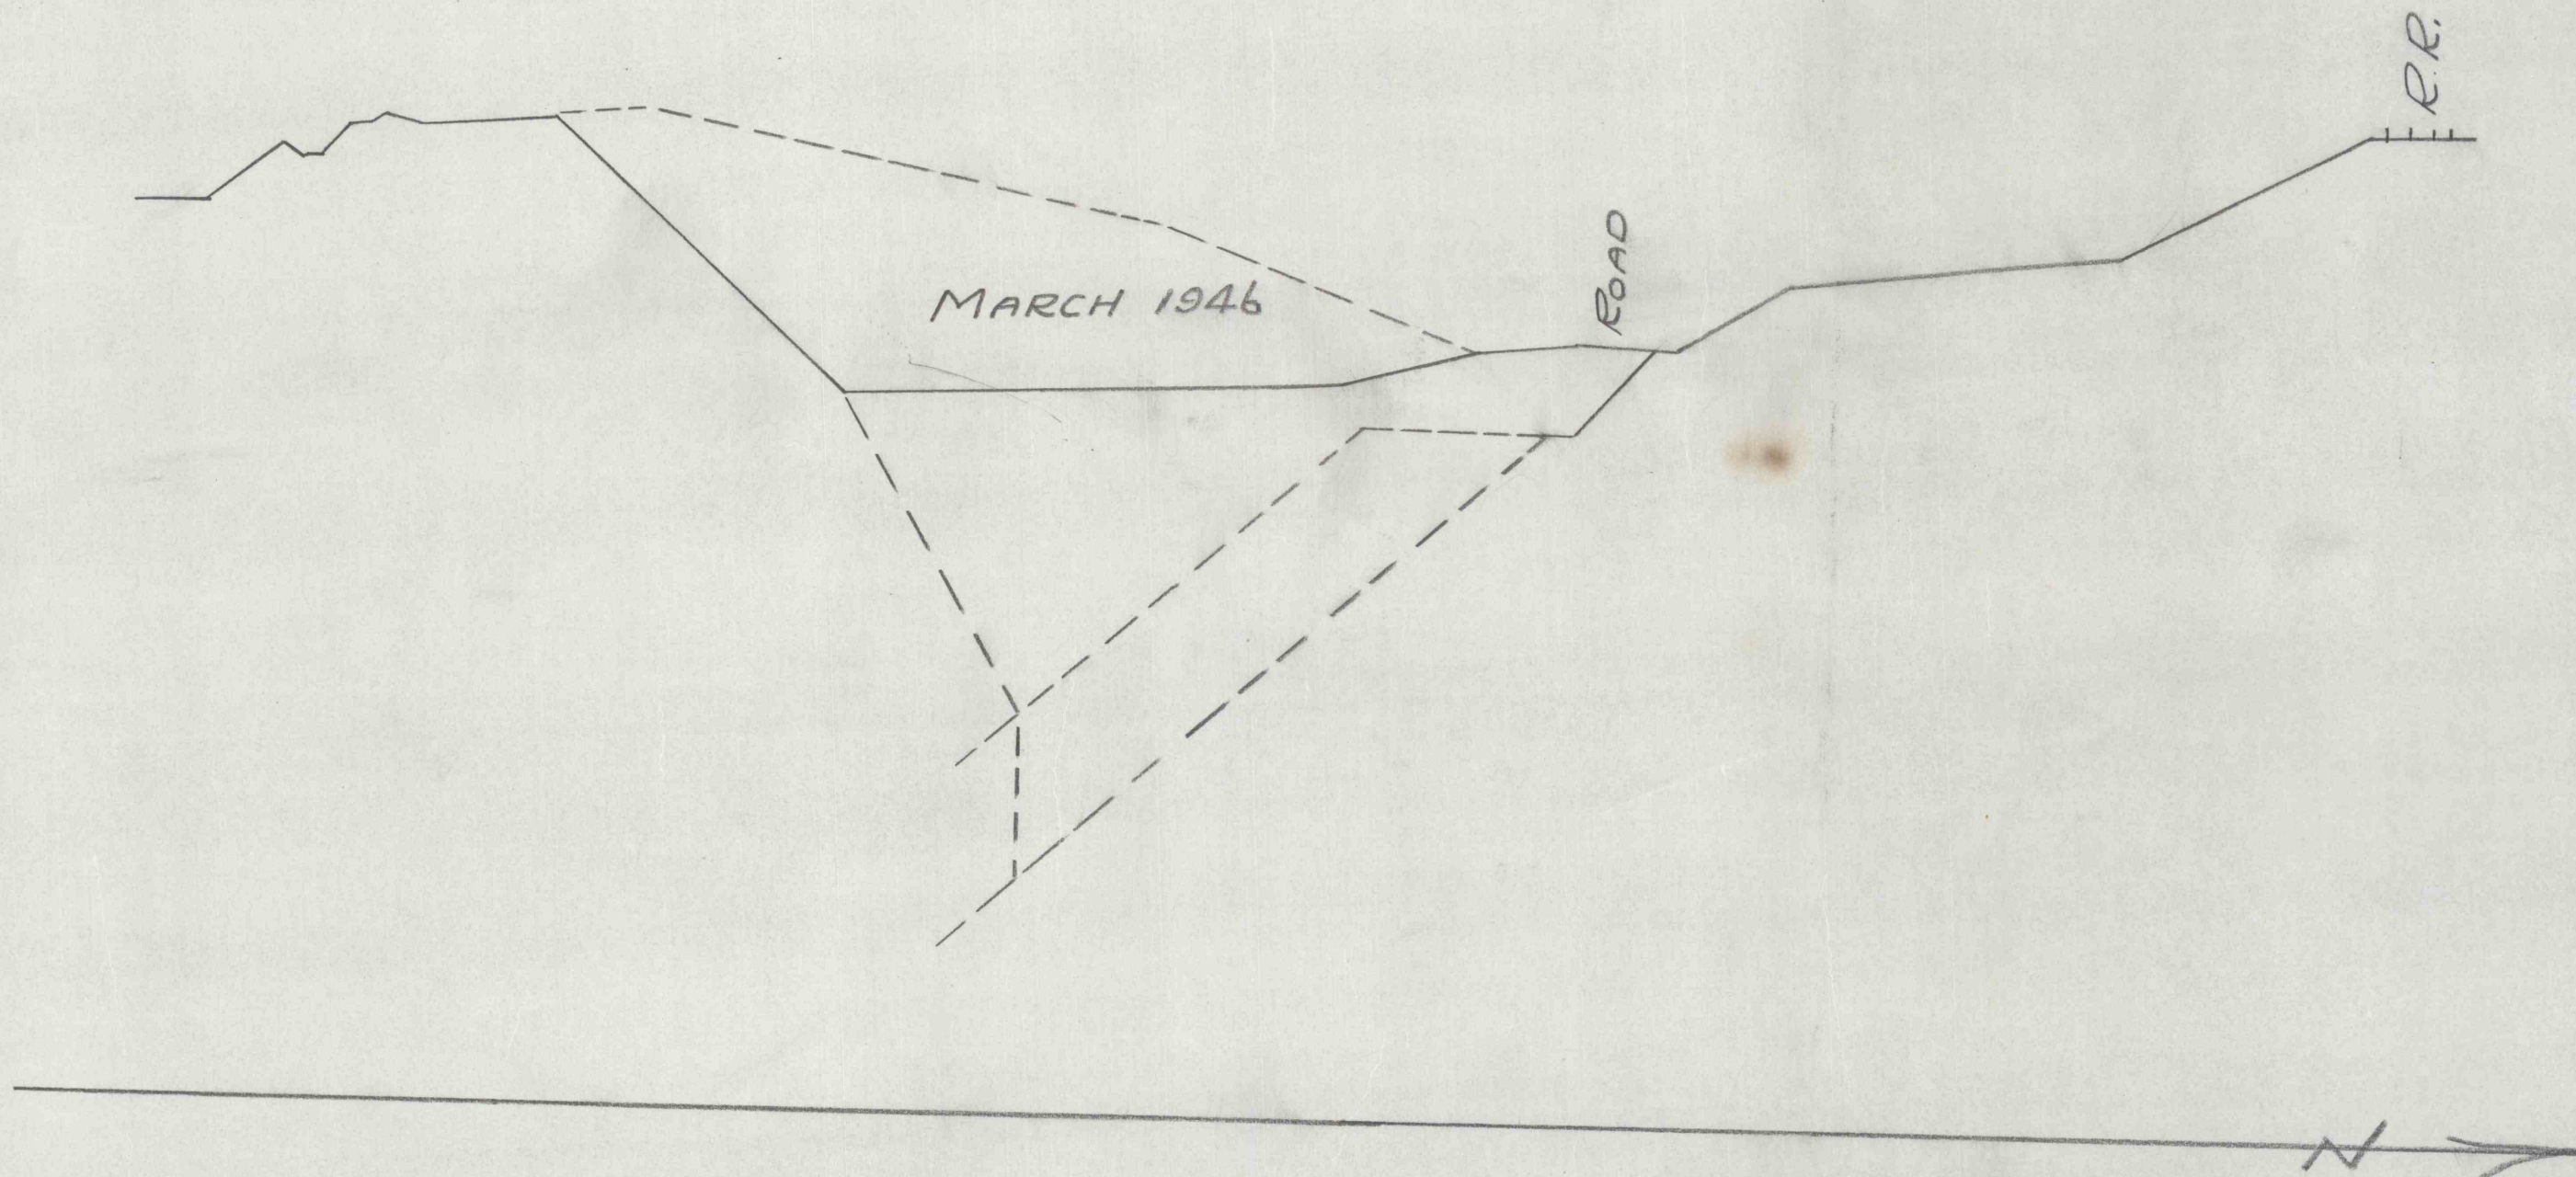

PACKER NO 3 - #4 STRIPPING
SECTION 31+00
1" = 50 FT.