


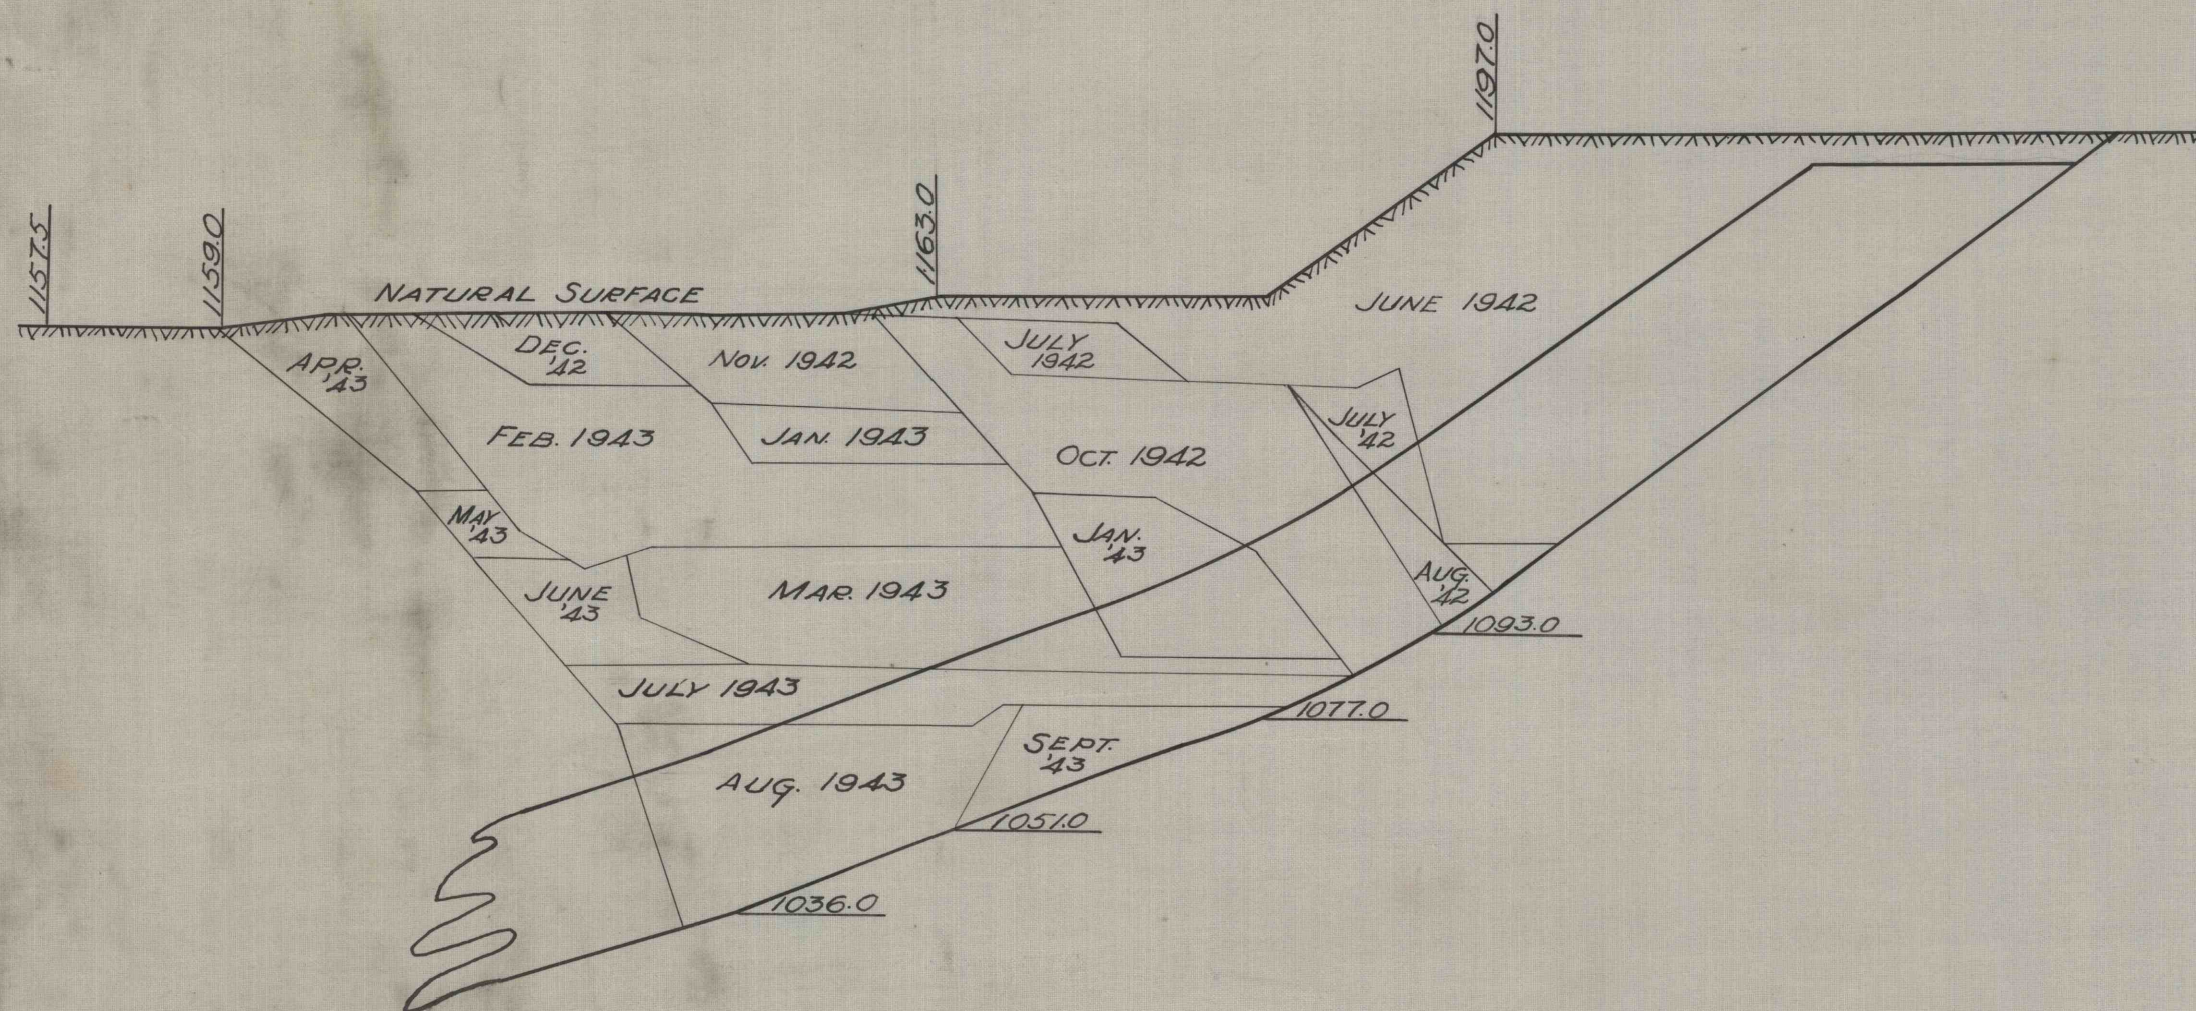

J. ROBERT BAZLEY, Inc.
 POTTSVILLE, PENNA.
 LOCUST COAL Co.
 TYPICAL SECTION OF PACKER No. 4
 MAMMOTH VEIN STRIPPING

DATE	SCALE	BY
2-23-44	1"=40'	