


Datum

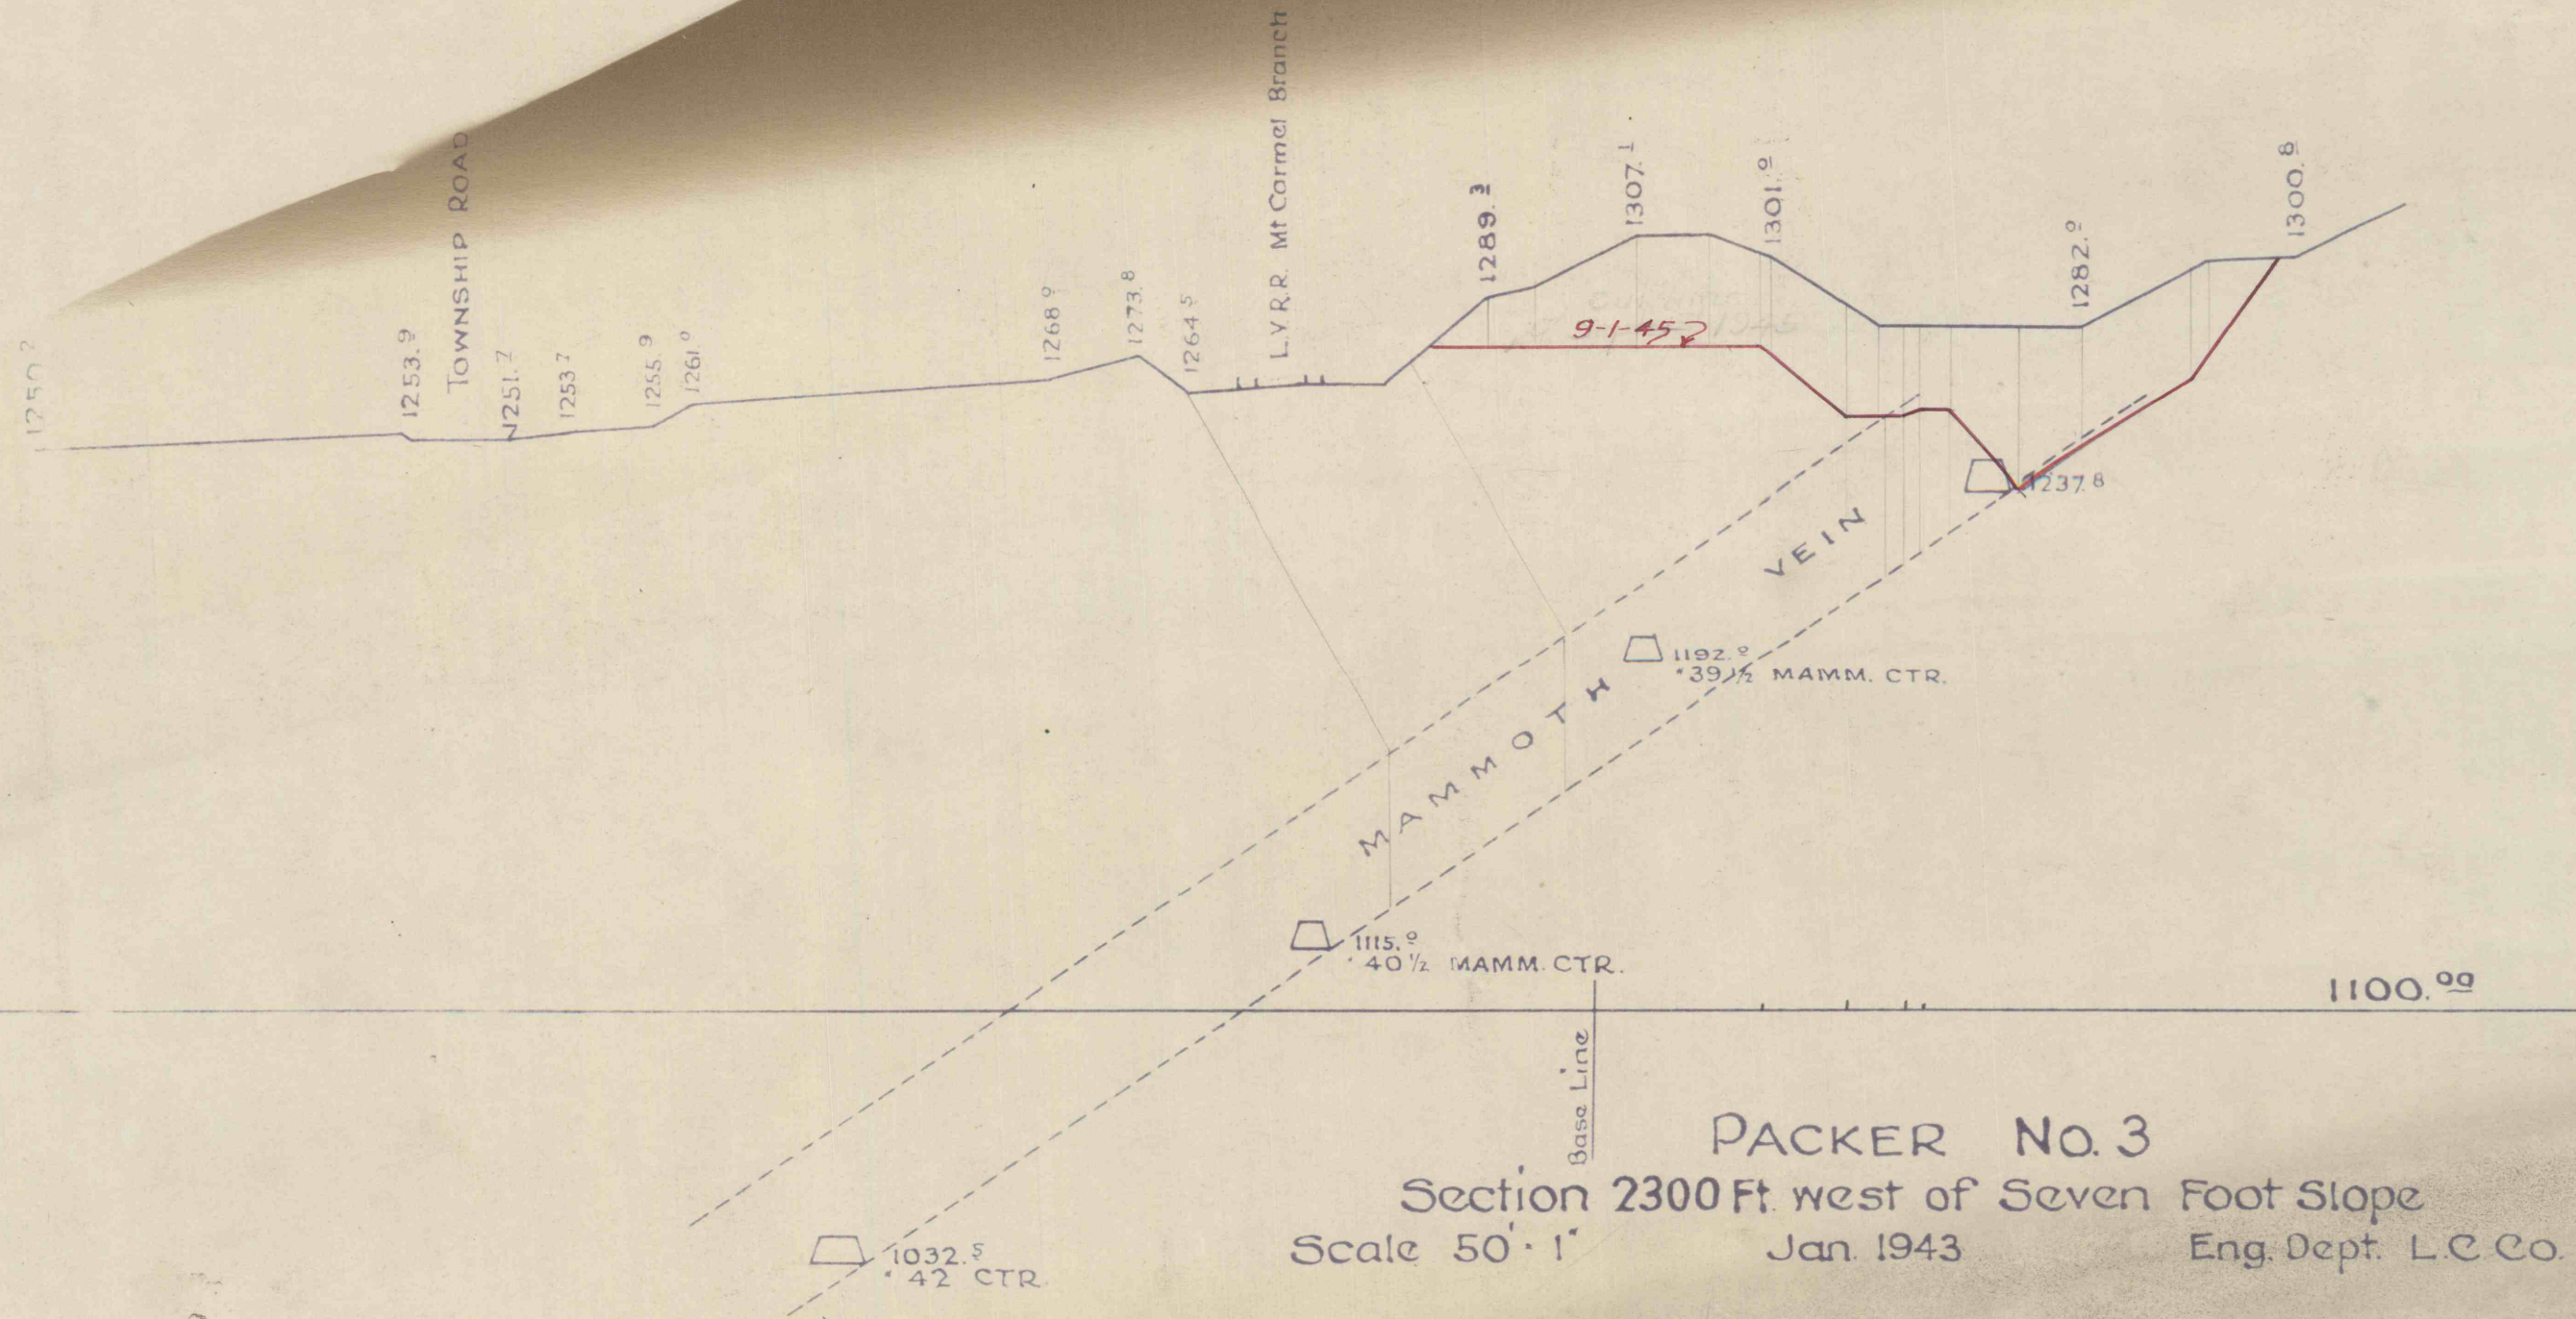

PACKER No. 3

Section 2300 Ft. west of Seven Foot Slope
Scale 50' = 1" Jan. 1943 Eng. Dept. L.C. Co.