


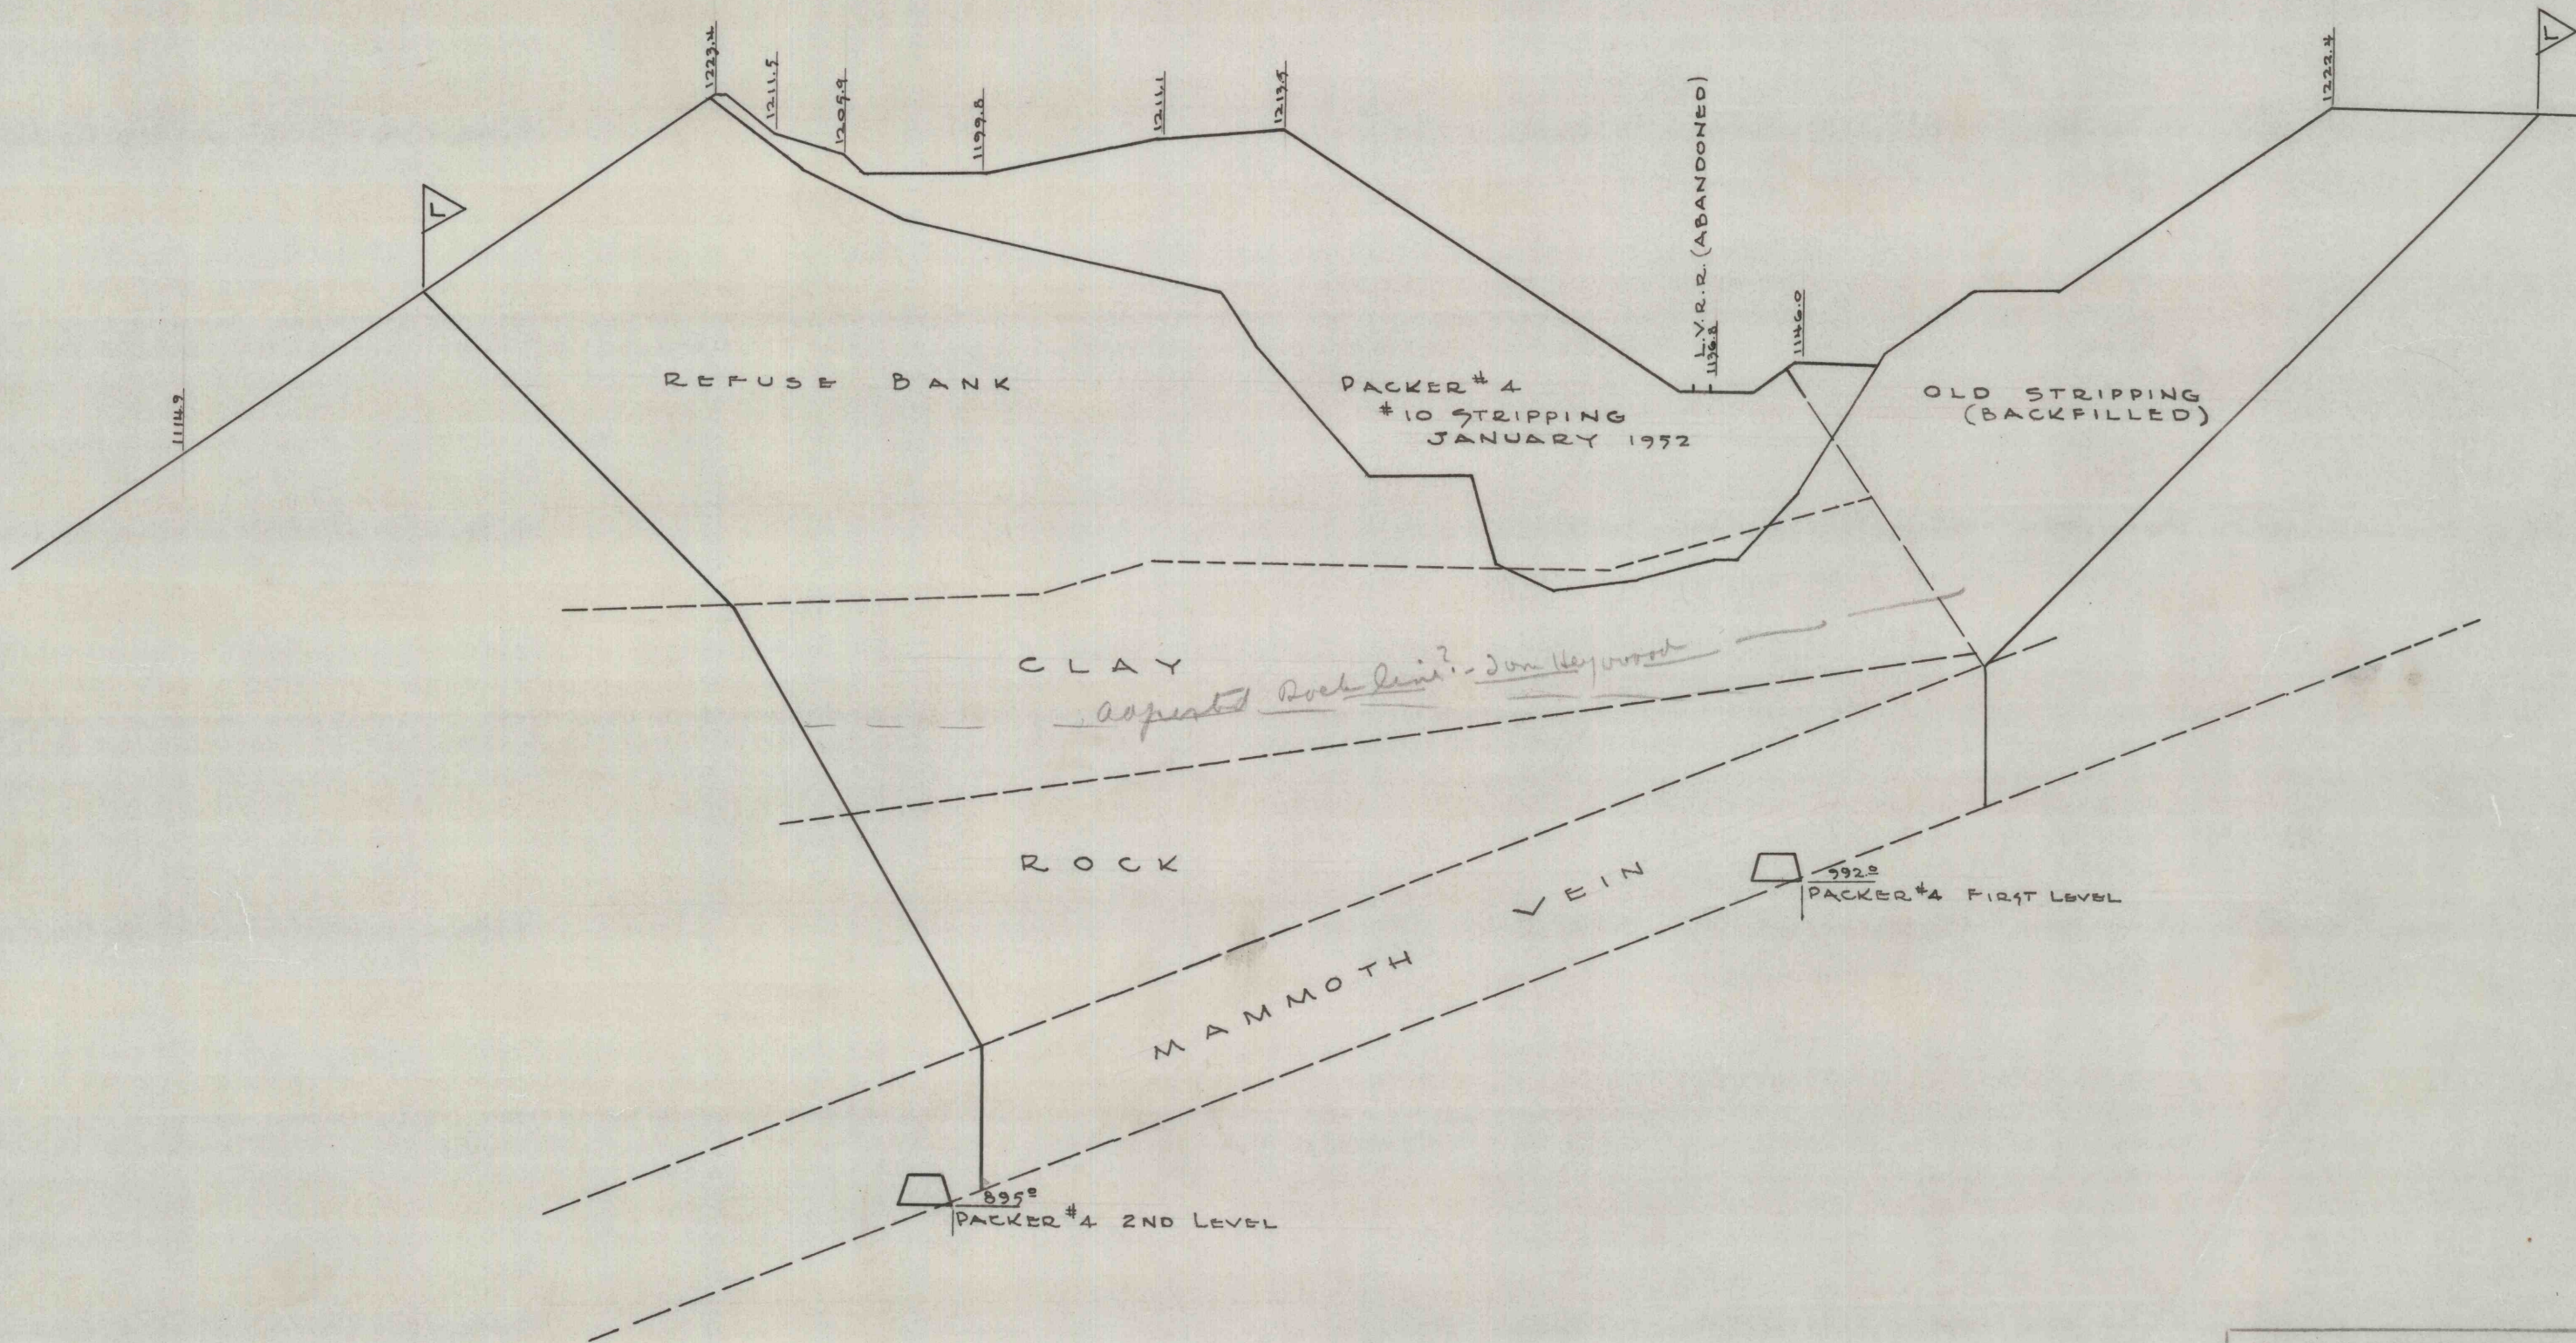

DATUM | 800.00



J. ROBERT BAZLEY, Inc.			
POTTSVILLE, PENNA.			
PACKER #10 STRIPPING			
PROPOSED WEST EXTENSION			
SECTION 7+00 W			
DATE	SCALE	BY	
6-30-52	1"=50'	C.V.M.	