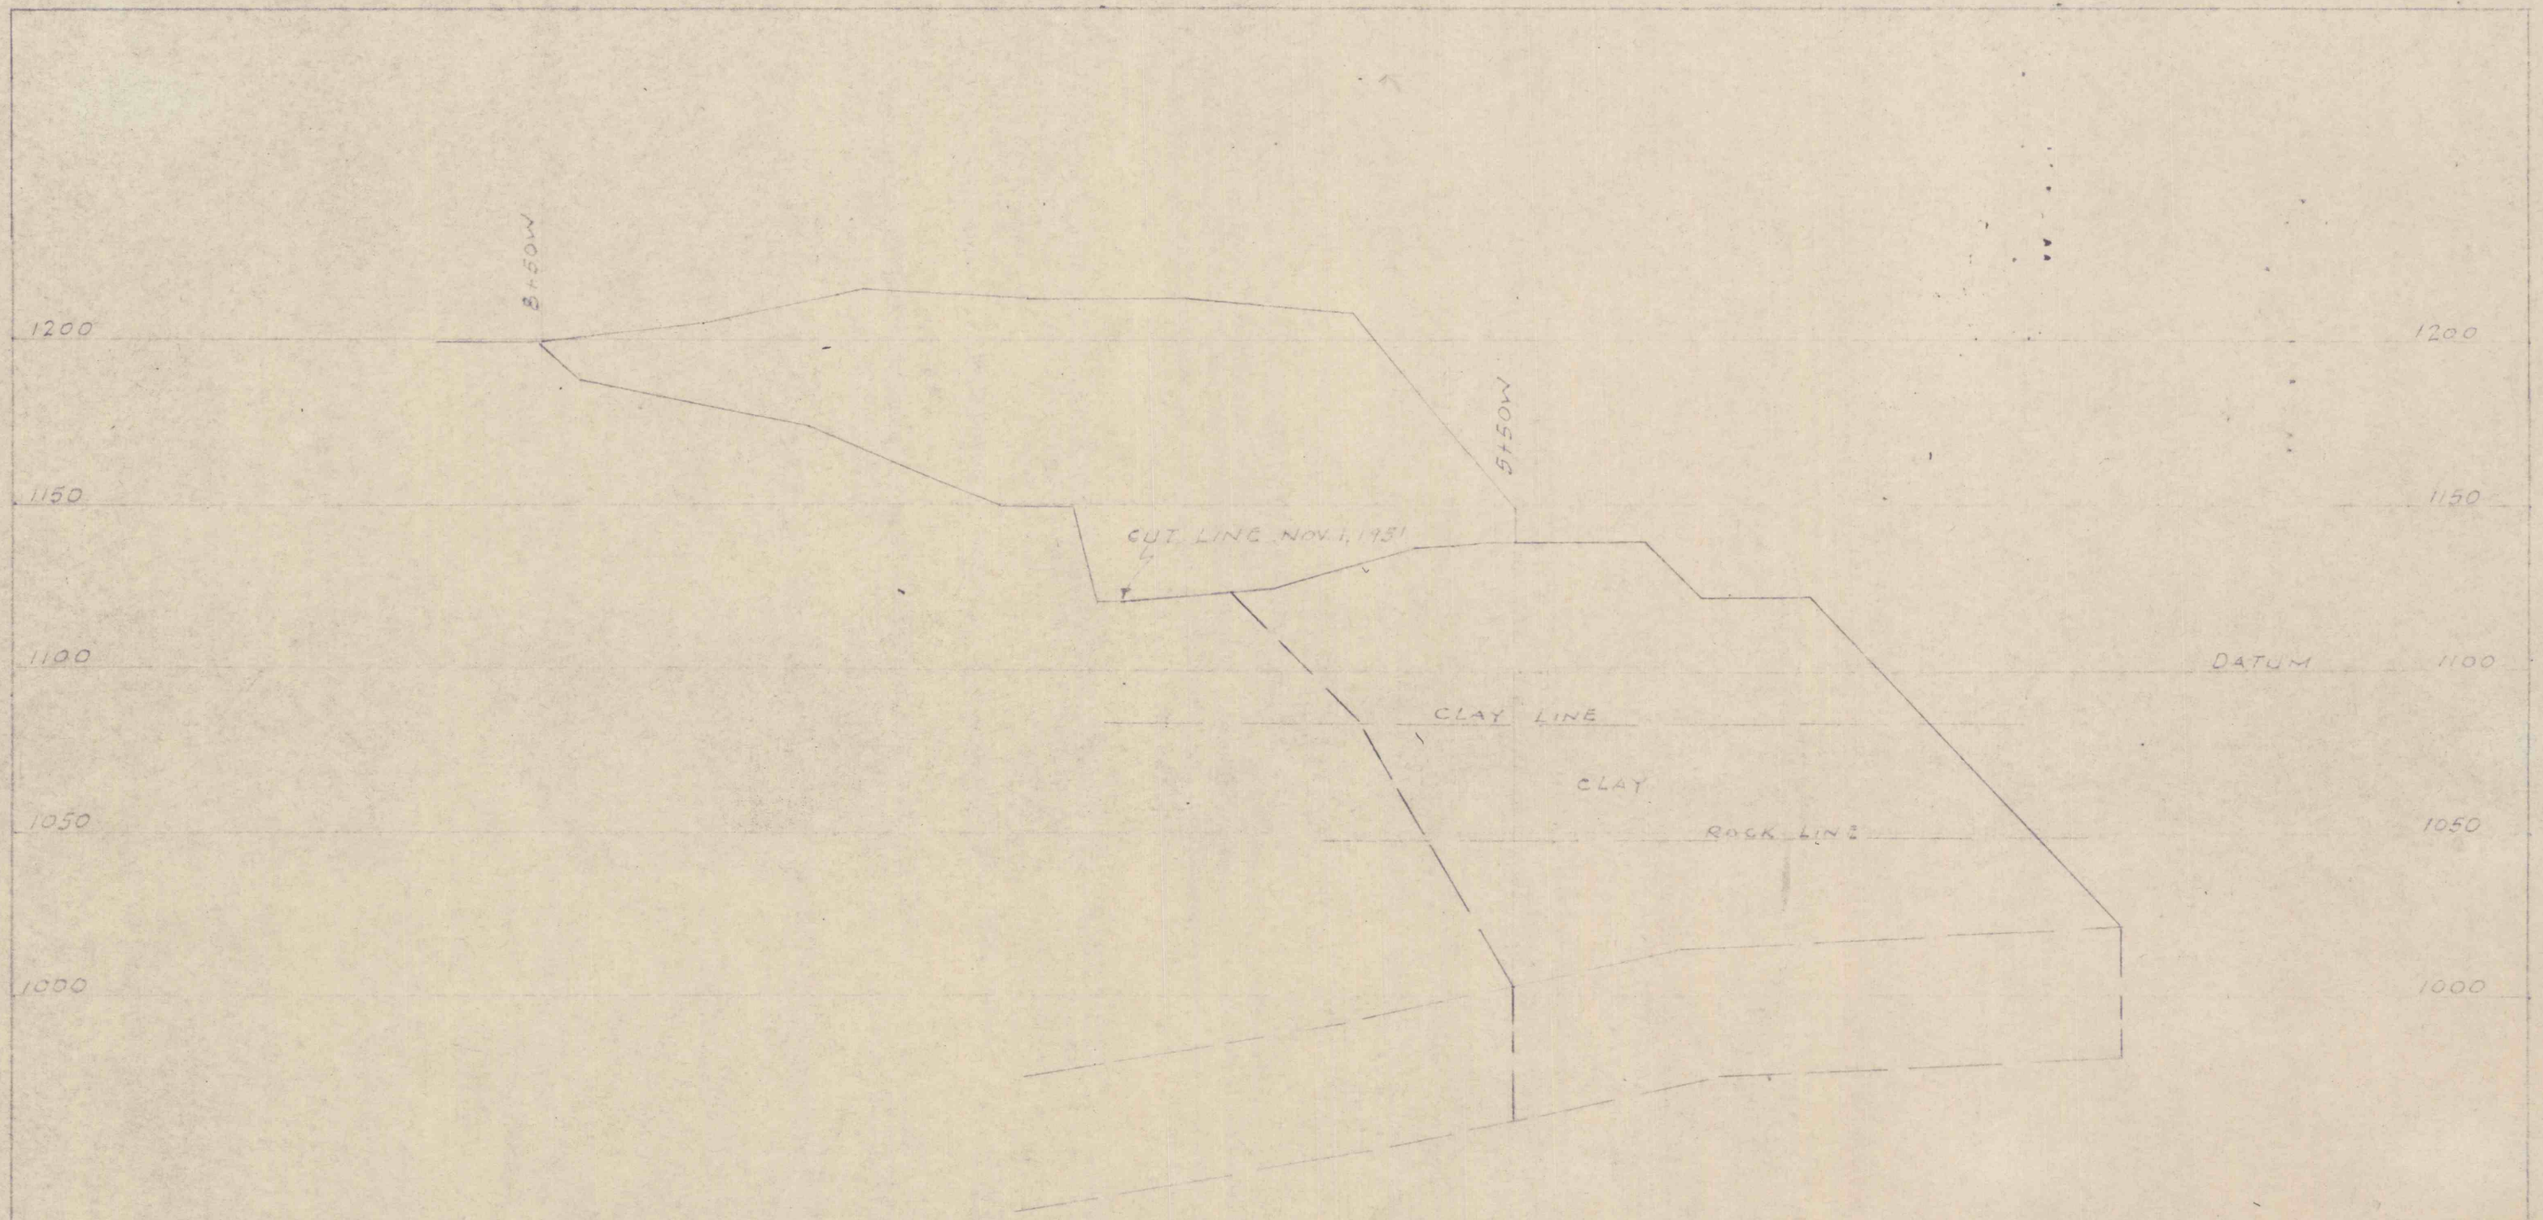

J. ROBERT BAZLEY, Inc.
POTTSVILLE, PENNA.

PACKER No. 10 STRIPPING
WEST EXTENSION
SECTION 1+50 SOUTH

DATE	SCALE	BY	
12-51	1"=50'		