


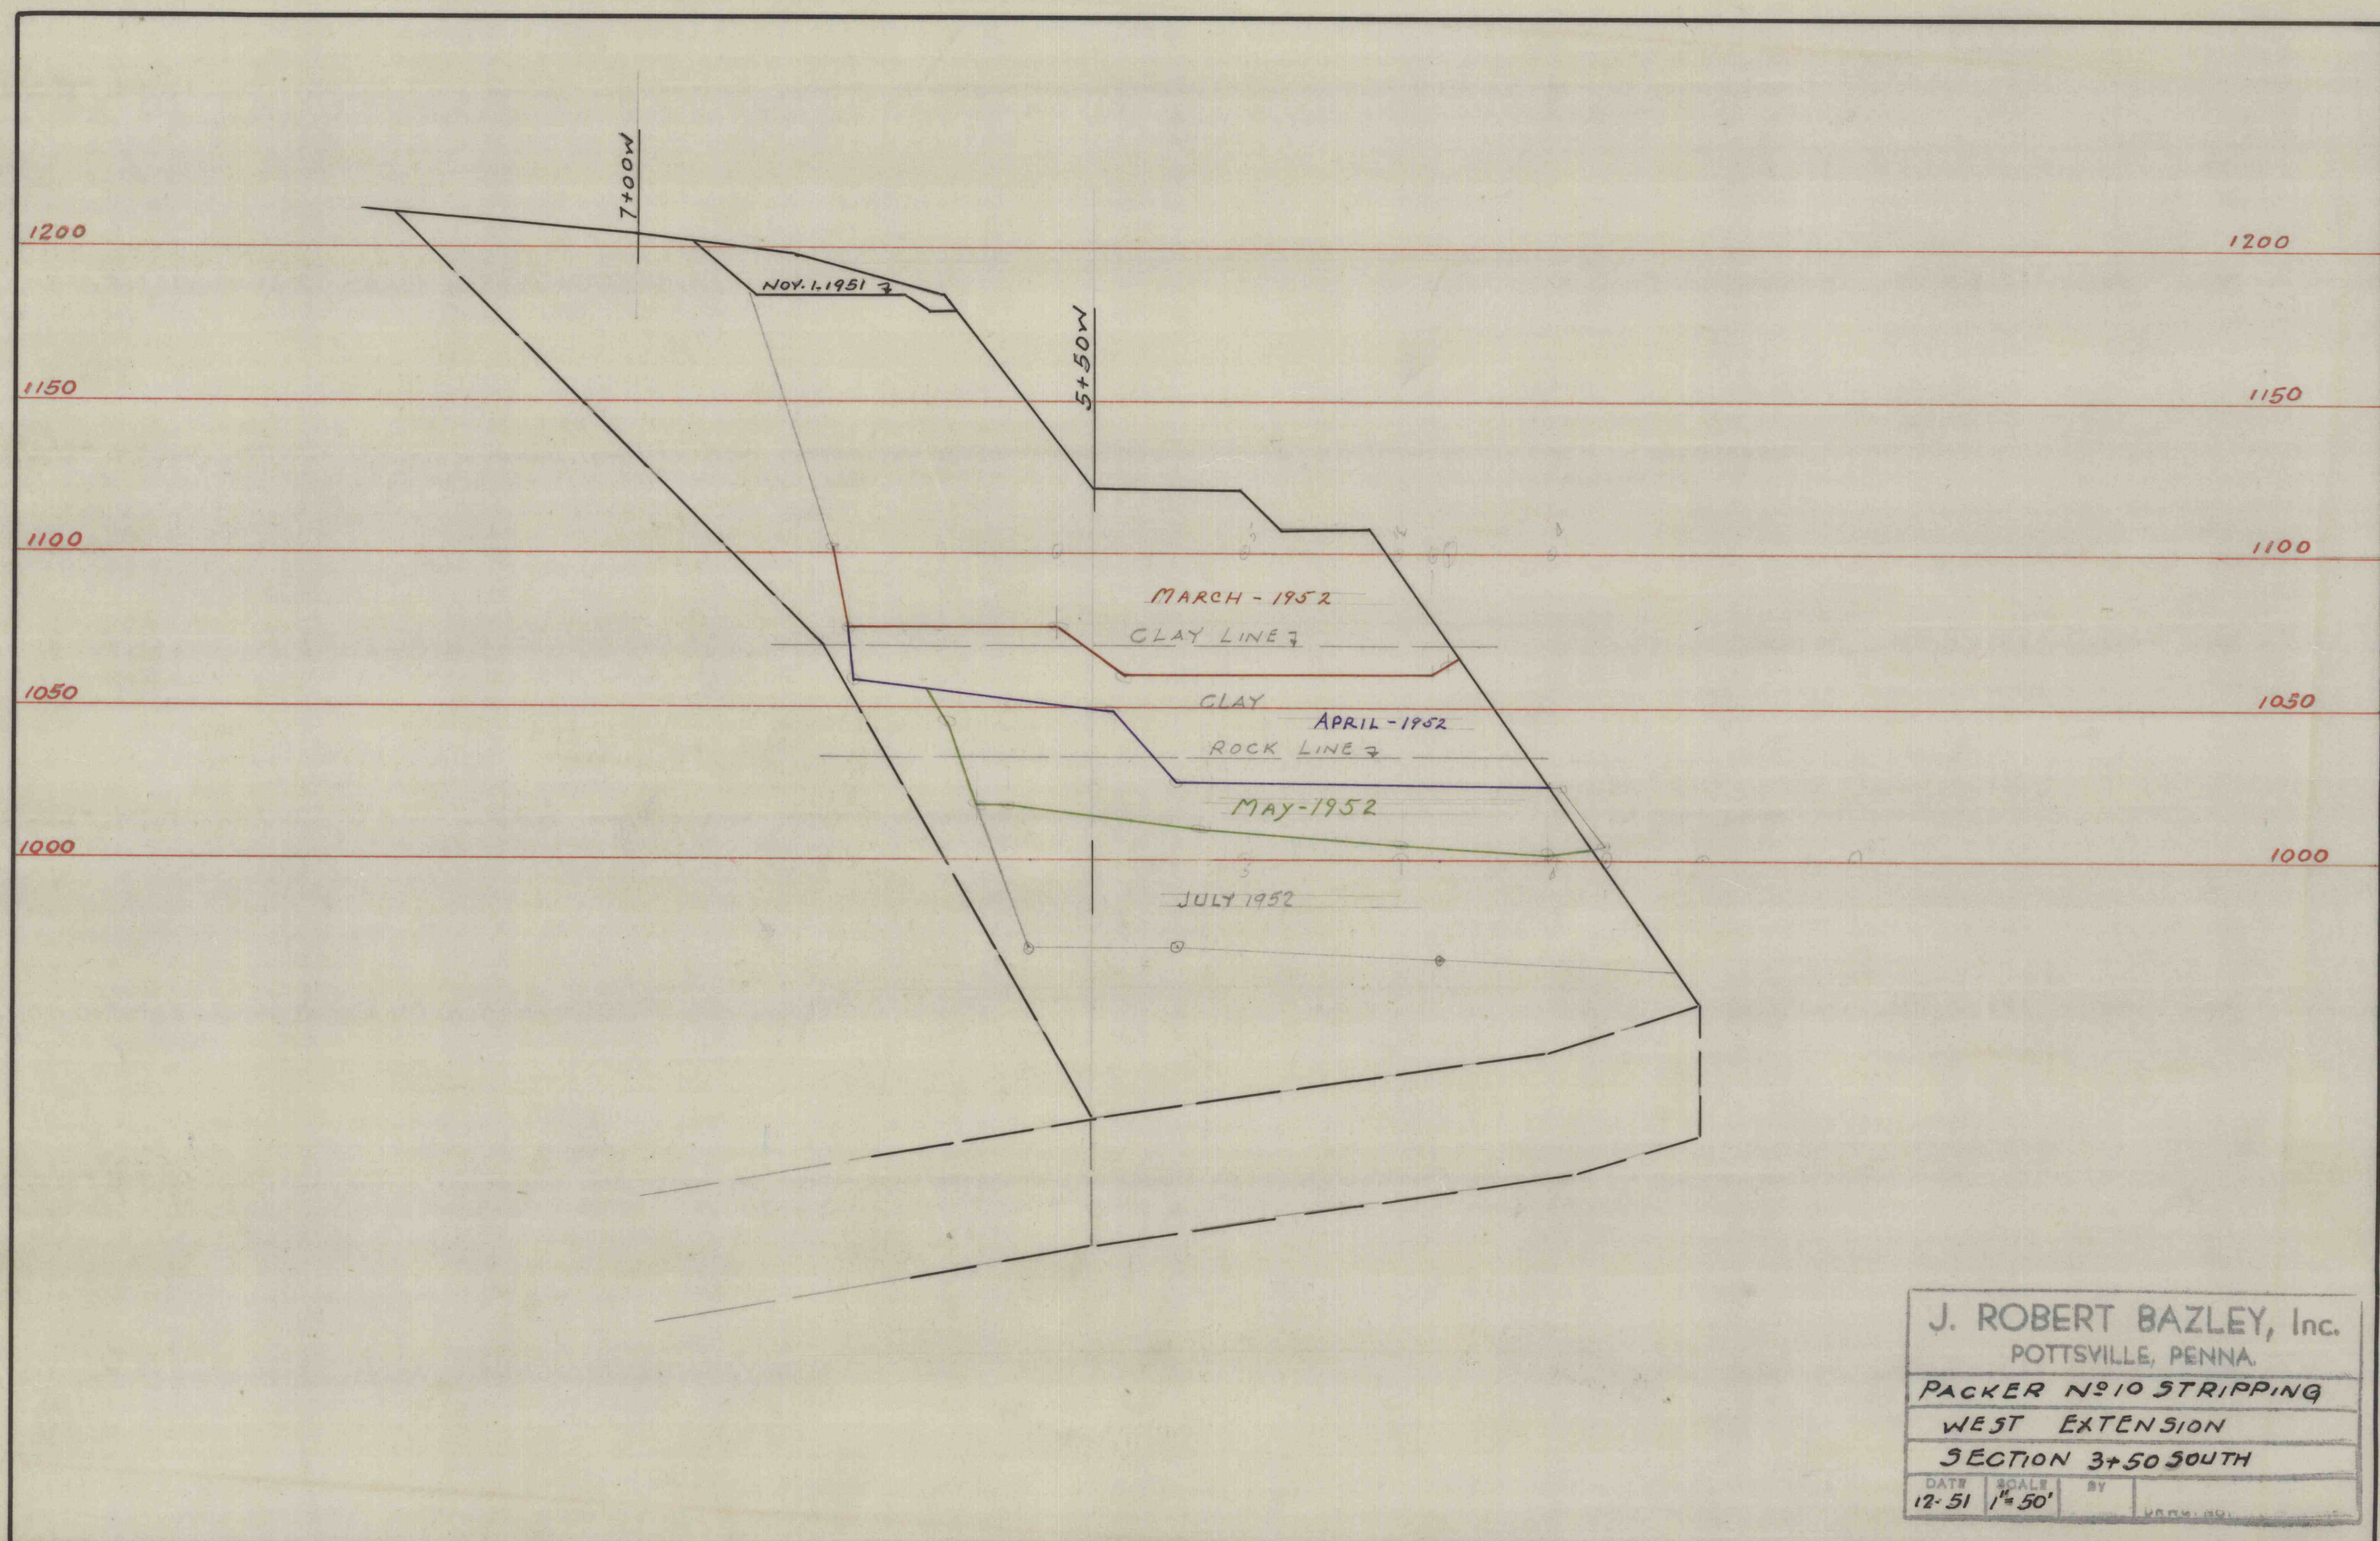

0031-MC-JAT