


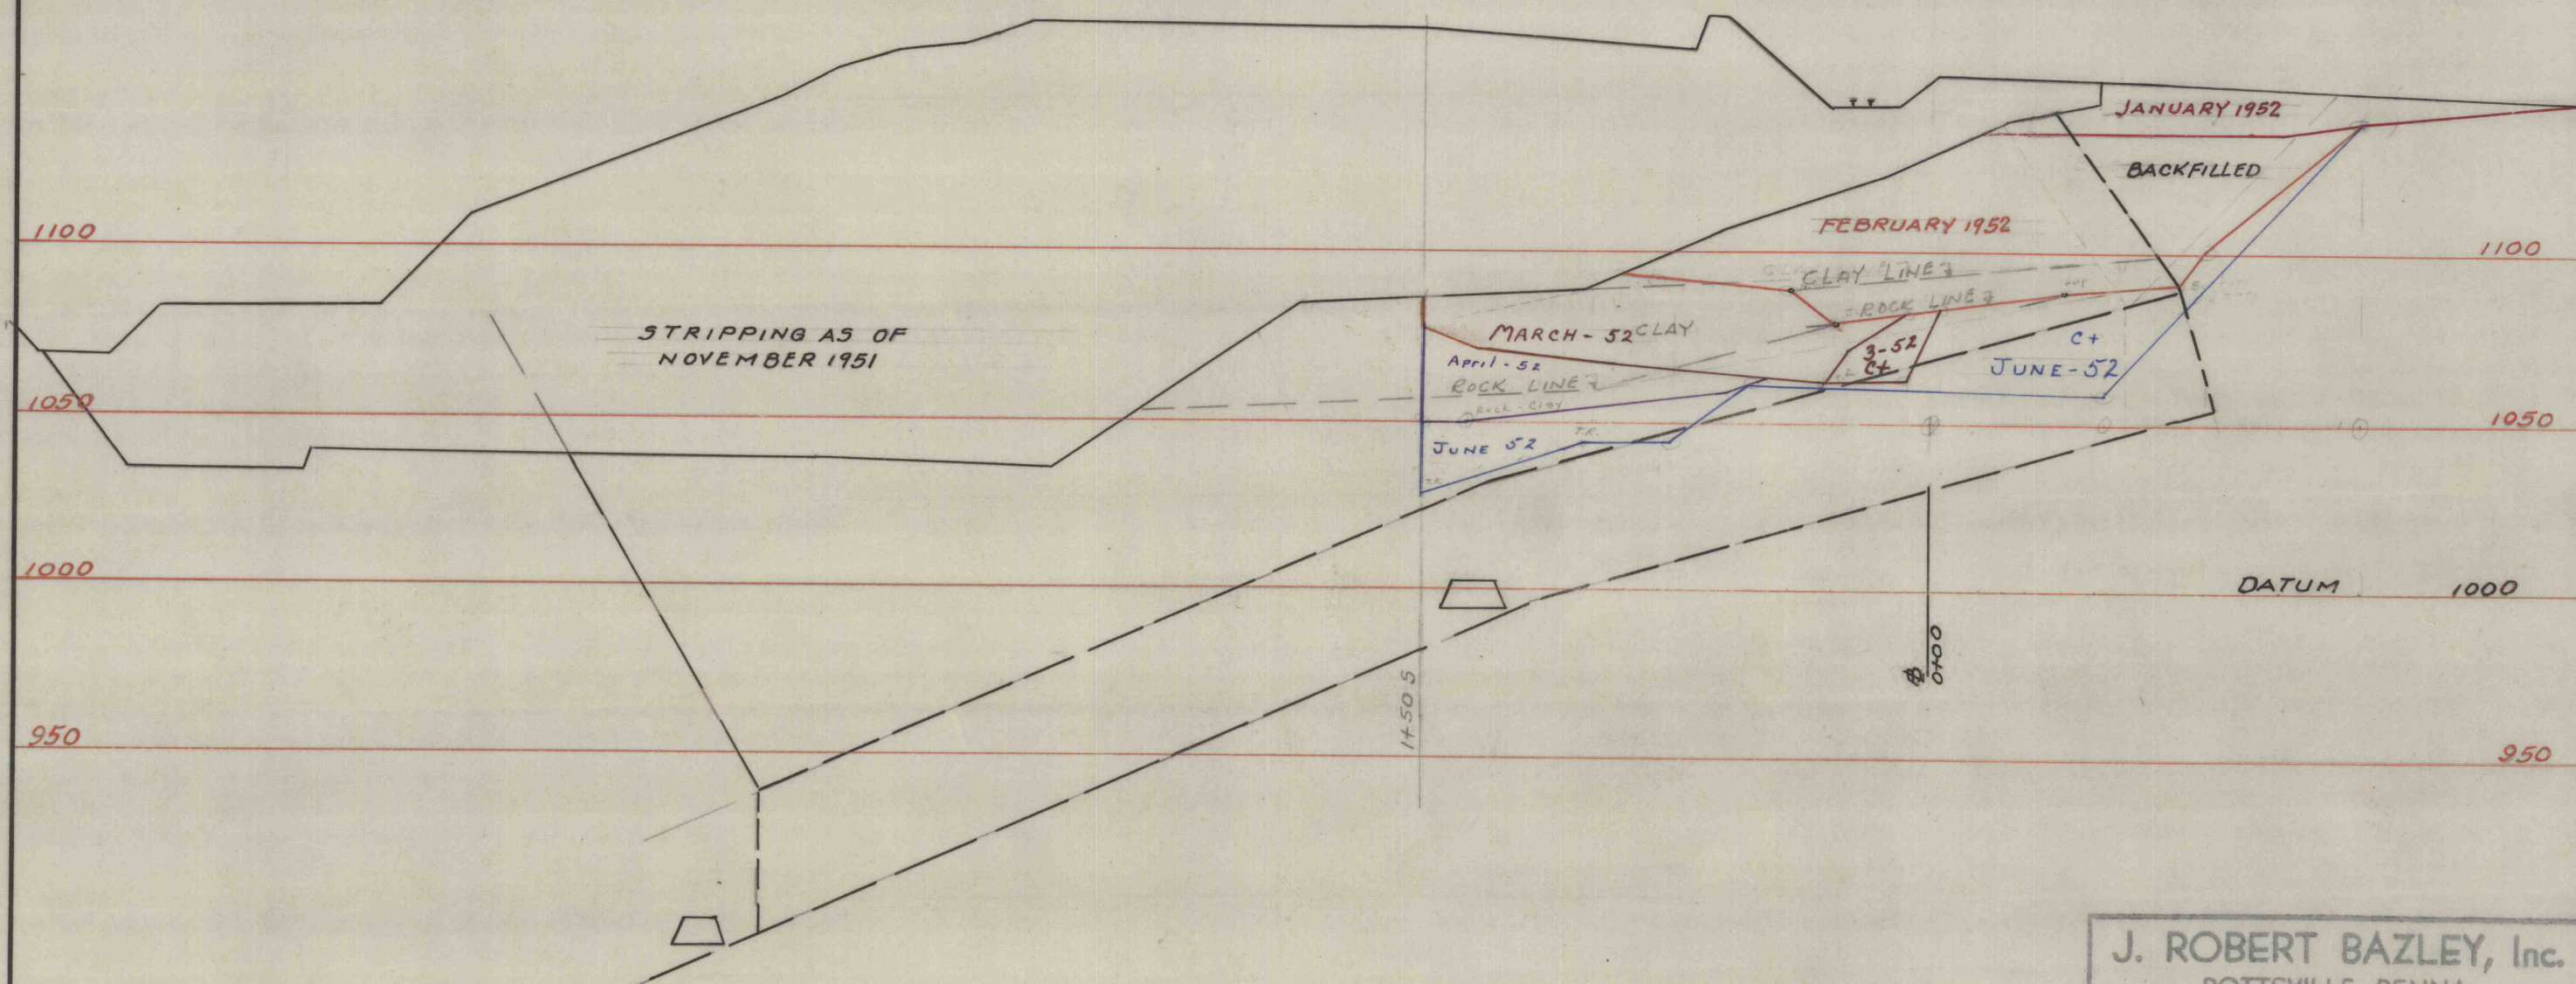

J. ROBERT BAZLEY, Inc.
 POTTSVILLE, PENNA.
 PACKER NO 10 STRIPPING
 WEST EXTENSION
 SECTION 4+00 WEST

DATE	SCALE	BY	CHECKED
12-51	1"=50'		