


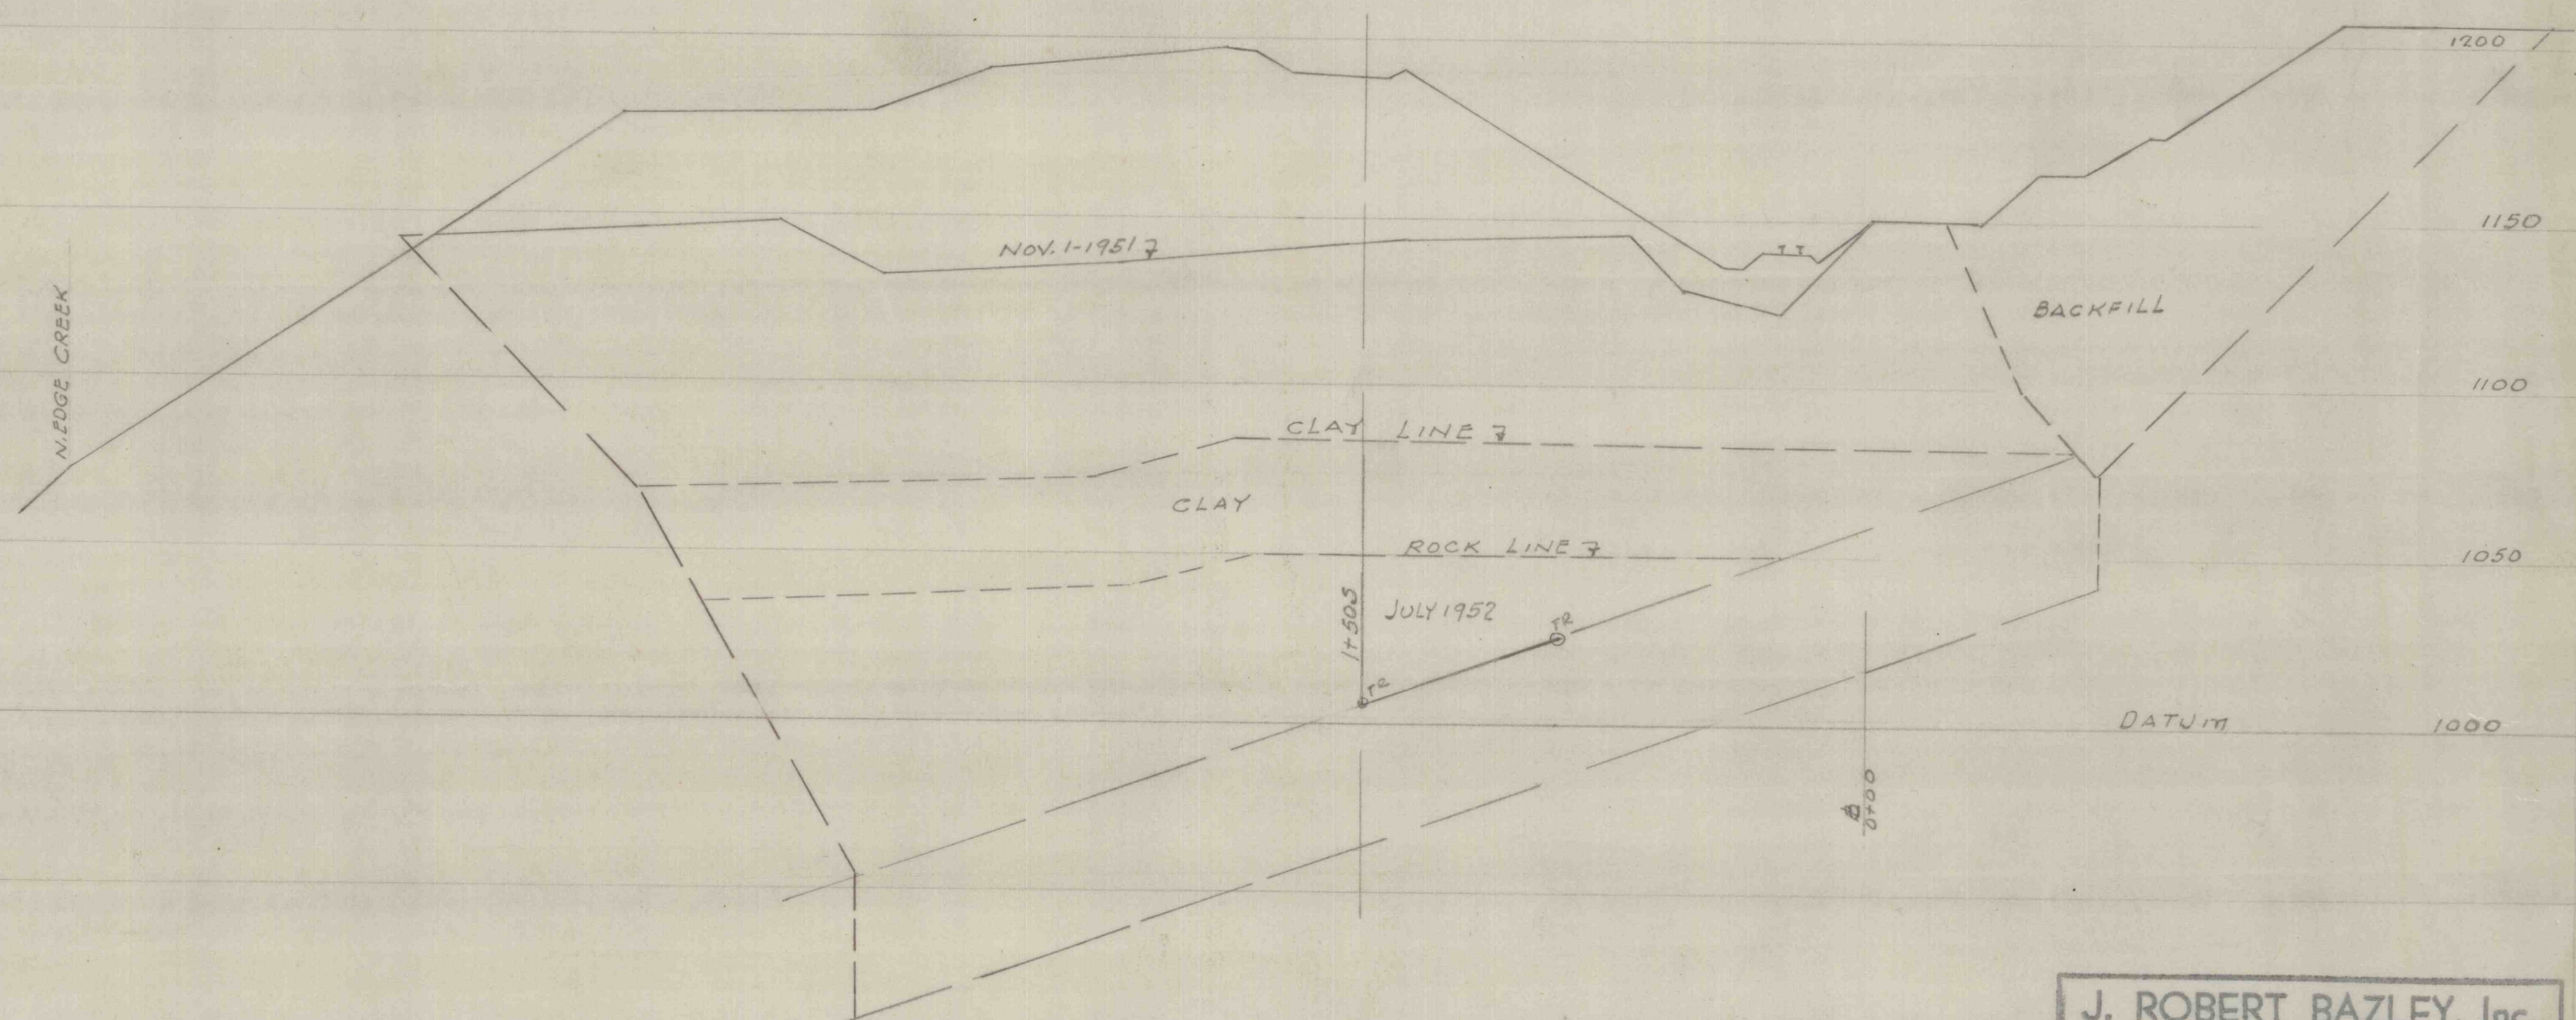

J. ROBERT BAZLEY, Inc.			
POTTSVILLE, PENNA.			
PACKER NO. 10 STRIPPING			
WEST EXTENSION			
SECT. 5+50 WEST			
DATE	SCALE	BY	DRG. NO.
12-51	1"=50'		