


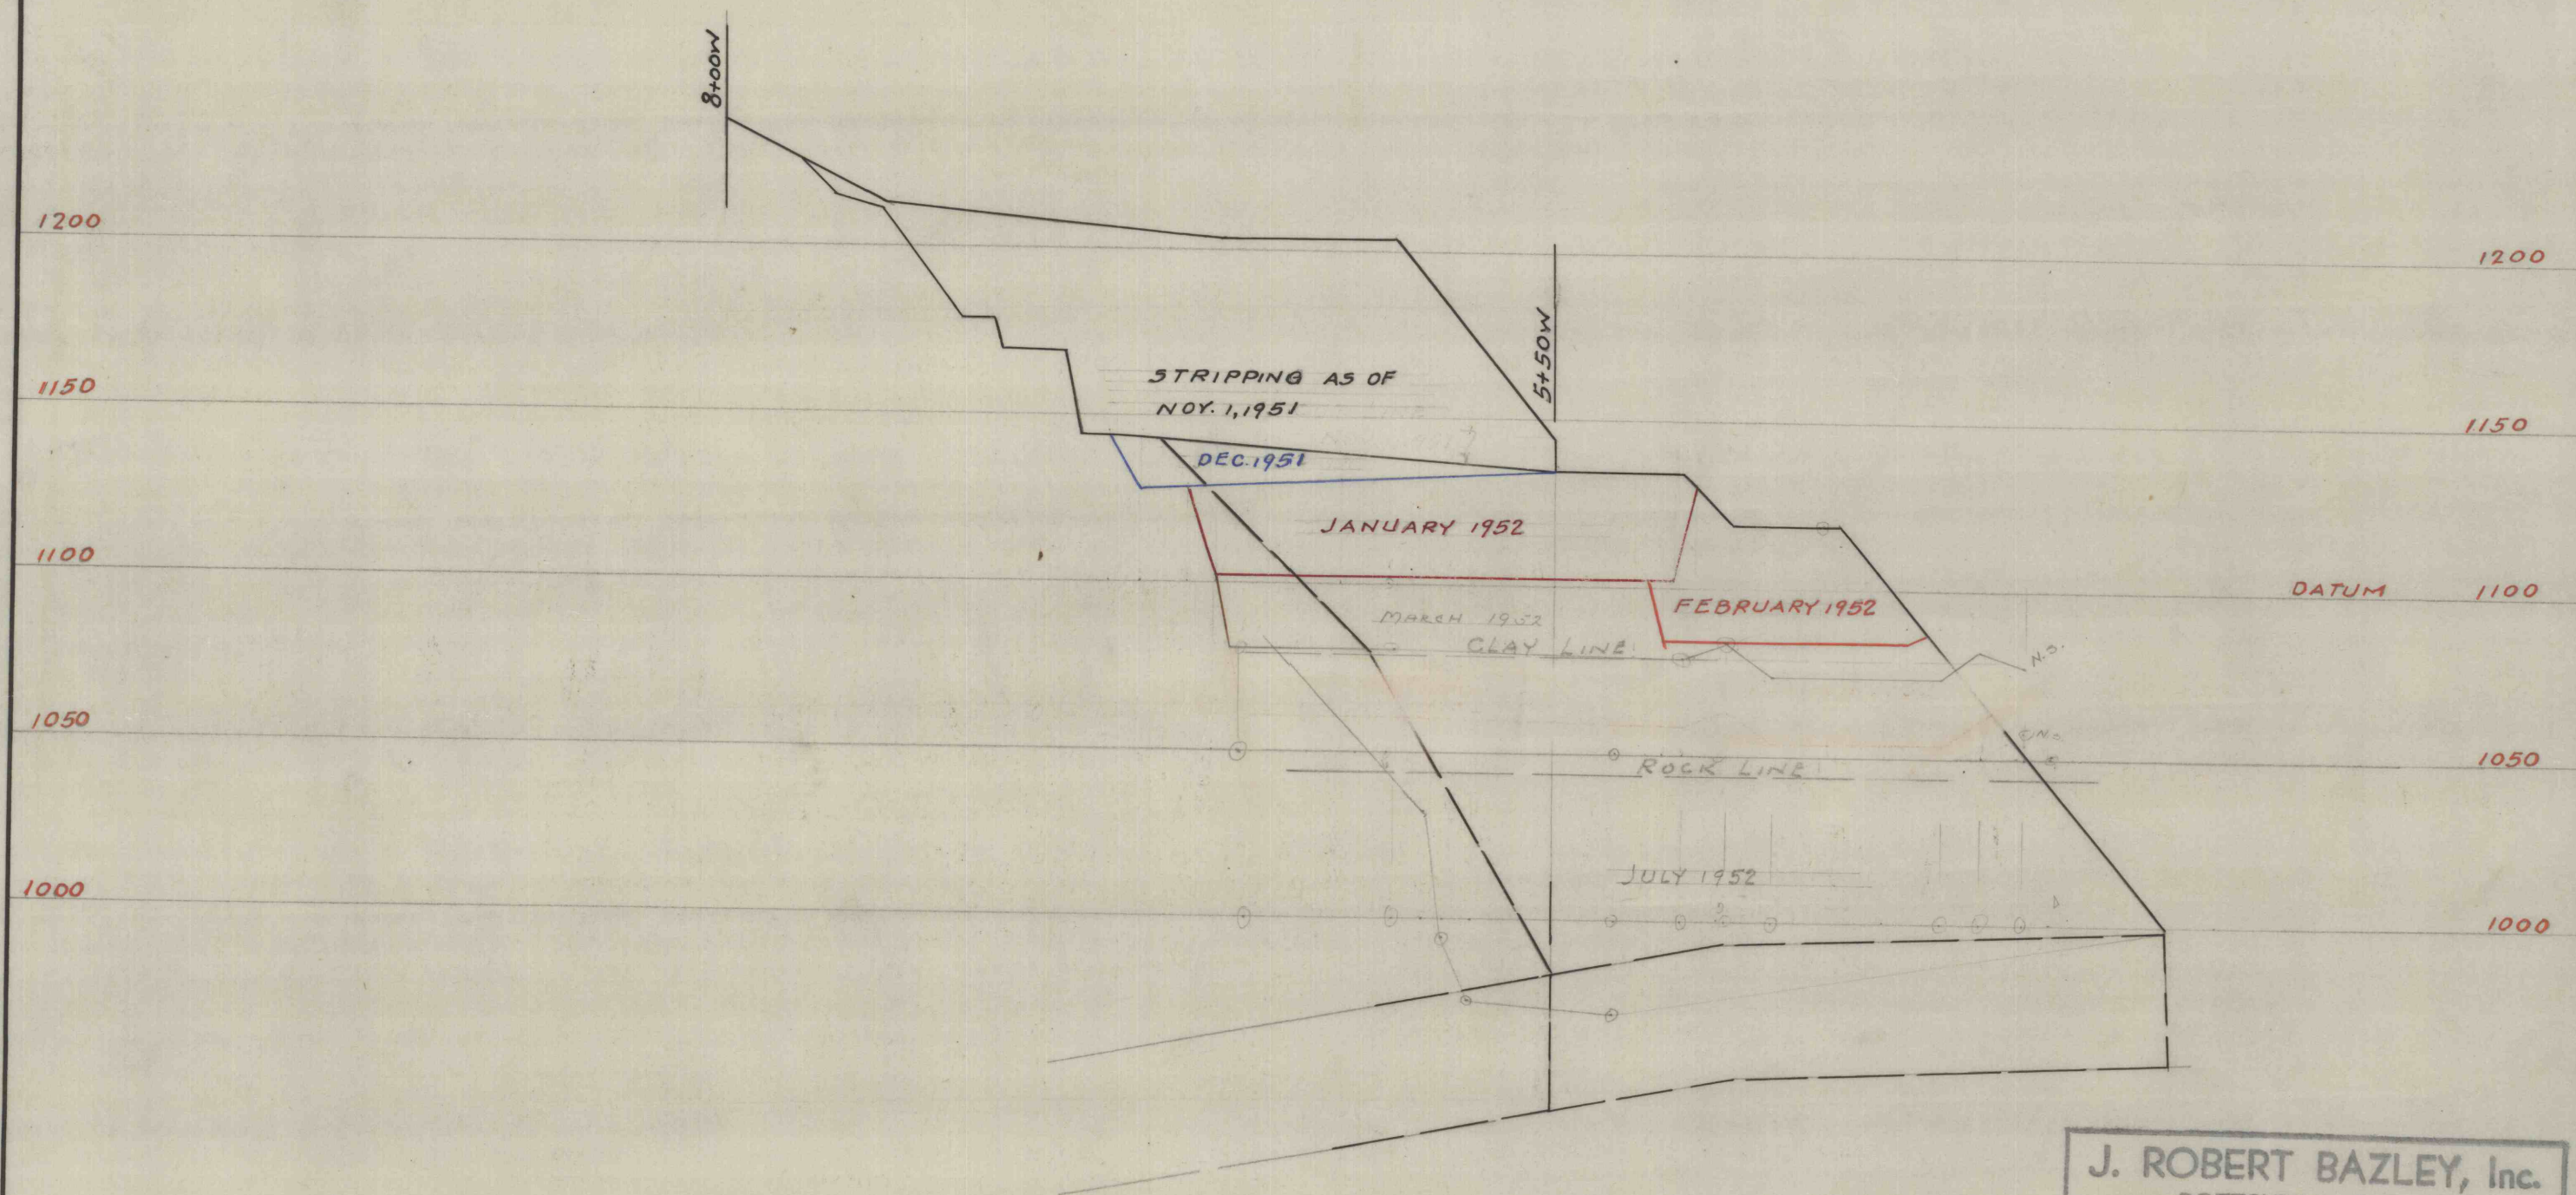

J. ROBERT BAZLEY, Inc.			
POTTSVILLE, PENNA.			
PACKER No 10 STRIPPING			
WEST EXTENSION			
SECTION 2+00 SOUTH			
DATE	SCALE	BY	REVIEWED
12-51	1"=50'	BT	W. H. W. G.